Newcastle.

Messrs Swan Hunter & Wig. Rich. Ltd.,

Q.S.S. No. 735.

Main Deck.

S.S. "Mauretania"

Normal Report

H.T. 53784

RETAIN

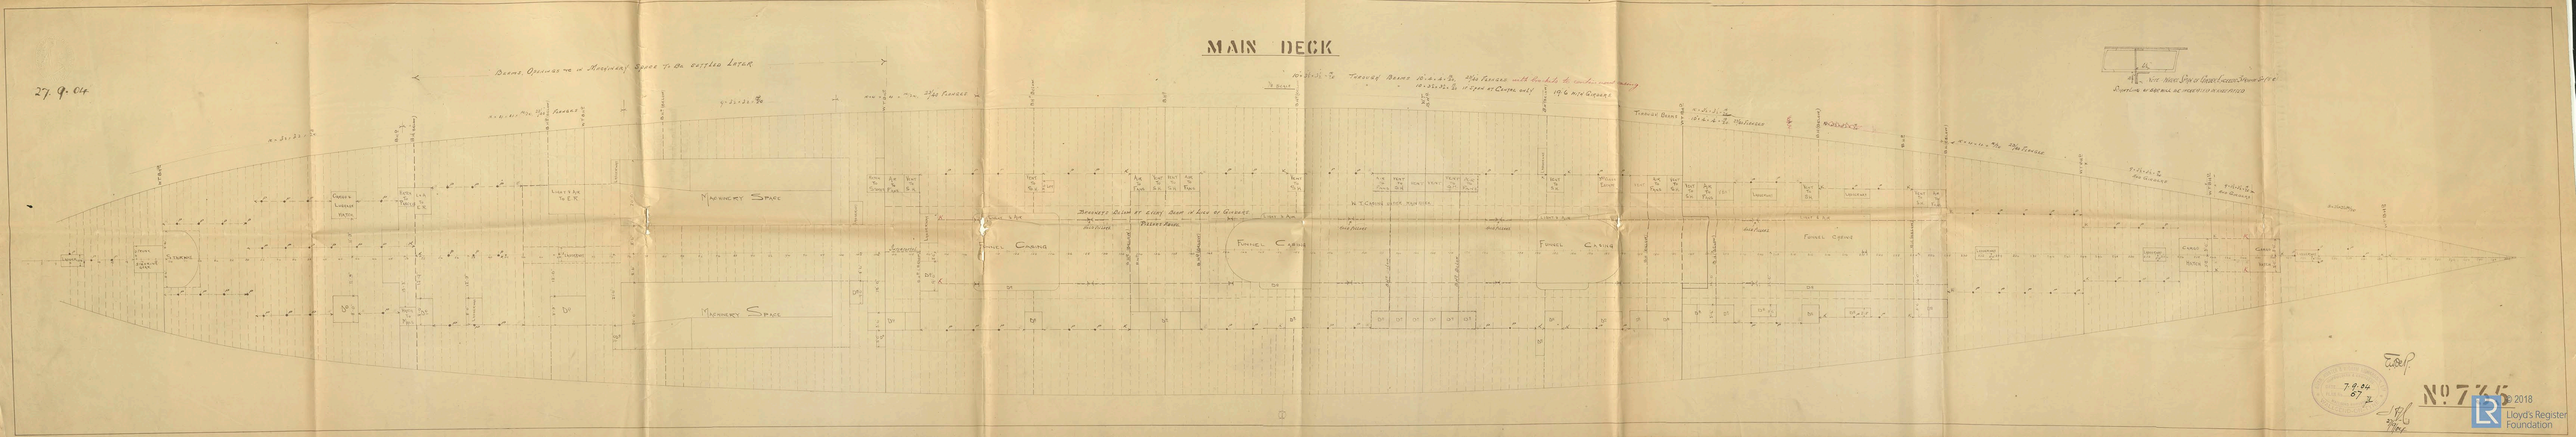
DESTROY

LR·FAF·SA26·0·1

© 2018 Lloyd's Register Foundation

# MAIN DECK

27. 9. 04


Machinery Space
Machinery Space
Funnel Casing
Funnel Casing
Funnel Casing
Funnel Casing
Engine Room Skylight
Engine Room Skylight
Engine Room Skylight




© 2018
Lloyd's Register
Foundation