

Hy. Robt. Rd.

Altho. ti res. 2 to Hatchways.

S/S. "Stekkin".



© 2018

Lloyd's Register
Foundation

— S. S. STETTIN —

SCALE $\frac{1}{2}'' = 1 \text{ FOOT}$




LONG. FCLE.
— N°2 221000 DK. HATCH —

STEEL DK
IN WAY
OF HATCH

NOTE

12" x 5"
3" WOOD DR.
3" x 4" x 1/2"

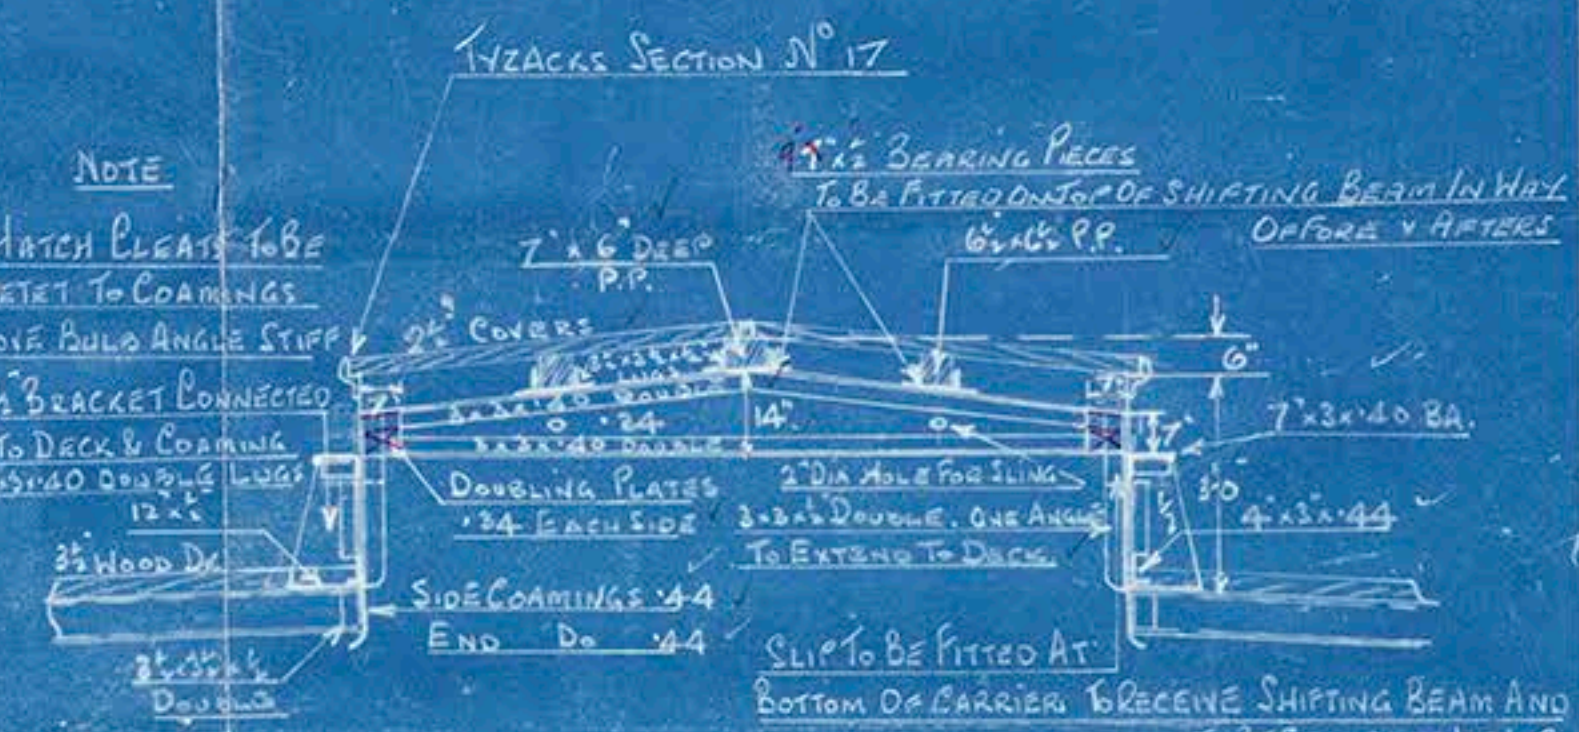

— SECTION IN WAY OF N°3 UPPER DK
— AND N°2 BRIDGE DK HATCHES.


— N° 2 UPPER DECK HATCH —

SECTION IN WAY OF NO. 2 UPPER D^K
HATCH.