


Sew. Stm. "Charles Howard" Rev. Rept No. 20216

PROPOSED ARRANGEMENT OF TANKS.

S.S. "CHARLES HOWARD."

25/10/86
25/3/84

28/10/86
18.3.87
31.3.87

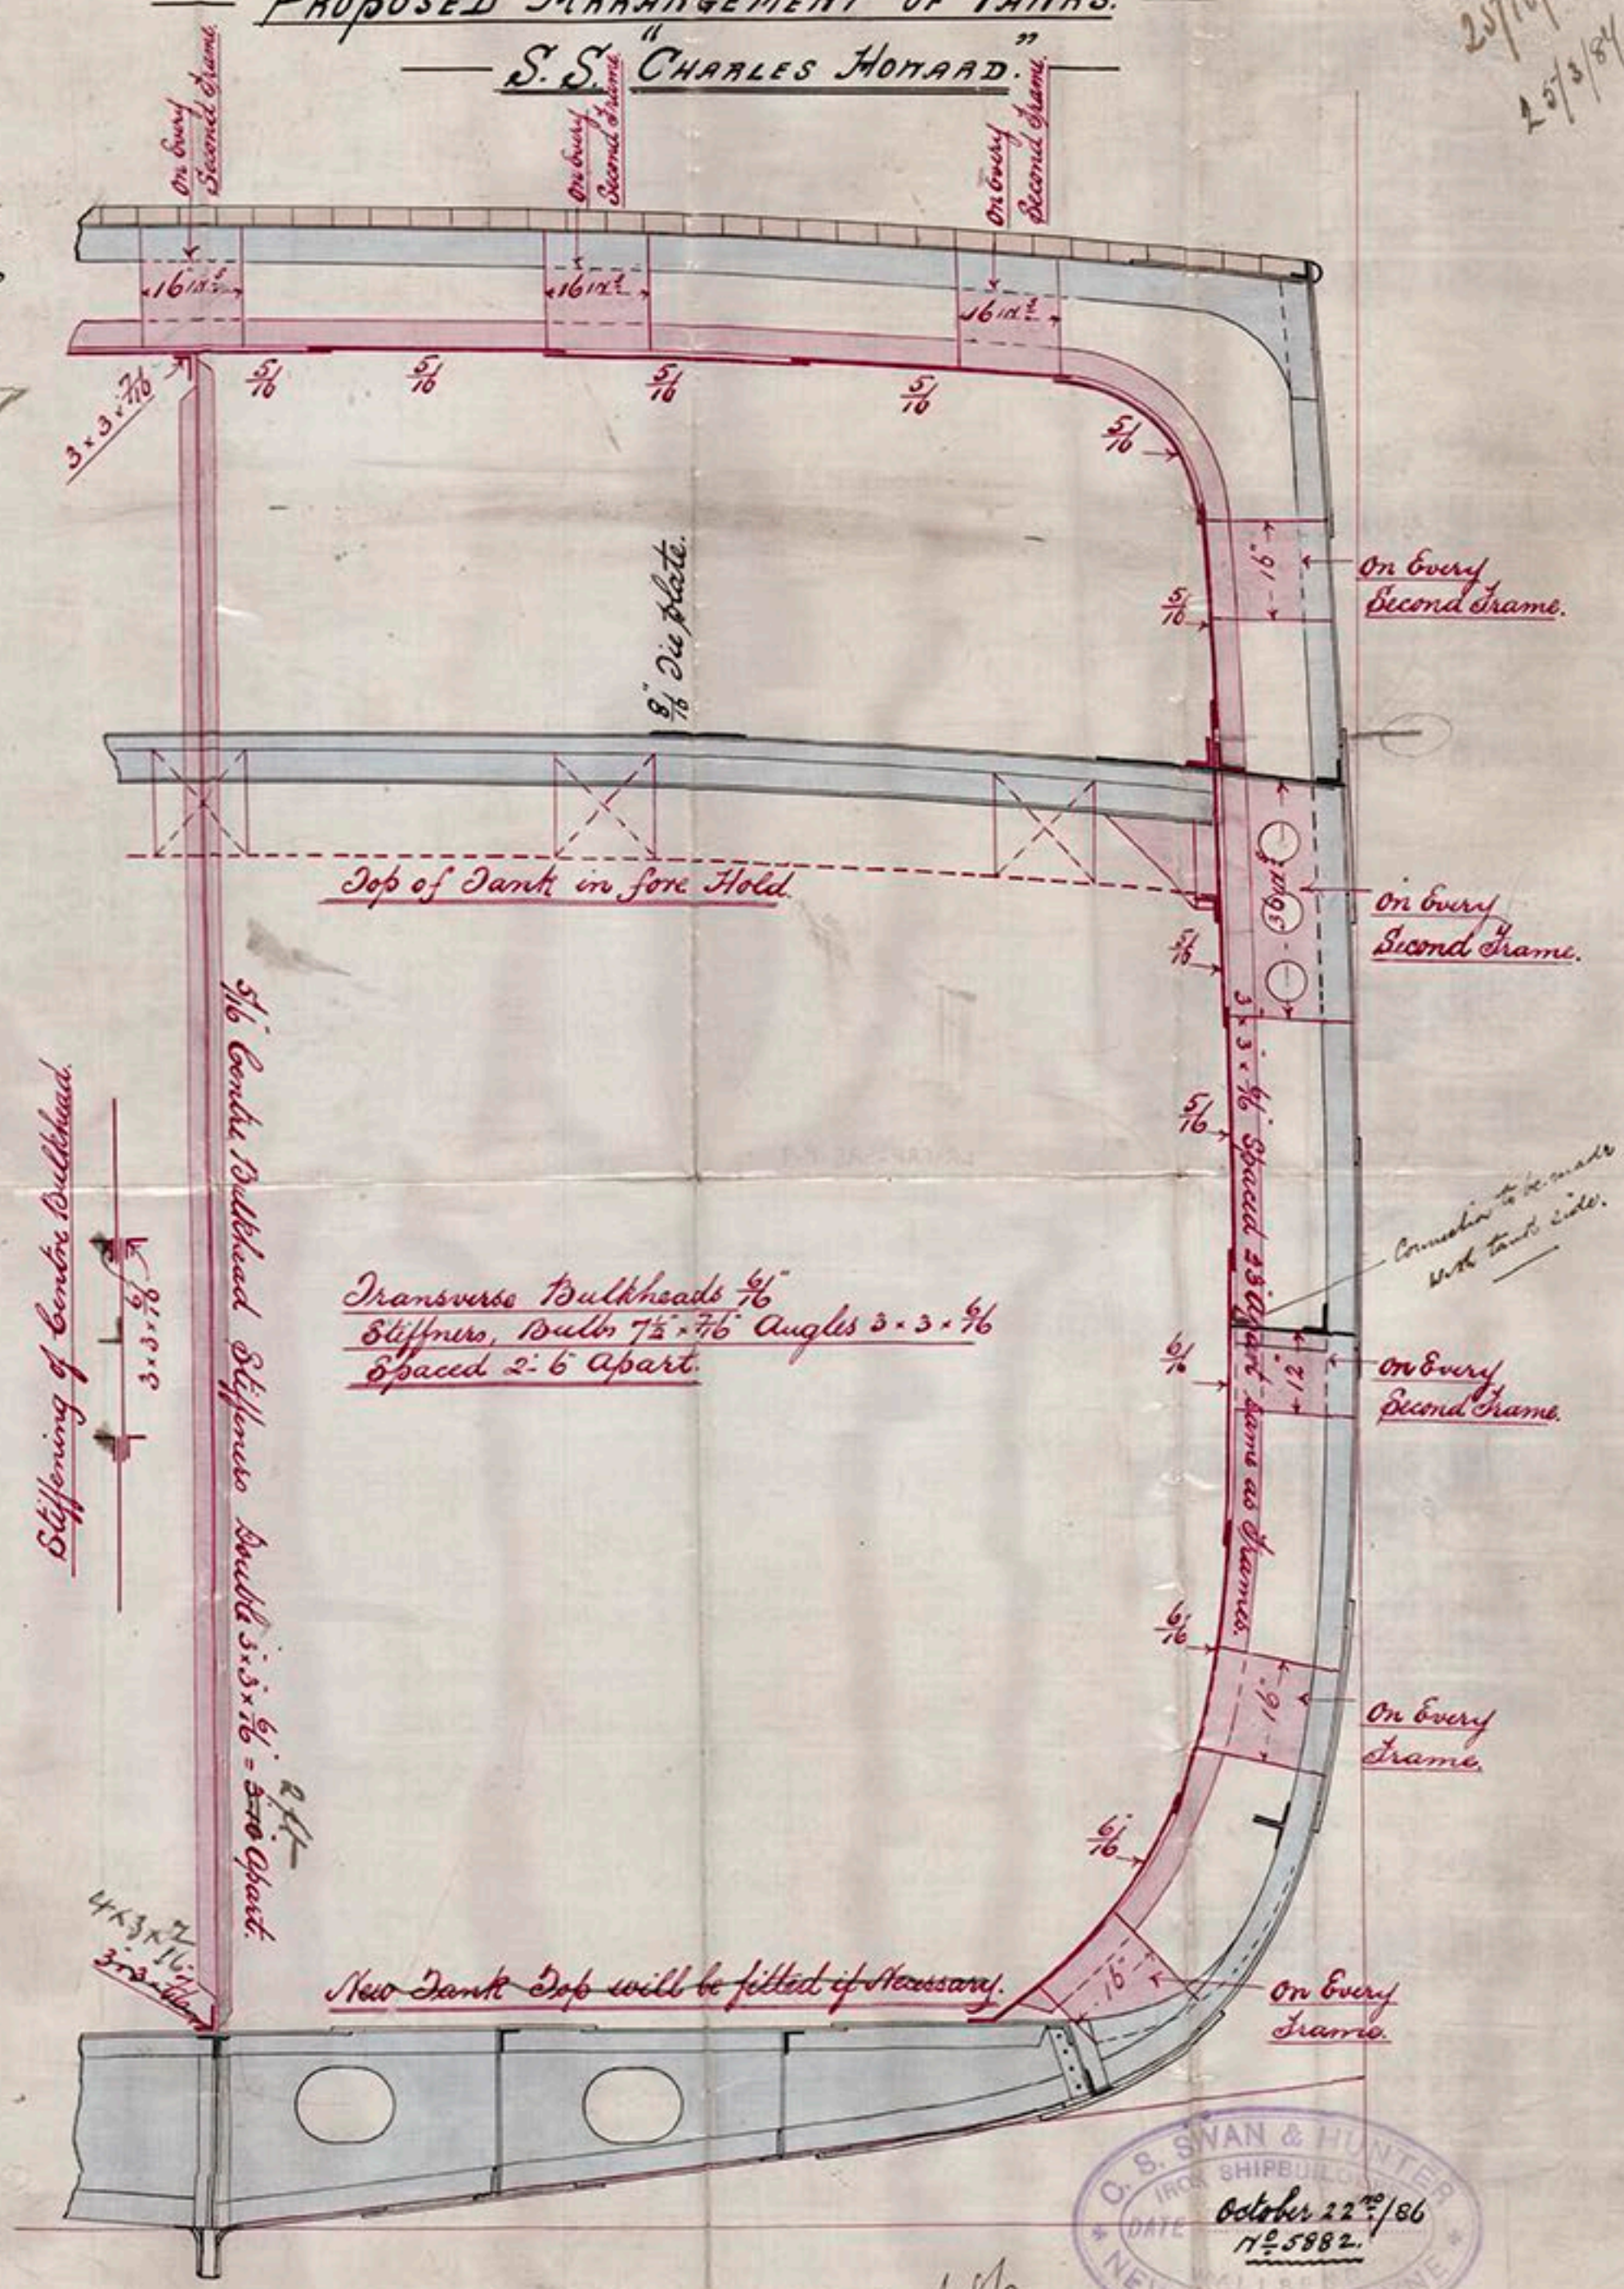

O. S. SWAN & HUNTER
IRON SHIPBUILDERS
NEWCASTLE-ON-TYNE
October 22nd /86
1705882

27/10/86
24.2.87