

Sew. ex. "Charles Howard". Rec. Repat No 20216



Boiler Shown in Blue

Hold Bunkers Shown in Red
Tween OK Bunkers Shown in Black

Bunkers for carrying liquid fuel
built in accordance ^{with} this sketch
5/16 plates stiffened by
angles 3 x 2 3/4 x 5/16
Spaced 2'-6" apart.

5/16 plates stiffened by
angles $3 \times 2\frac{3}{4} \times 5/16$

Spaced 2' 6" apart.

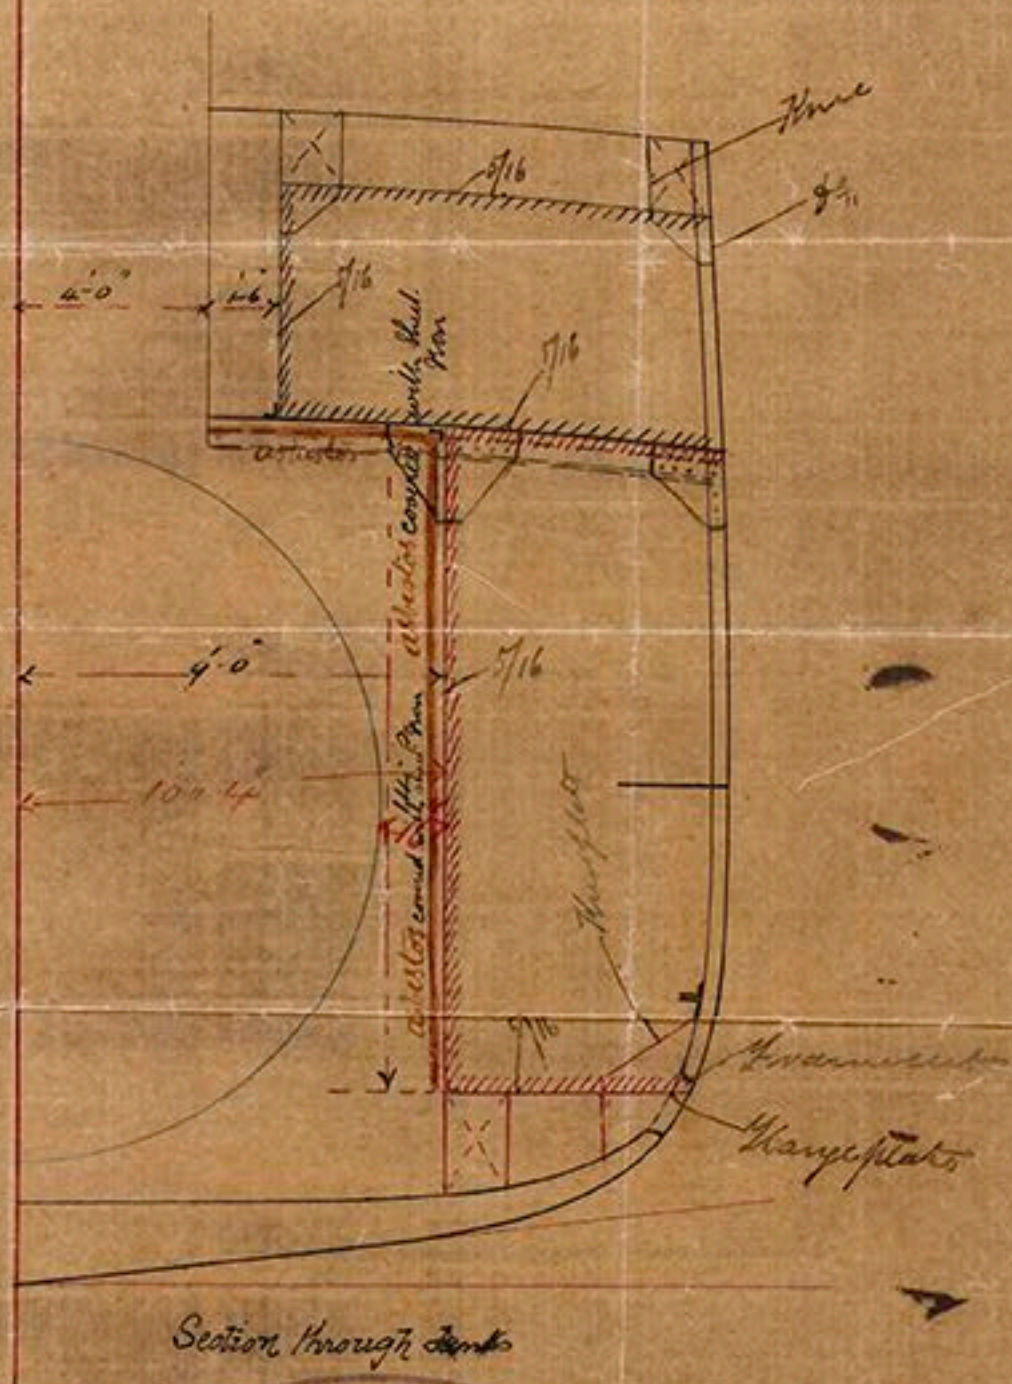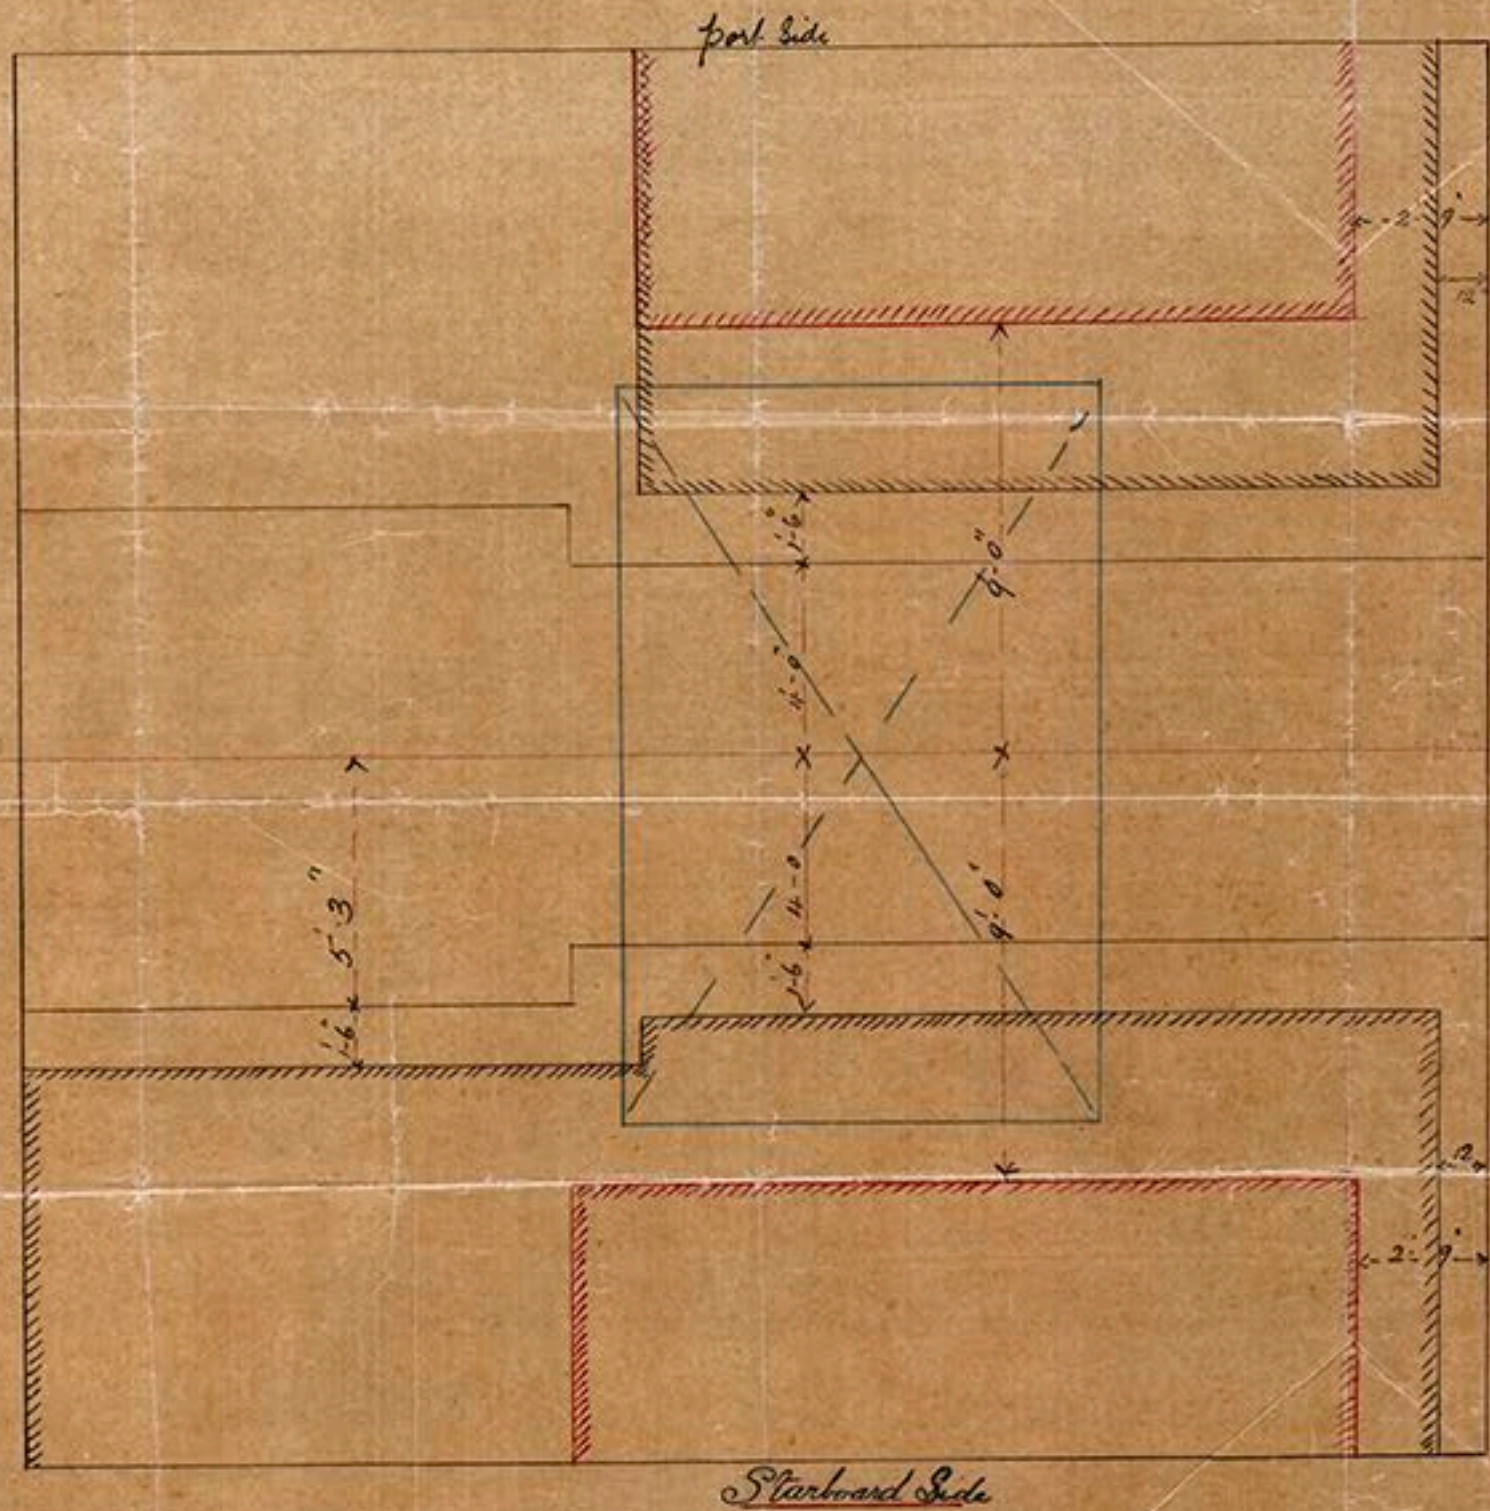


See vs. & Hiss

18/3/57. V 31.3.57.

Arrangement of Bunkers for Carrying
Liquid Fuel
S. S. Charles Howard

S. S. Charles Howard

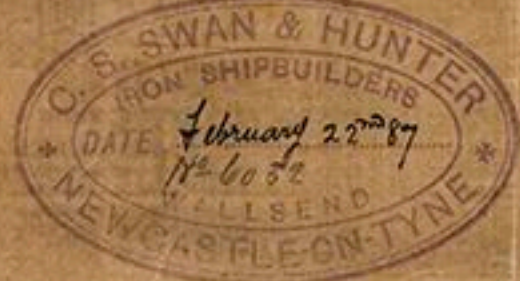

144/2-184
3-54 © 2018