

MIDSHIP SECTION

OF

NEW SHIP No 55. "Hermaphrodite"

LENGTH BETWEEN PERPENDICULARS 210 ft

BREADTH EXTREME 36 ft

DEPTH IN HOLD 21 ft


TONNAGE REGISTER Under Deck 917.

SCALE 1/2 INCH TO A FOOT

Plan 17/1/69

Diagonal
Line
1/2

25/11/69

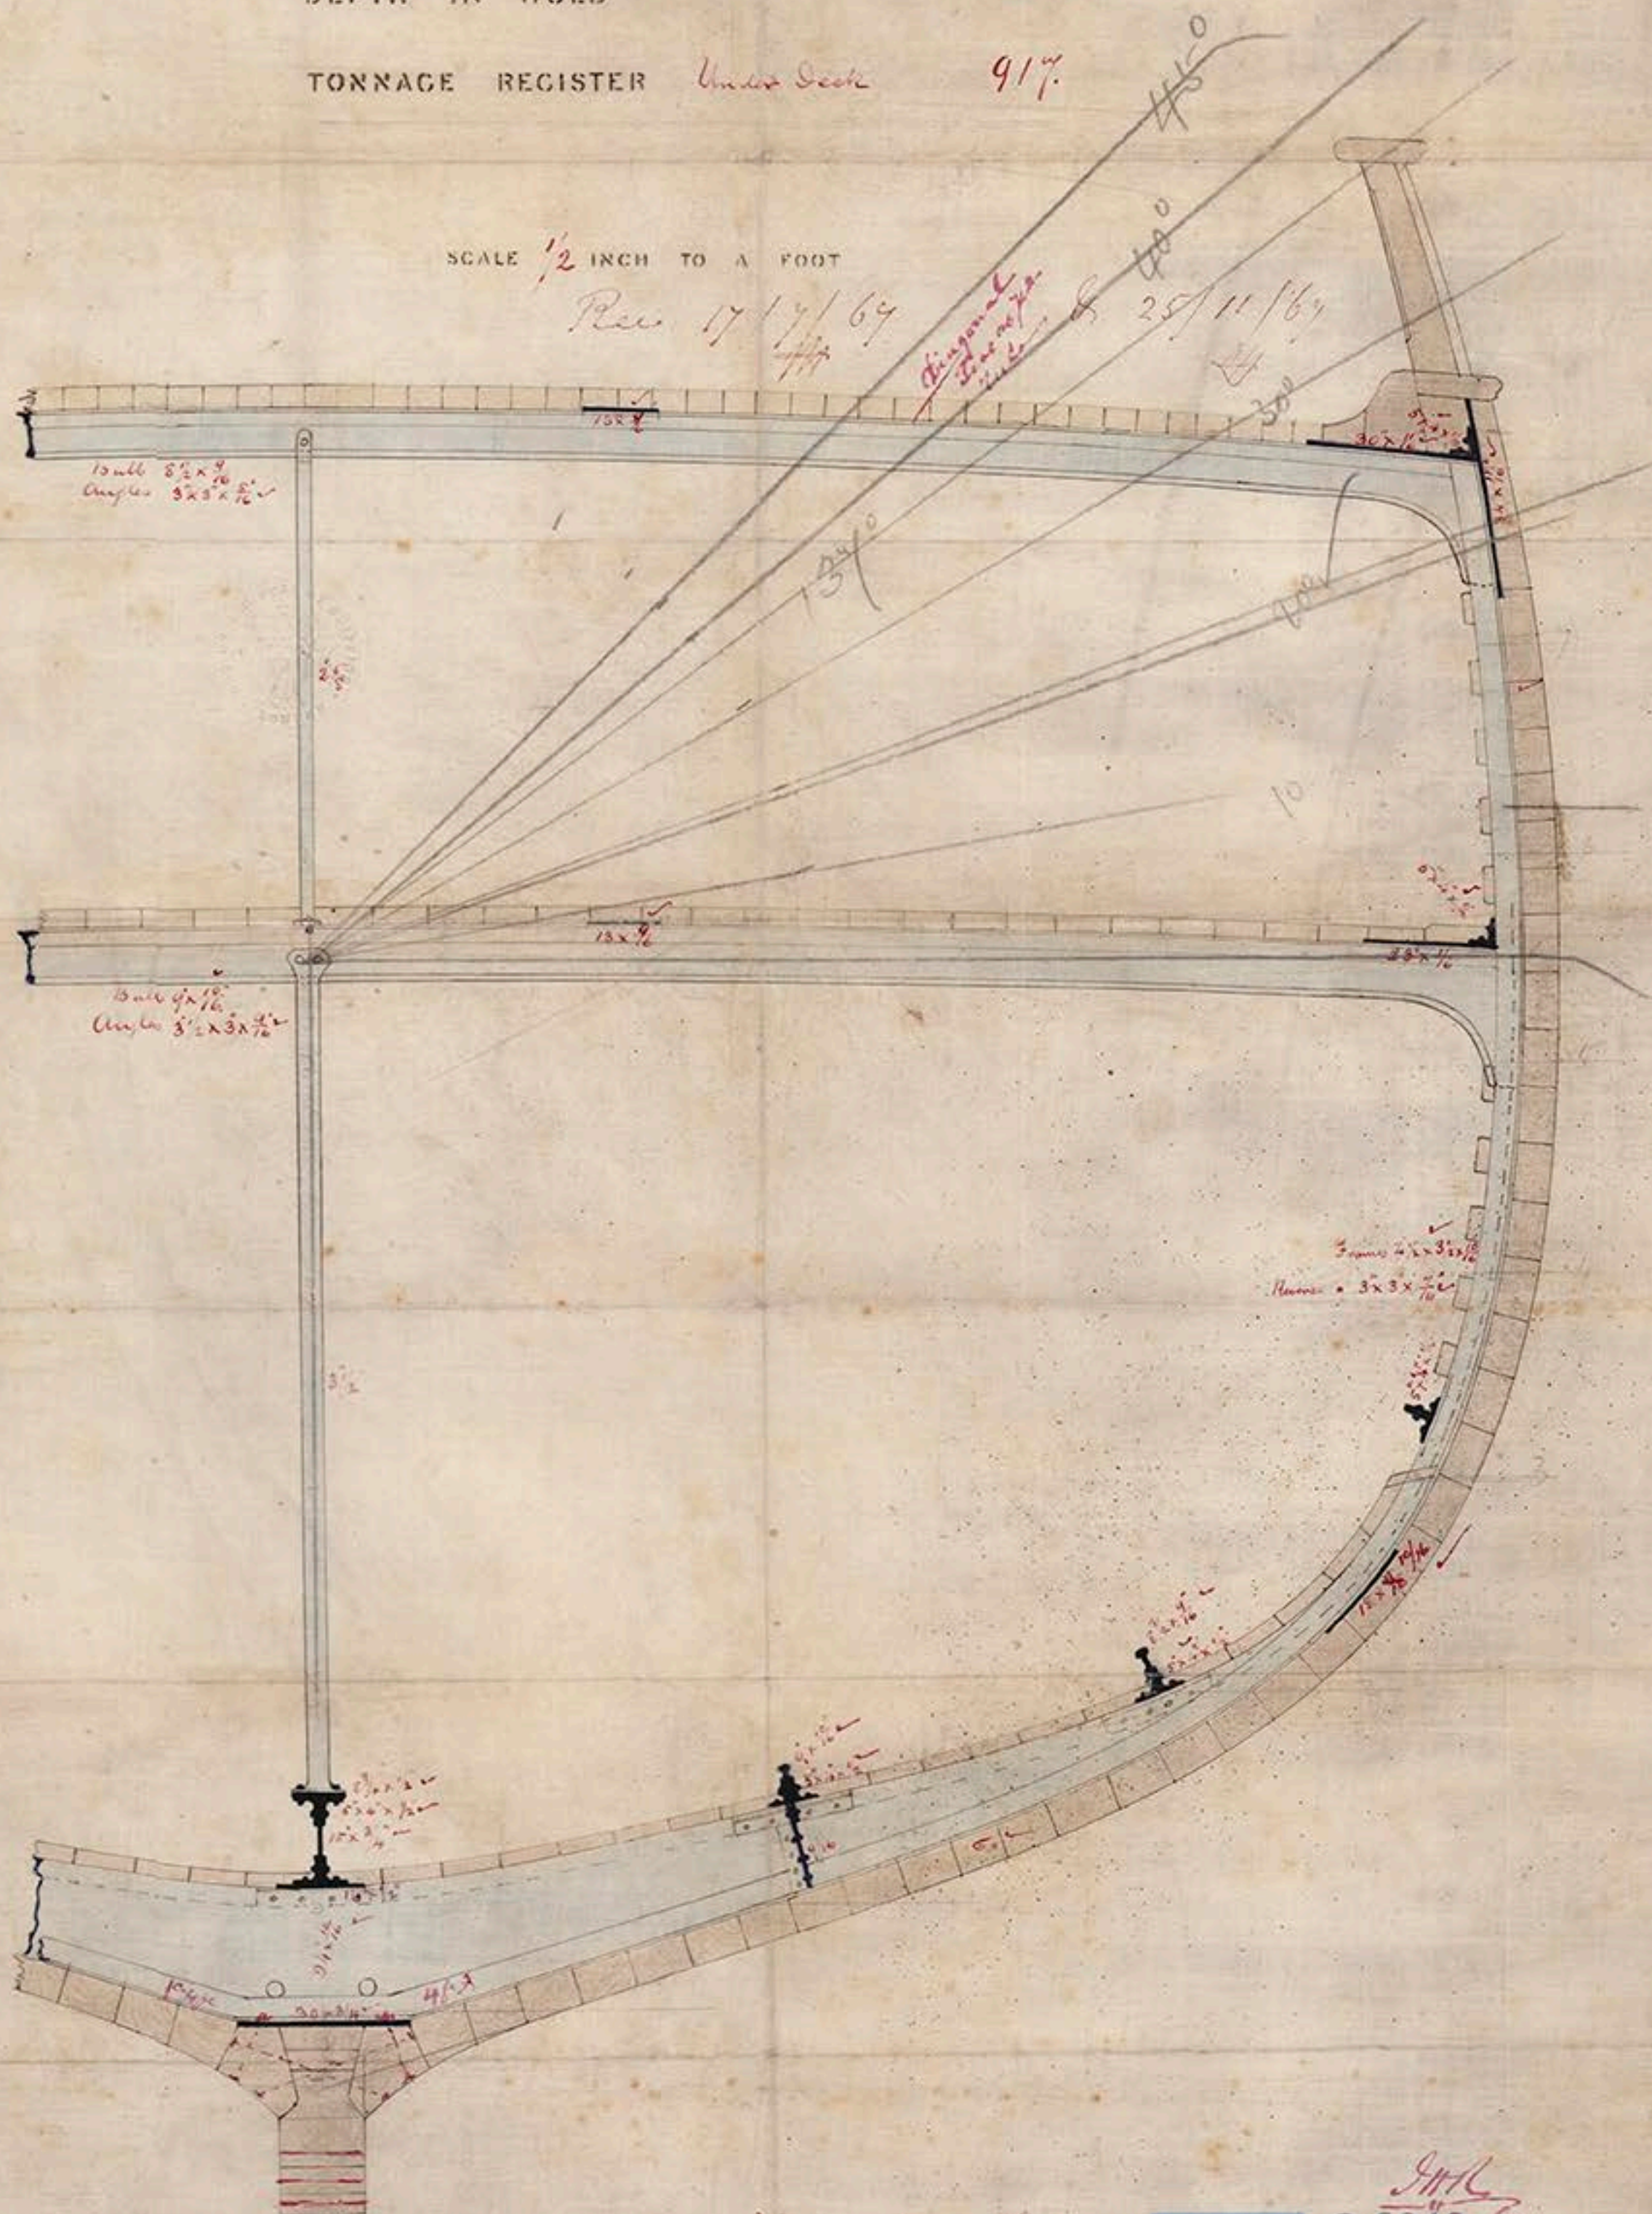

Walter Hood & Co



© 2018 Lloyd's Register Foundation