


*Midship Section of the Composite Tea Clipper "Cutty Sark," built at Dumbarton  
by Messrs., Scott & Linton in 1869, under the Special Survey of the Surveyors to  
Lloyd's Register of Shipping, and Classed +16 A1.*

THIS DRAWING IS CONSTRUCTED FROM PARTICULARS GIVEN IN THE SURVEYORS' FIRST ENTRY REPORT,  
AND IN ACCORDANCE WITH THE RULES OF LLOYD'S REGISTER OF SHIPPING FOR THE  
BUILDING AND CLASSIFICATION OF COMPOSITE VESSELS.

SCALE  $\frac{1}{4}$  OF AN INCH = 1 FOOT.

Registered Length.....212.5 Feet.  
Breadth extreme.....36.0 ..  
Depth of Hold.....21.5 ..  
Tonnage, Gross.....962.97 Tons.  
Ditto Net.....921.39 ..

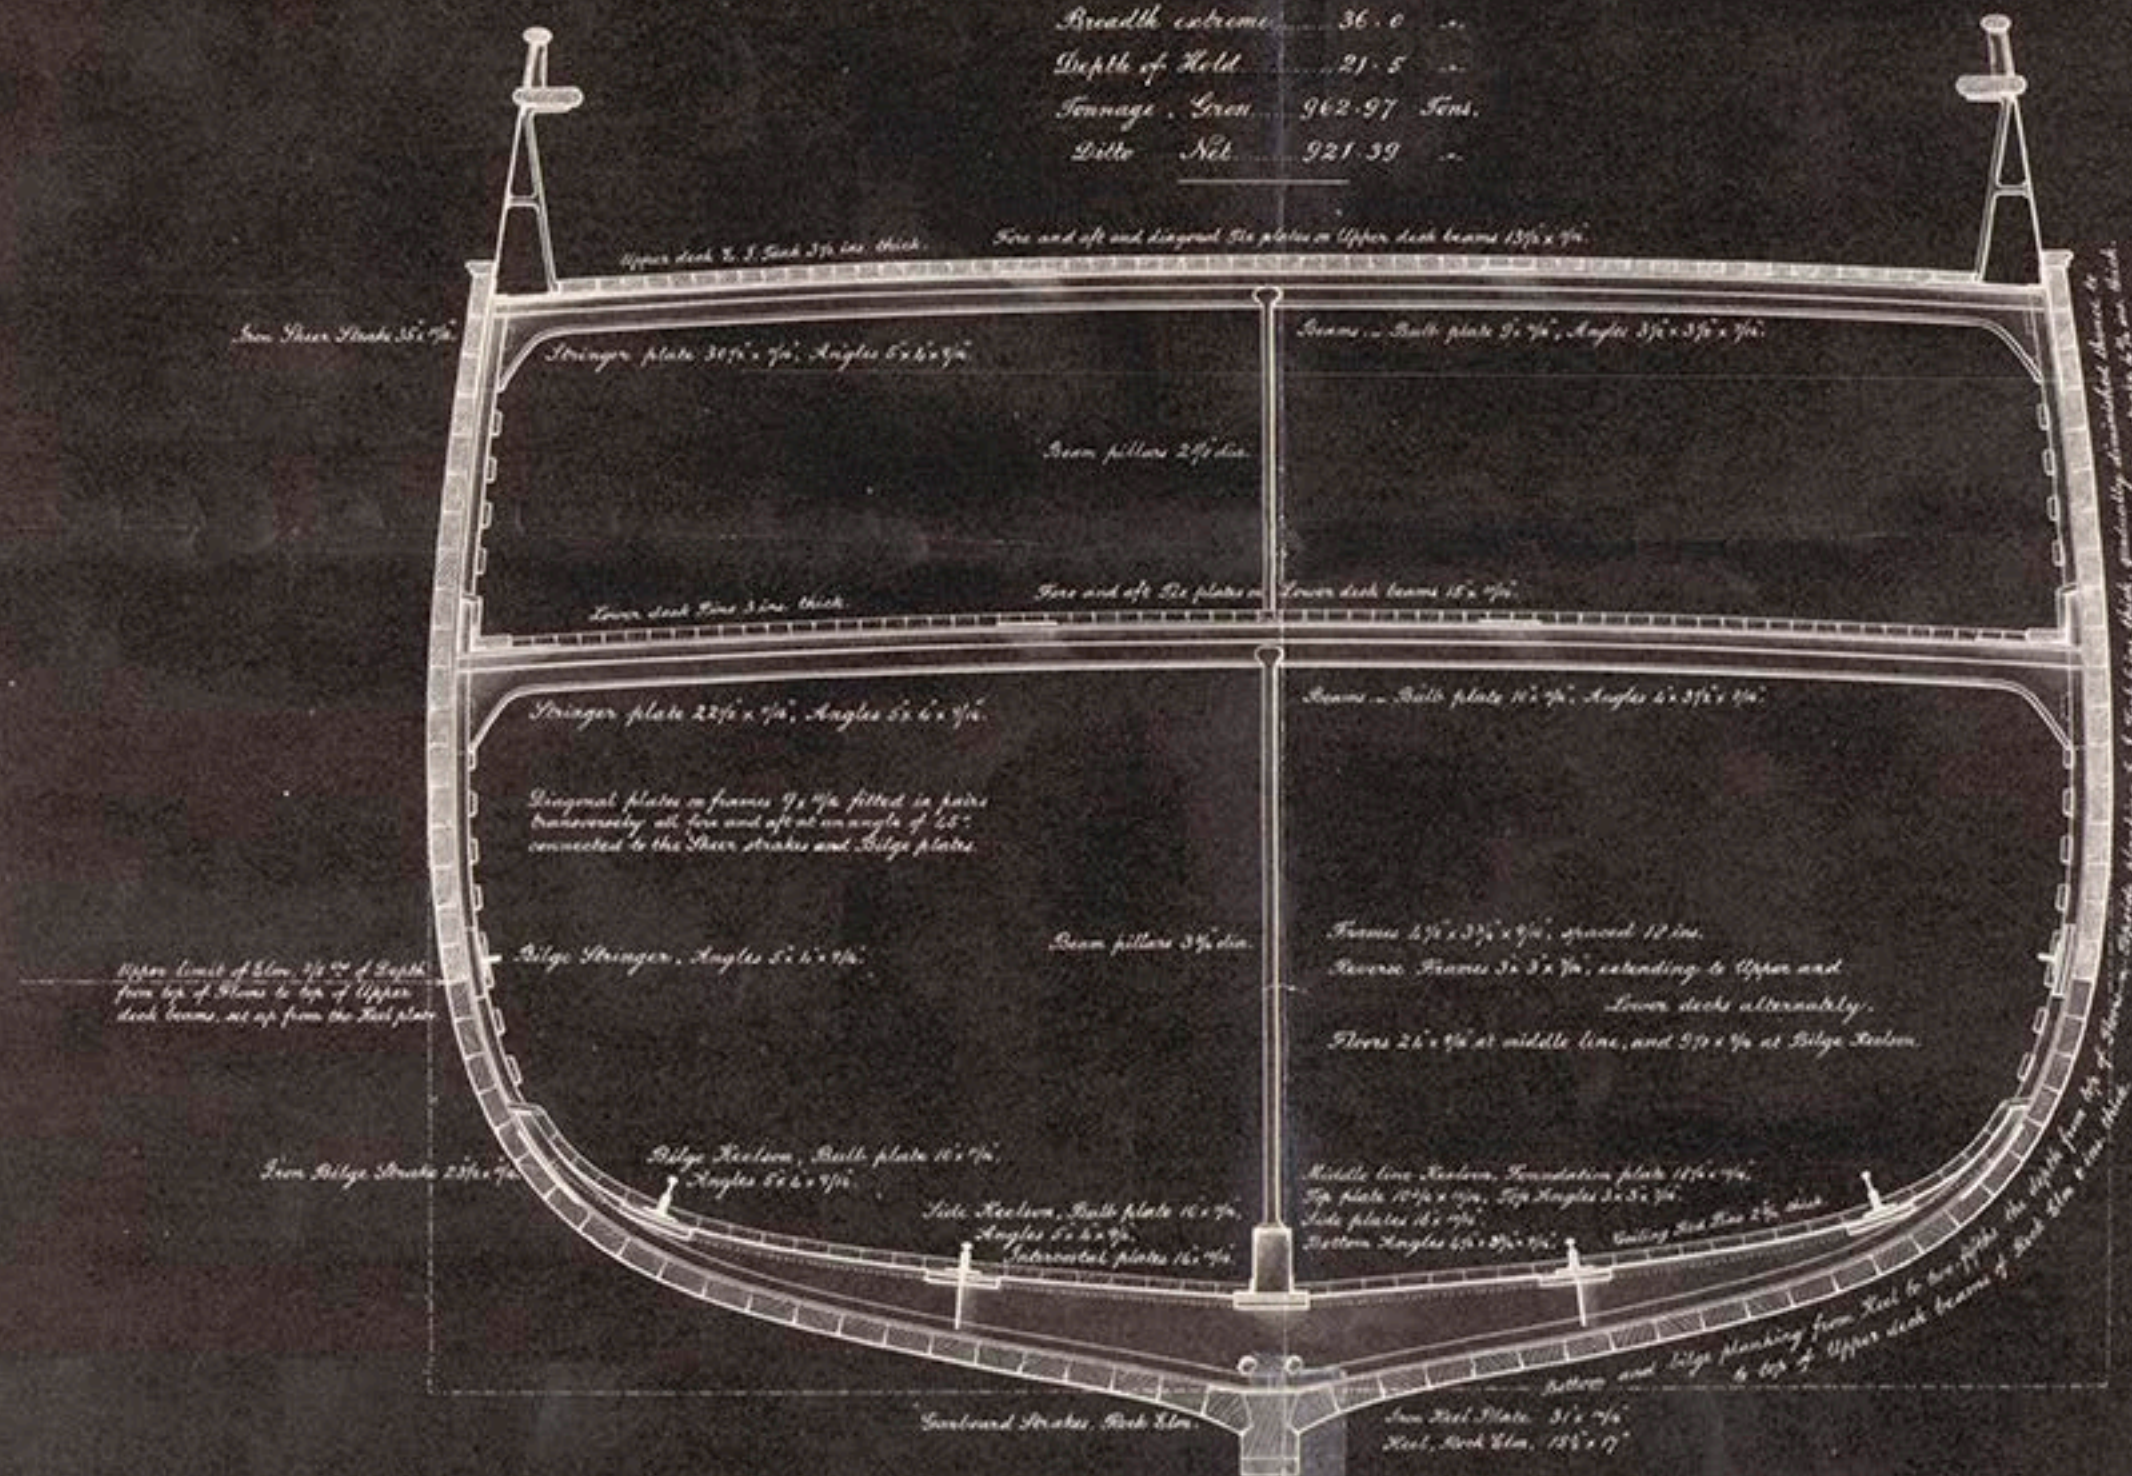

© 2018

Lloyd's Register  
Foundation

DRAWN BY CHAS. H. JORDAN, SEPT. 1921.