Midship Section of the Composite Tea Clipper "Cutty Sark", built at Dumbarton by Messrs Scott & Linton in 1869, under the Special Survey of the Surveyors to Lloyd's Register of Shipping and Classed + 16 A 1.

THIS DRAWING HAS BEEN CONSTRUCTED FROM MEASUREMENTS AND PARTICULARS OF THE VESSEL, OBTAINED WHILE IN DRY DOCK AT THE 'UNION DOCKS' OF MESSRS FLETCHER, SON & FRANNELL, LIMITED, LIMEHOUSE, LONDON, JANUARY, 1922.

SCALE ½ OF AN INCH = 1 FOOT.

Registered Length.....212.5 Feet.
Breadth extreme.....36.0 "
Depth of Hold.....21.0 "
Moulded Depth.....22.5 "
Tonnage, Gross.....962.97 Tons.
" Nett.....921.39 "

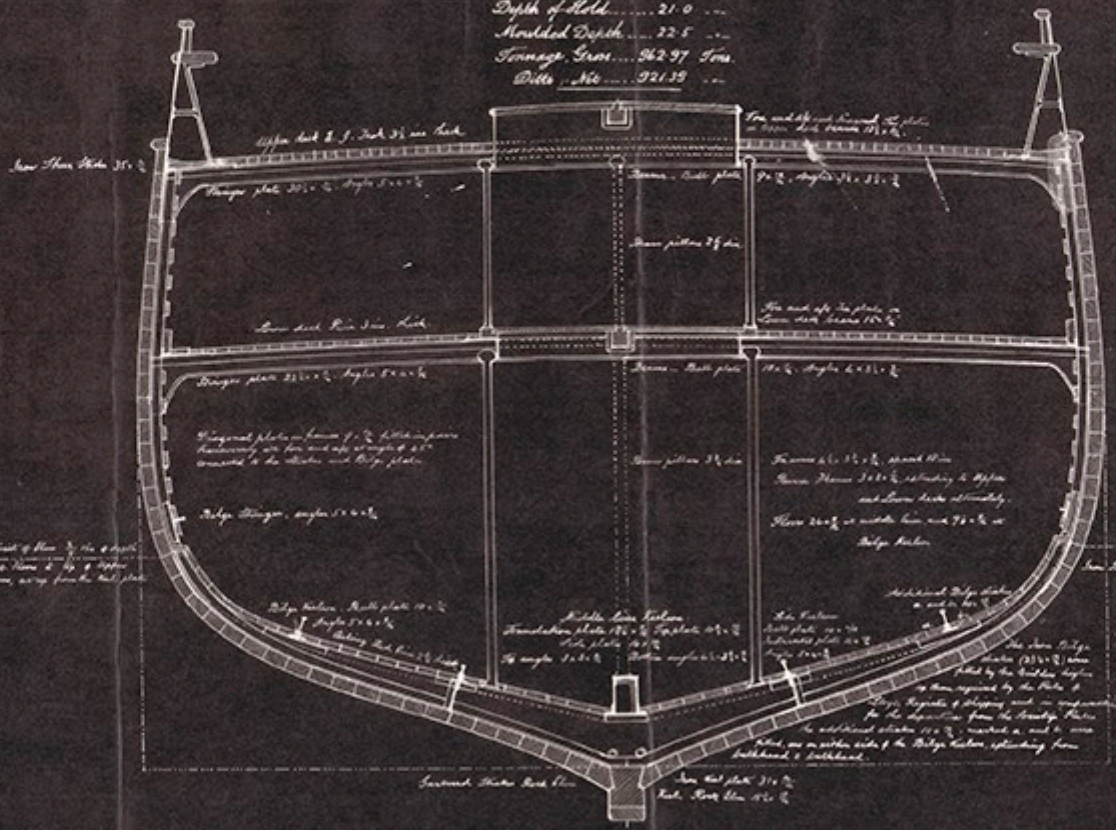

© 2018 Lloyd's Register Foundation