Midship Section of the Composite Tea Clipper "Cutty Sark", built at Dumbarton by Messrs Scott & Linton in 1869, under the Special Survey of the Surveyors to Lloyd's Register of Shipping and Classed + 16 A 1.

THIS DRAWING HAS BEEN CONSTRUCTED FROM MEASUREMENTS AND PARTICULARS OF THE VESSEL OBTAINED WHILE IN DRY DOCK AT THE 'UNION DOCKS' OF MESSRS FLETCHER, SON & FLANNELL, LIMITED, LIMEHOUSE, LONDON, JANUARY, 1923.

SCALE ½ OF AN INCH = 1 FOOT.

Registered Tonnage	212 Tons.
Breadth extreme	36.0 "
Depth of Hold	21.0 "
Moulded Depth	22.6 "
Tonnage Gross	962.97 Tons.
Ditto Net	921.39 "

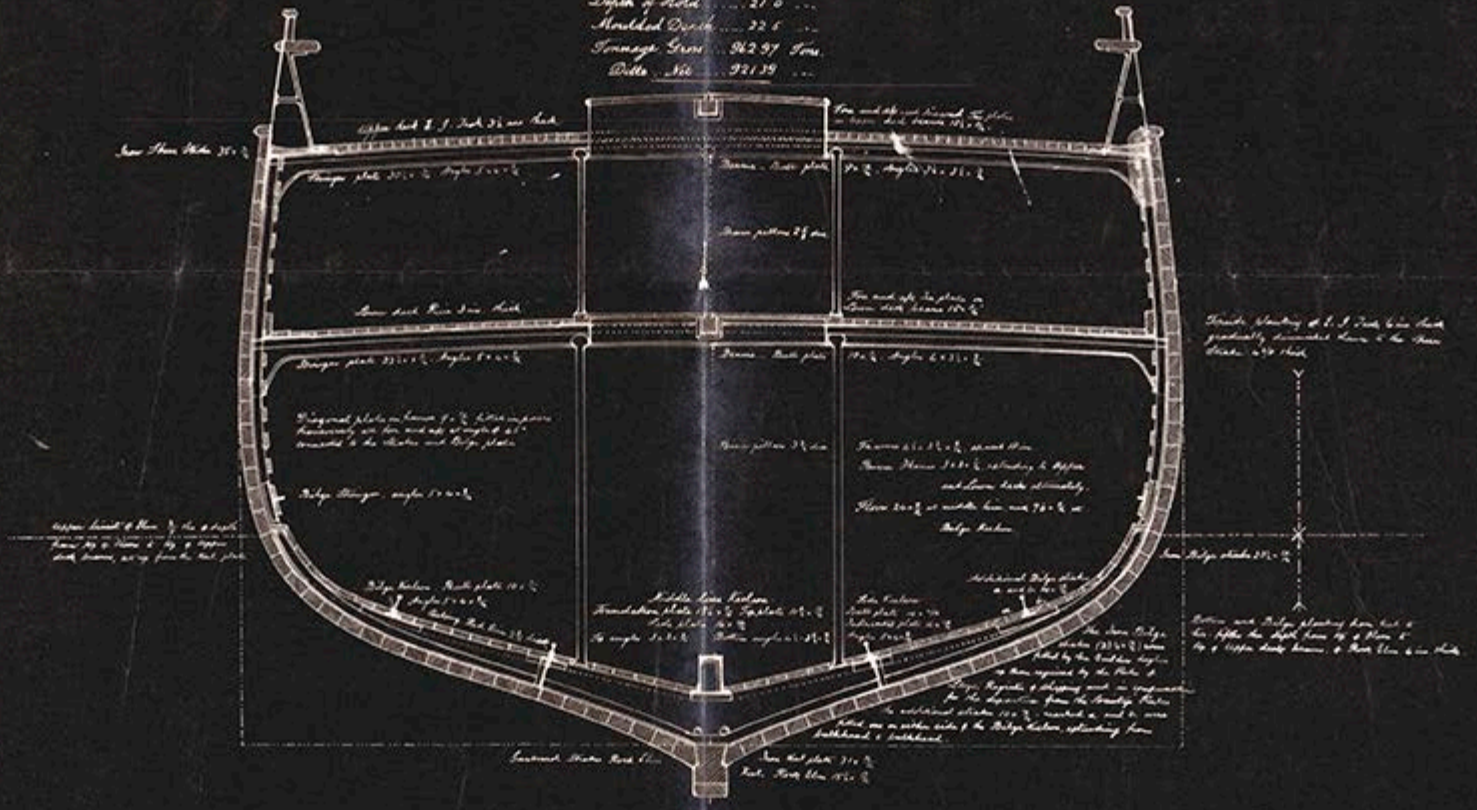

© 2018 Lloyd's Register Foundation