


26/5/75

Rec 24/17/35

For and aft location
of Engine & Boiler space
for 90 B.H.P. S.S.
Blackwood & Gordon
Port Glasgow
12/5/75

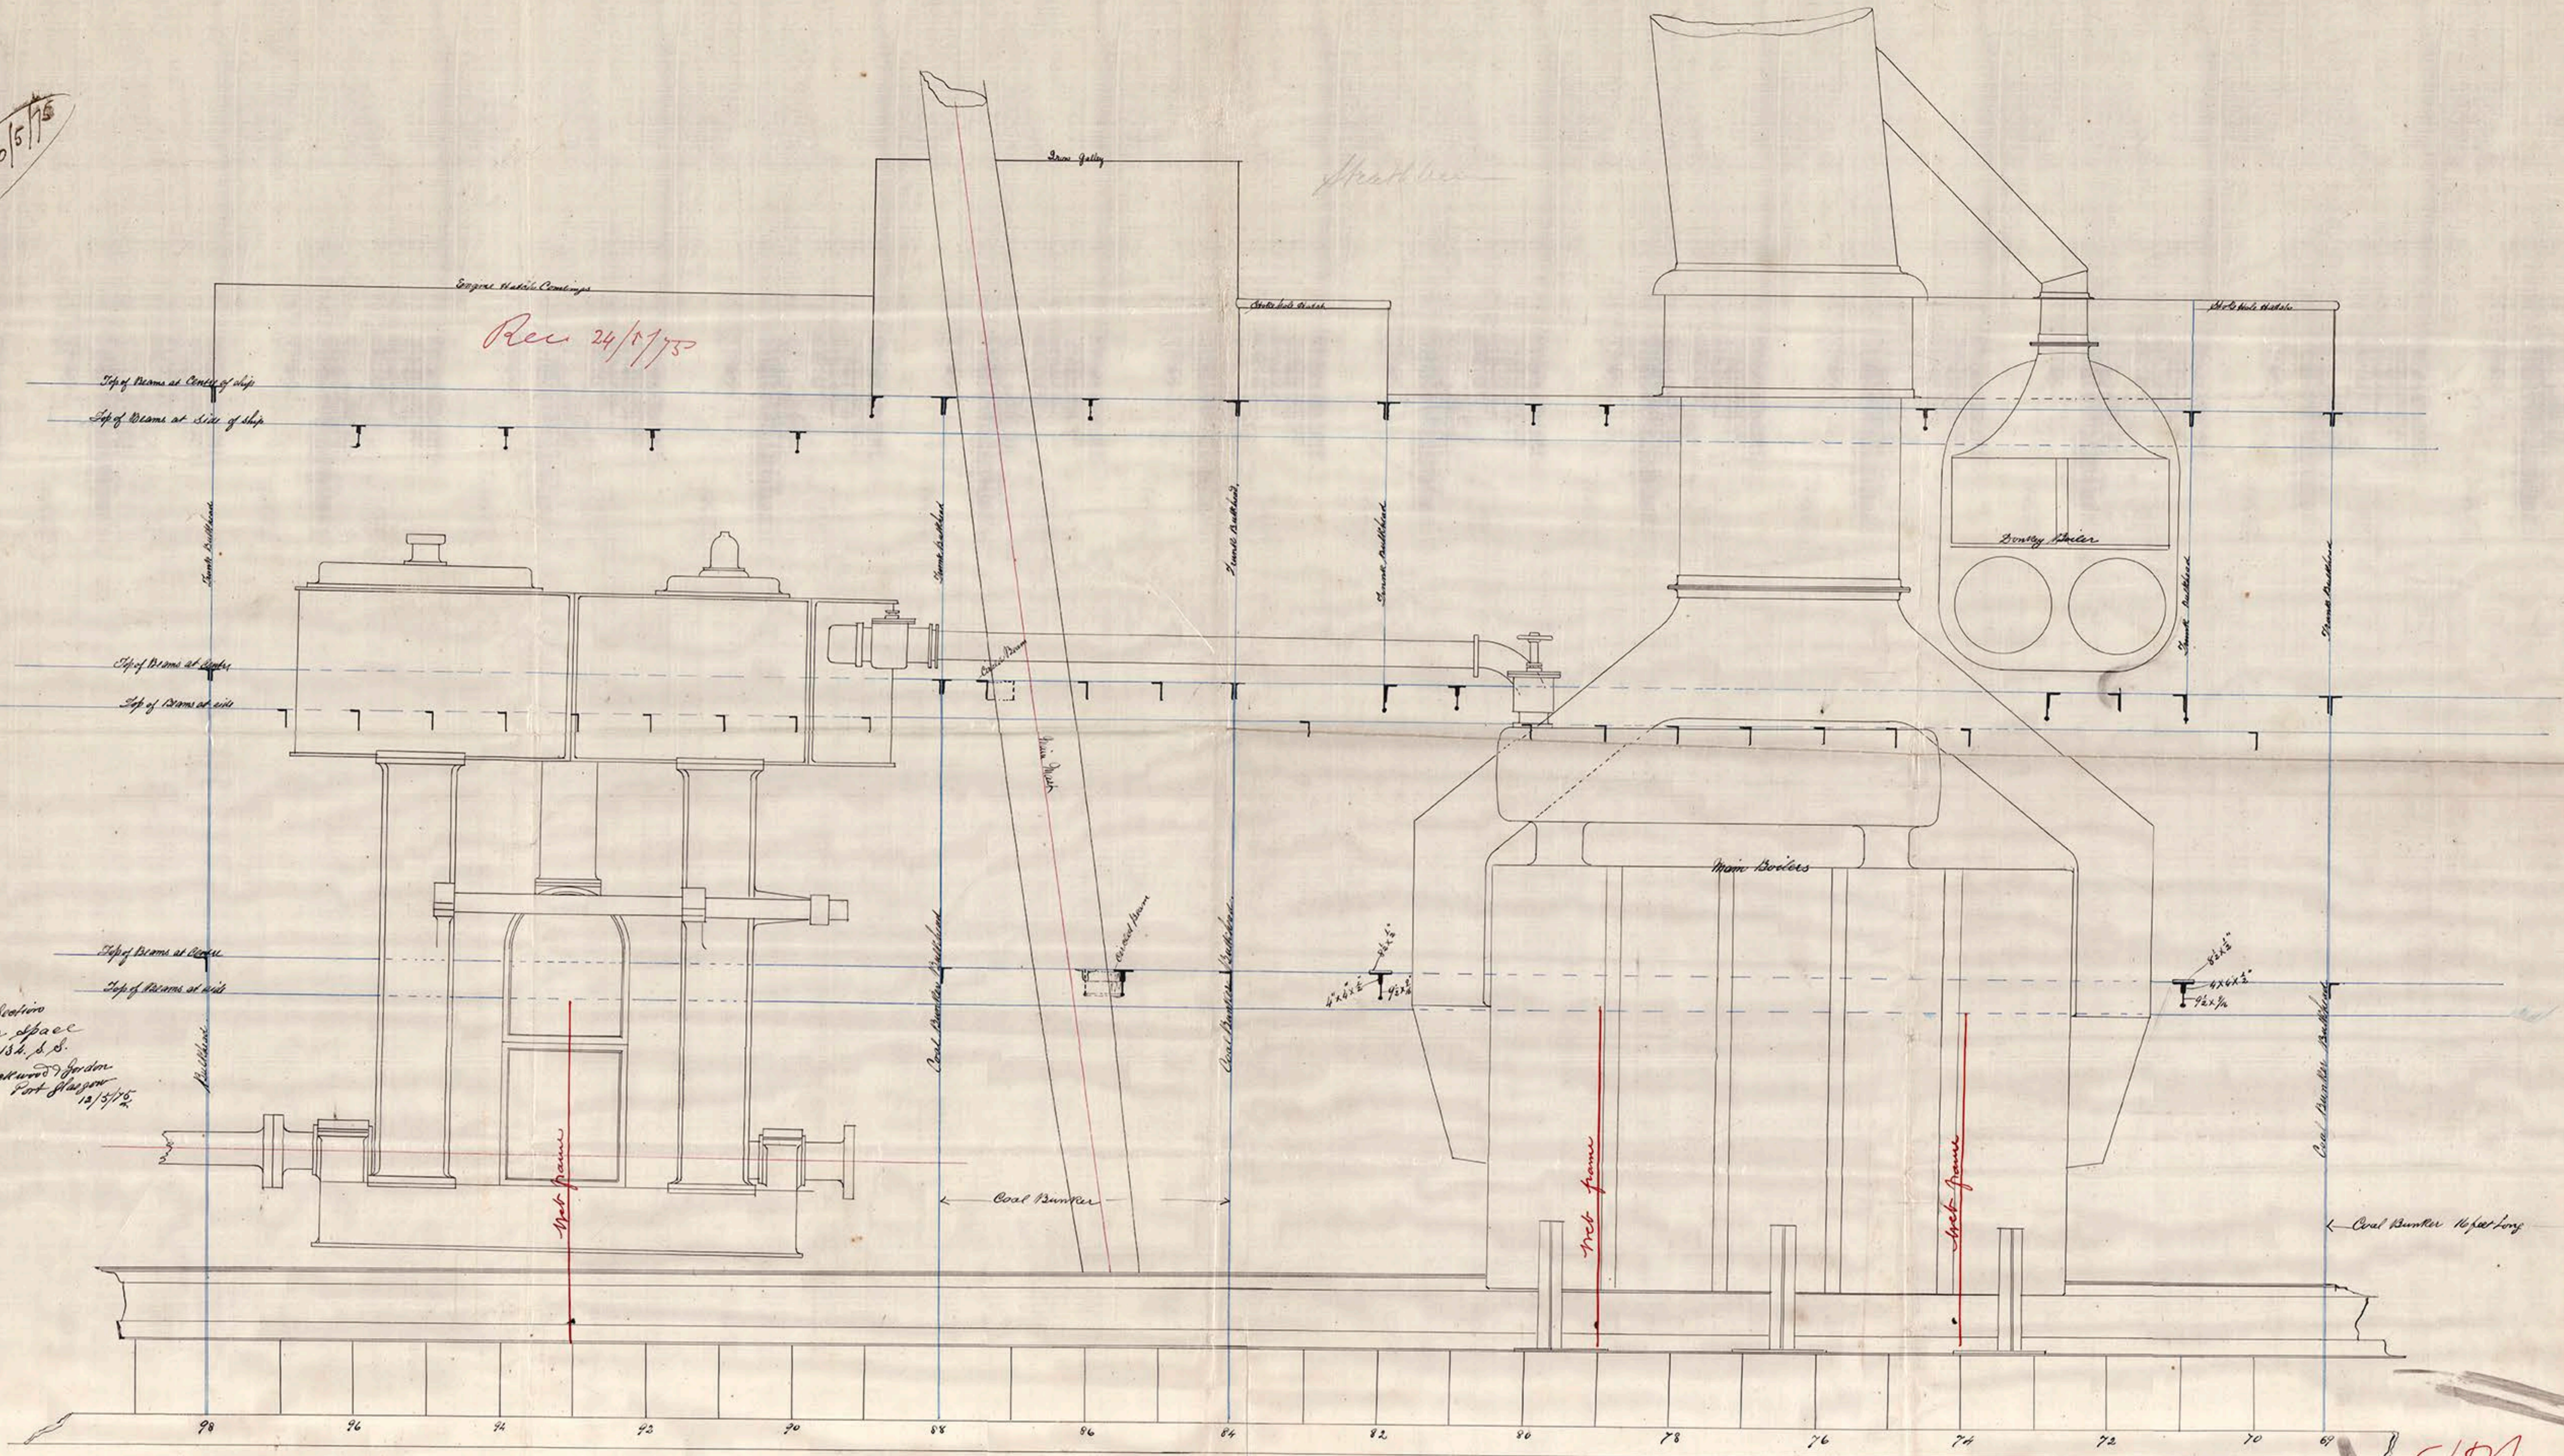

Scale 1/2 inch = one foot