

Lloyd's Register of British and Foreign Shipping.

(Report on Vessel No. 11332 Port Glasgow)

"Ben-Lee"

No. 3987 SHIP FORGINGS ~~OR CASTINGS~~

The words FORGINGS or CASTINGS, IRON or STEEL, should be struck out as may be required.

I have to report that the undermentioned Iron ~~or Steel~~ Forgings ~~or Castings~~,
manufactured by Messrs Barclay Curle & Co
of Glasgow for the Vessel No. 386, being built
by Them of

have been inspected by me as set forth below, and found to be, so far as can be seen,
Sound & efficient

Mark on Forgings.

Lloyd's
No. 3987
W.H.

William Hamilton
Glasgow 14/8/93

STERN FRAME.


RUDDER FRAME.

STEM.

Material* ...
How made ...
Dimensions ...
Progress on Inspection ...
Date when Inspected ...

Scrap iron
Forged
7 to 3 1/2
Forging & smithing
1. 14. 18. 10. 15. 17/4/93
1. 4. 8/5/93. 6-9/6/93
3. 10/8/93

SKETCHES OF FRAMES SHOWING POSITION AND DESCRIPTION OF WELDS OF FORGINGS, OR PARTICULARS OF TESTS APPLIED TO CASTINGS.

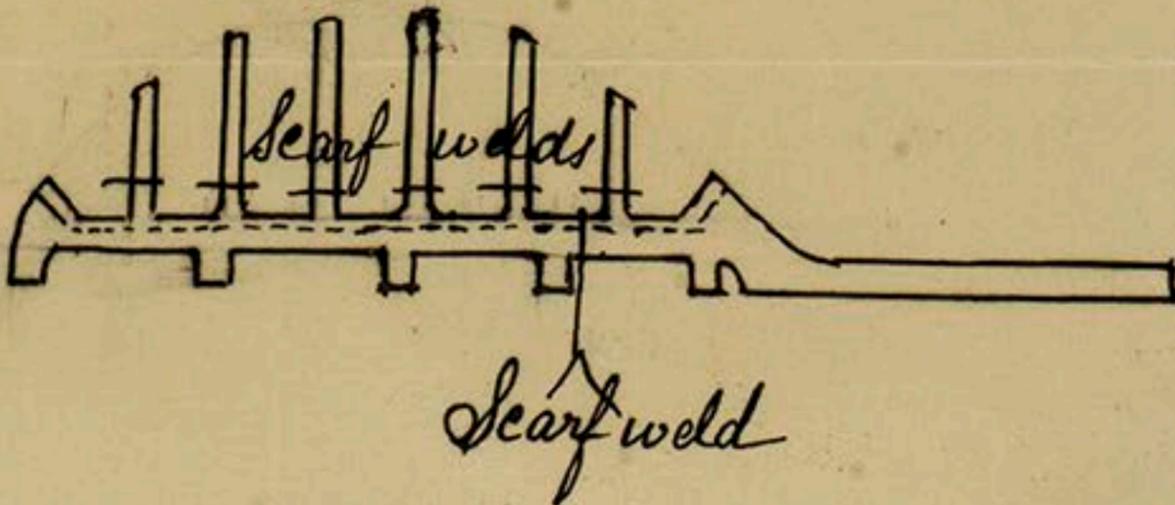

© 2018

Lloyd's Register
Foundation