


N<sup>os</sup> 611 & 612.  
T.S.S. "CONTE ROSSO" & "CONTE VERDE".  
SECTION THRO' BOILER ROOM  
FOR M.O.I.  
SCALE  $\frac{1}{4}'' = 1$  FOOT.

WILLIAM BEARDMORE & CO., LTD.,  
DESIGNING DEPT.  
NUMBER 3533  
DATE 29.7.19.  
EXAMINED BY  
NAVAL CONSTRUCTION WORKS,  
DALMUIR, N.B.

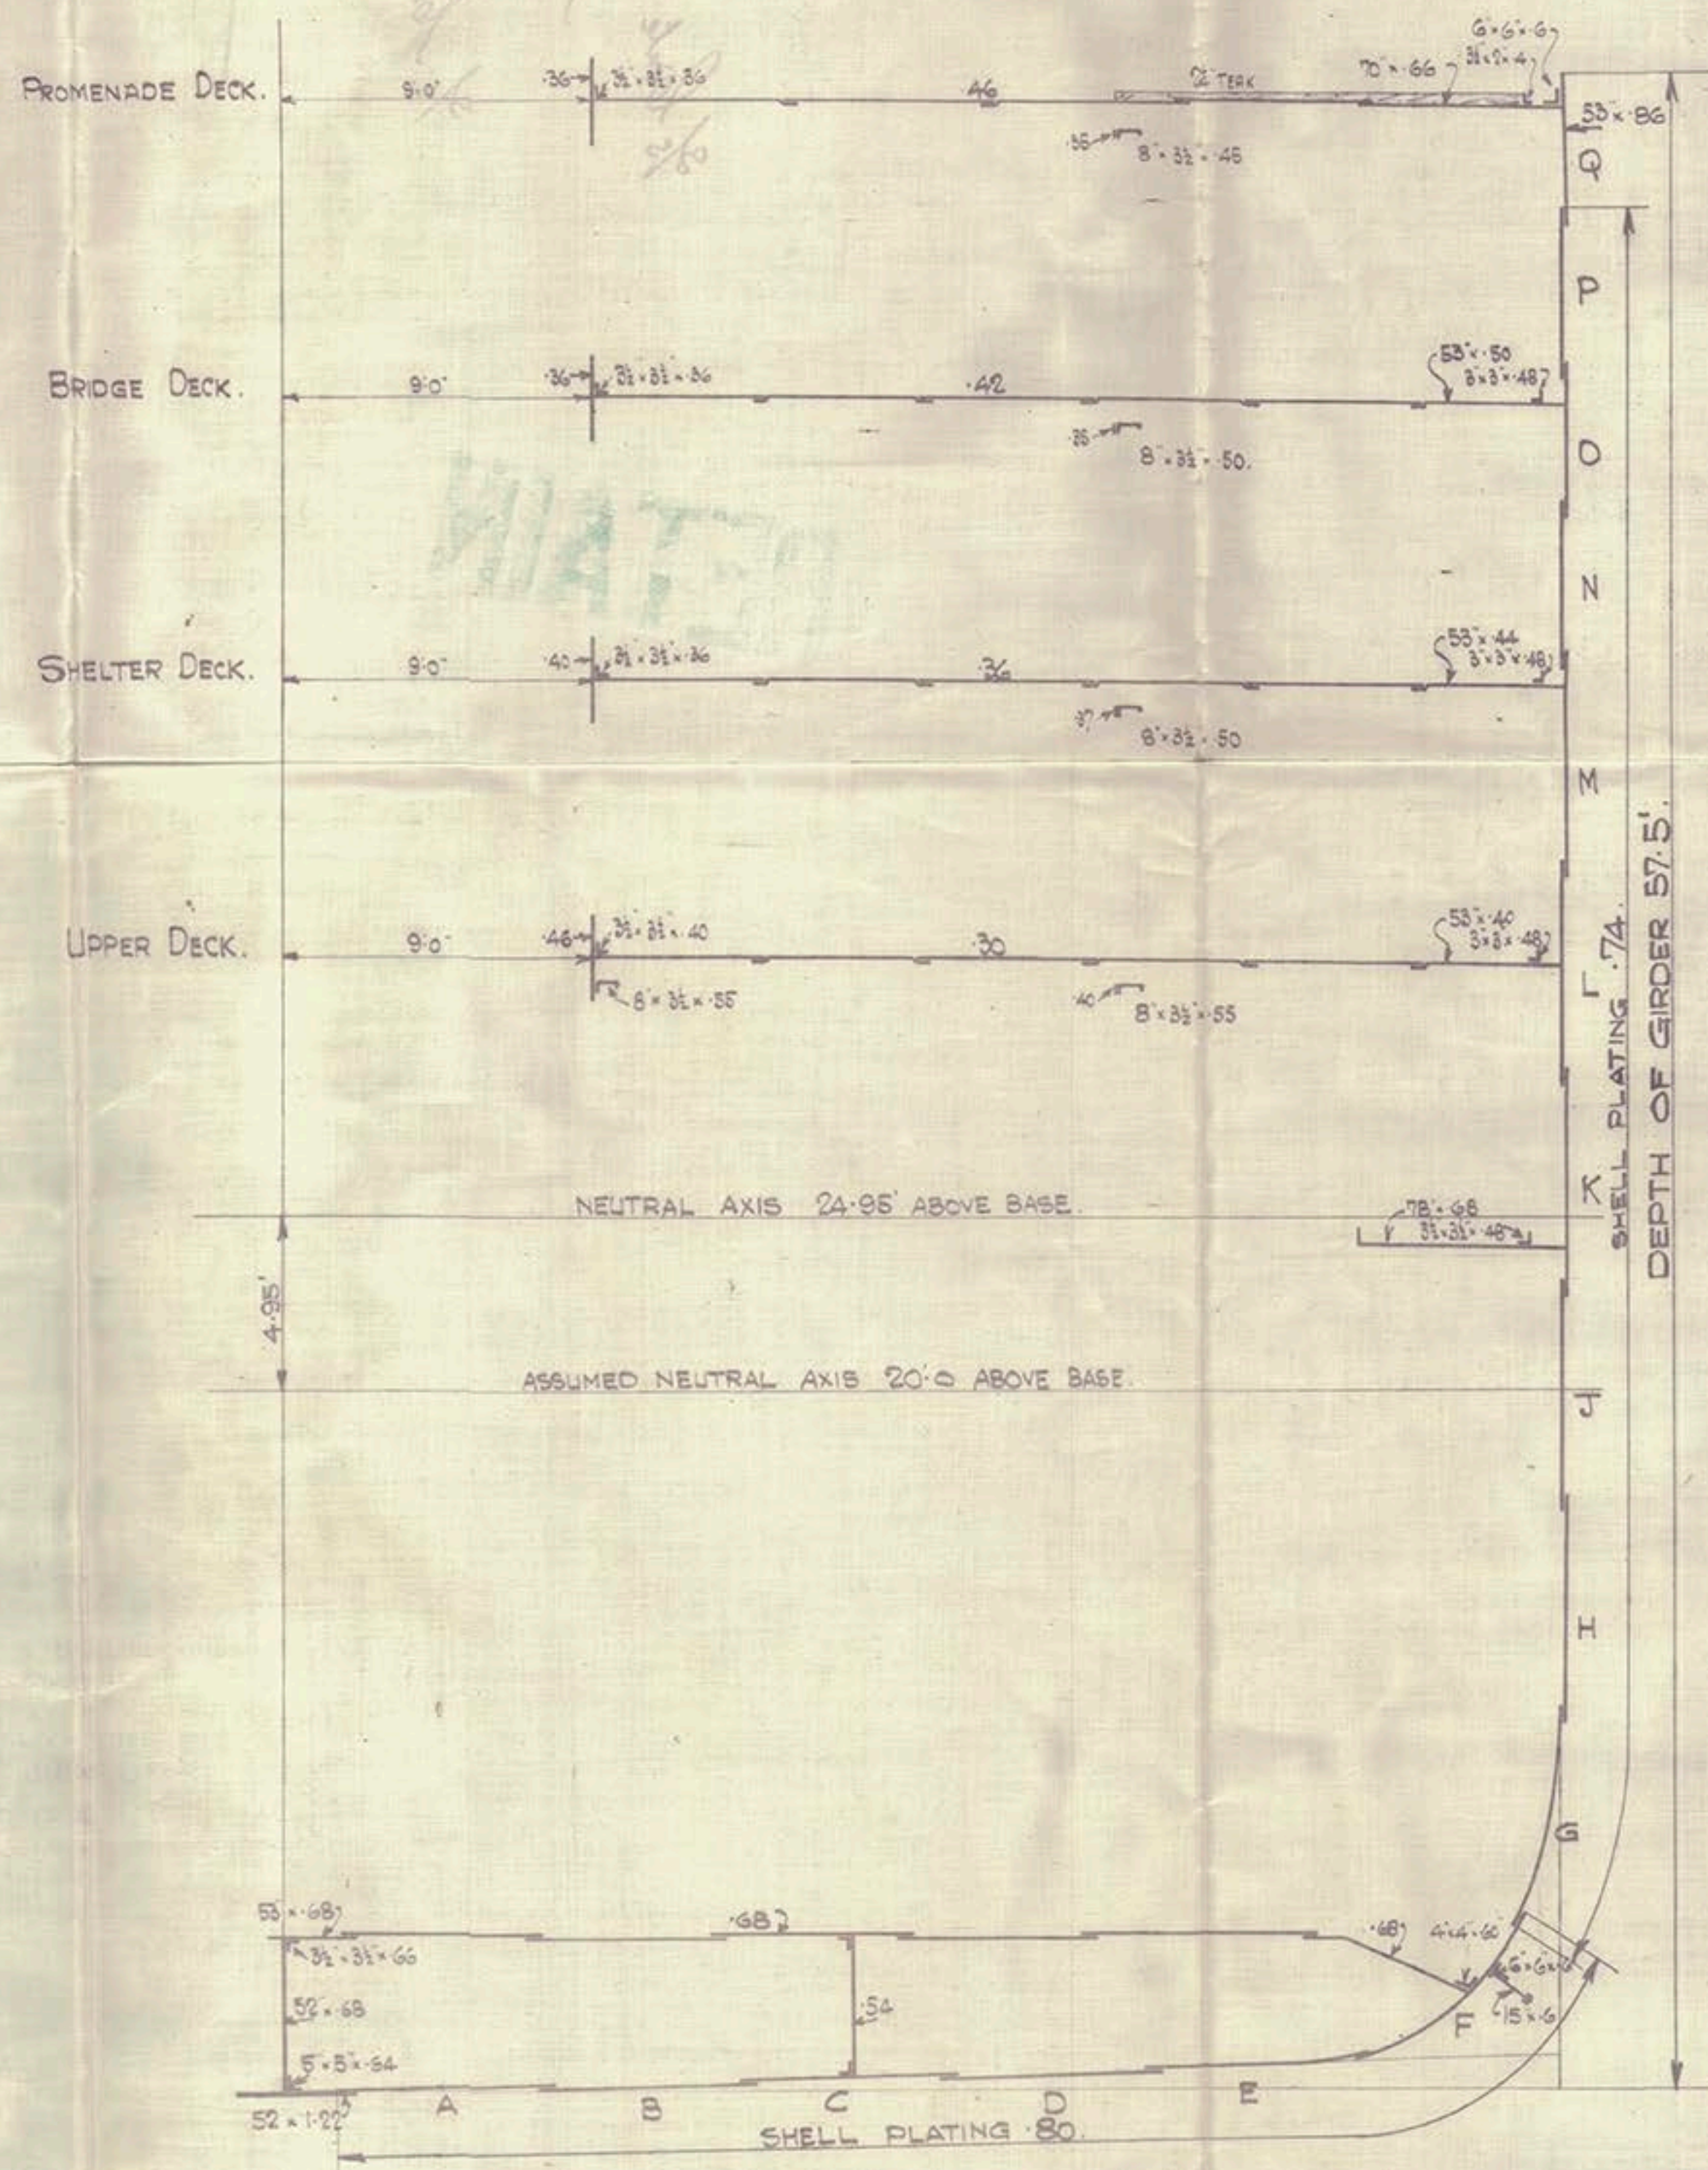



Section for M.O. 2

2/3 Conte Rosso

Gla. 41720.

2/5 Conte Verde.

Gla. 42623

2

*[Signature]*

RETAIN



© 2018

Lloyd's Register  
Foundation

01-01-2018-P-24