
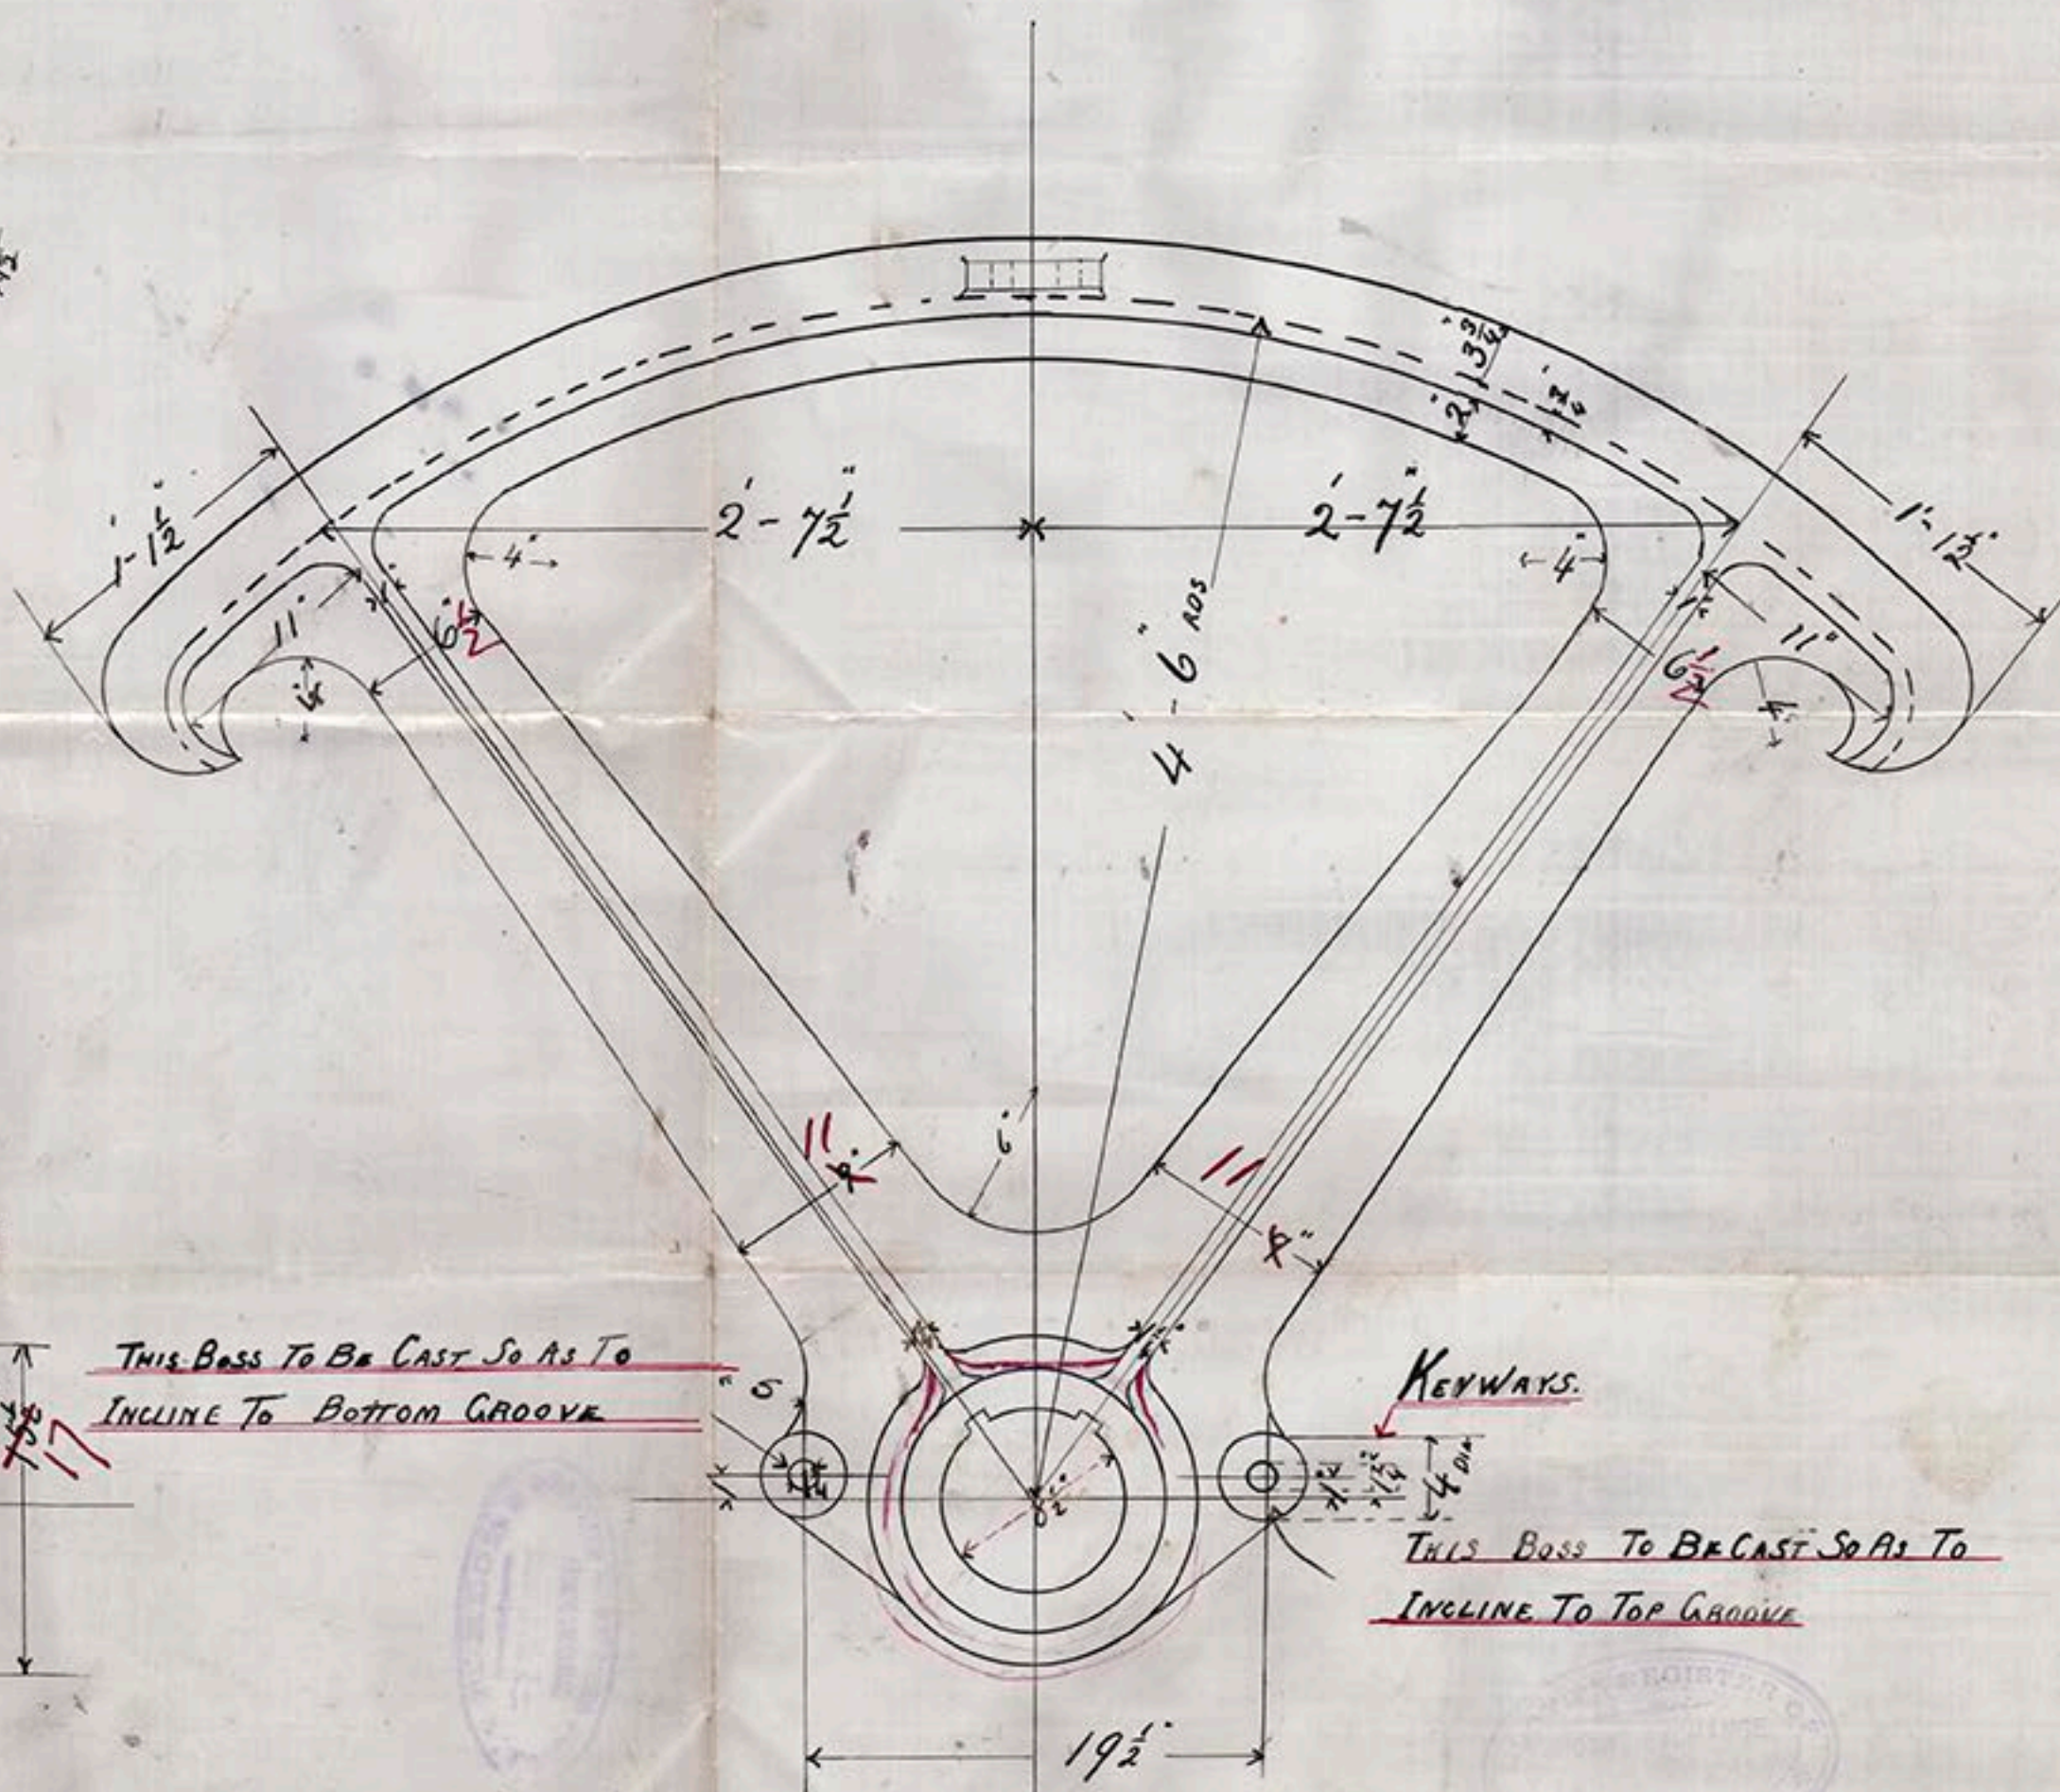
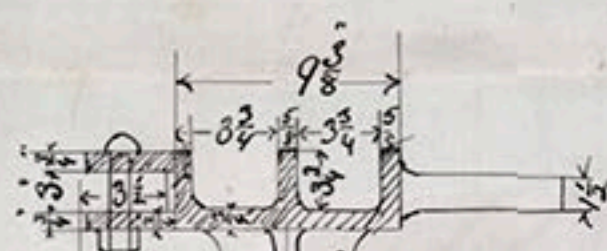


QUADRANT TILLER (CAST STEEL)

SS N° 460

Scale  $\frac{1}{2}'' = 1 \text{ Foot}$

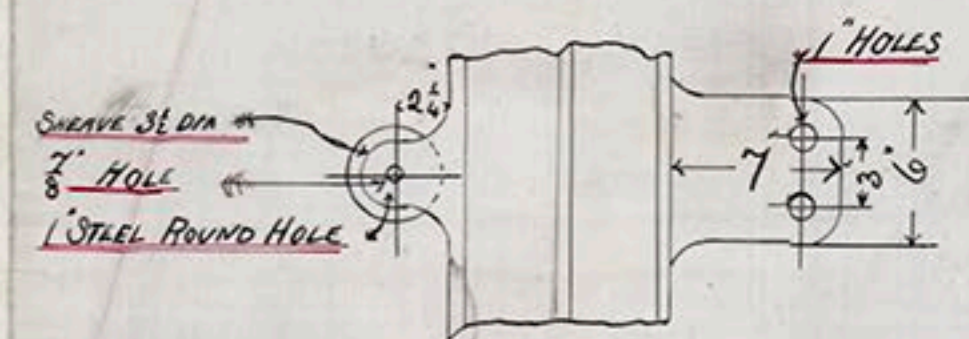

THIS BESS TO BE CAST SO AS TO  
INCLINE TO BOTTOM GROOVE

### KEYWAYS

THIS BOSS TO BE CAST SO AS TO  
INCLINE TO TOP GROOVE

Nº 6685

SHIPBUILDERS & ENGINEERS  
CLEVELAND DOCK YARD  
MIDDLE SPRING LANE  
© 2018  
Lloyd's Register  
Foundation  



Sir R. Dixon & Co


No. 460

Cast Steel  
Quadrant Filler


"Mont Blanc"

Mdb. Report 2620

Does not apply to  
sister vessel

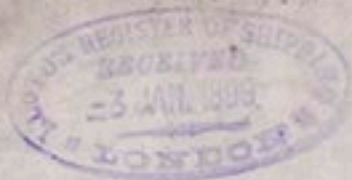

INCLINE TO BOTTOM CROSS  
TWO INCHES TO BE AT RIGHT

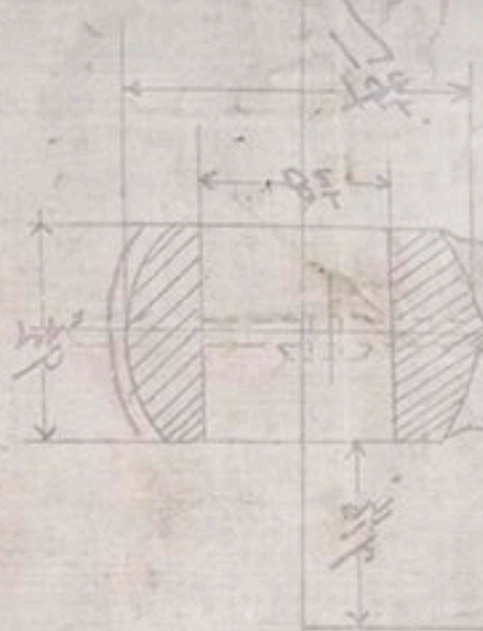

© 2018

Lloyd's Register  
Foundation

LR-FAF-TB21-P-16