

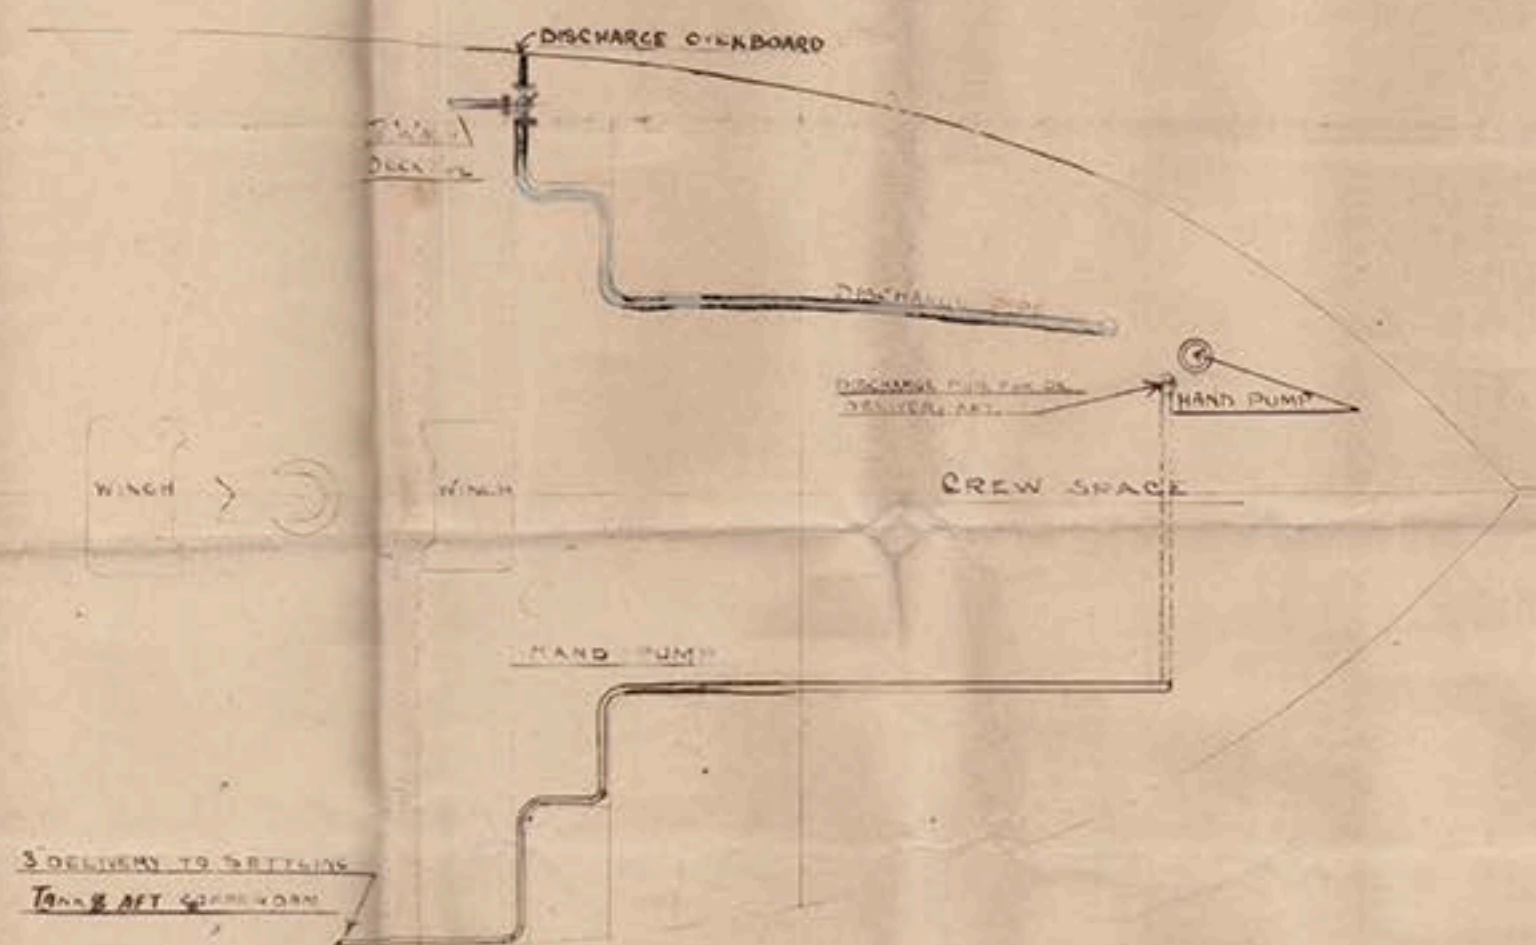


— PUMPING ARRANGEMENT. —
 FOR
 — FORE PEAK, CARGO HOLD. —
 & COFFERDAM.
 — FOR —
 — S.S. "MUREX" —
 Oct 18th 1900

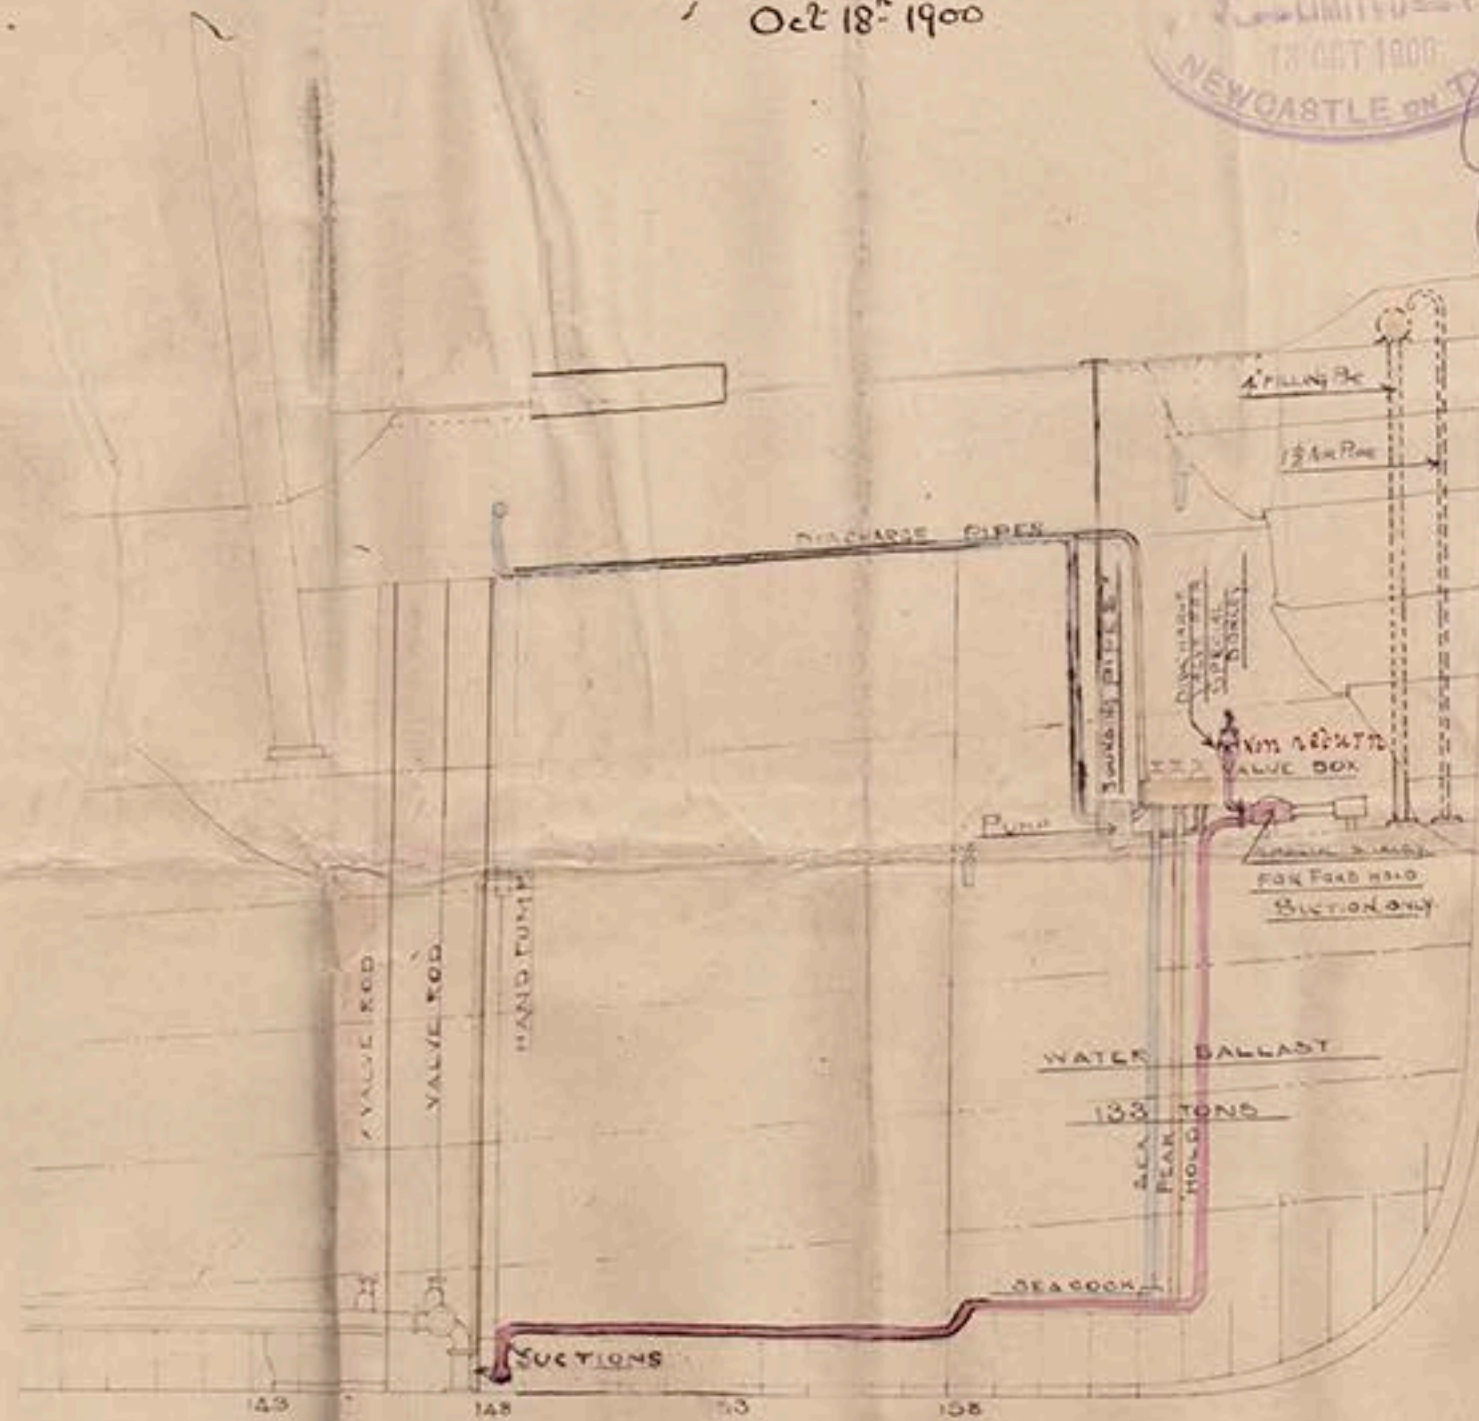

PLAN ON FORE PEAK TOP.

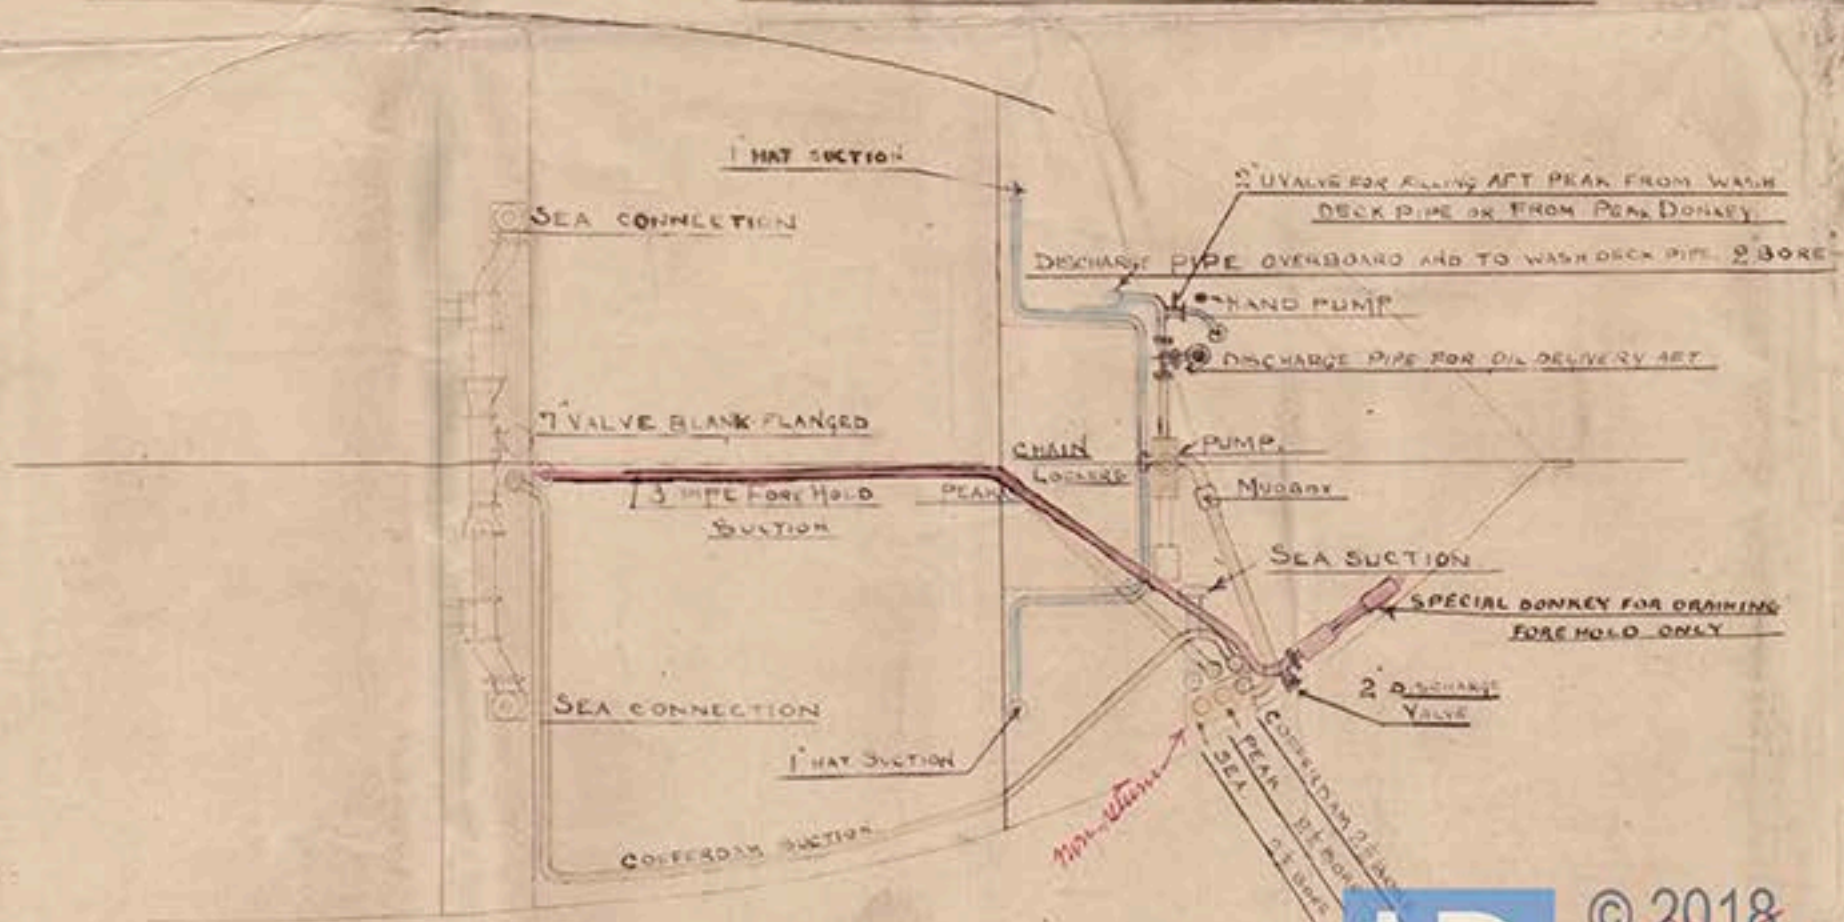

Oil fuel plan



S. J. Murray
© 2018

Murray
Stephen J.
Lloyd's Register
Foundation