





18.93.
28.93.
9.93.



No. 106 and 17
Apr 5. 20. 12. 55.
No. 114
Apr. 10. 11. 94

S. S. N^o 10-4

SCALE 1/8 ONE FOOT

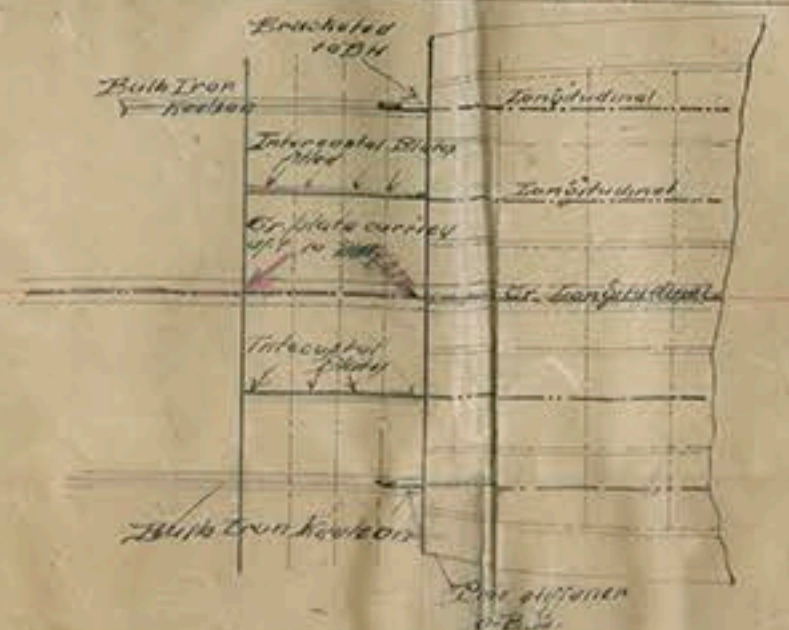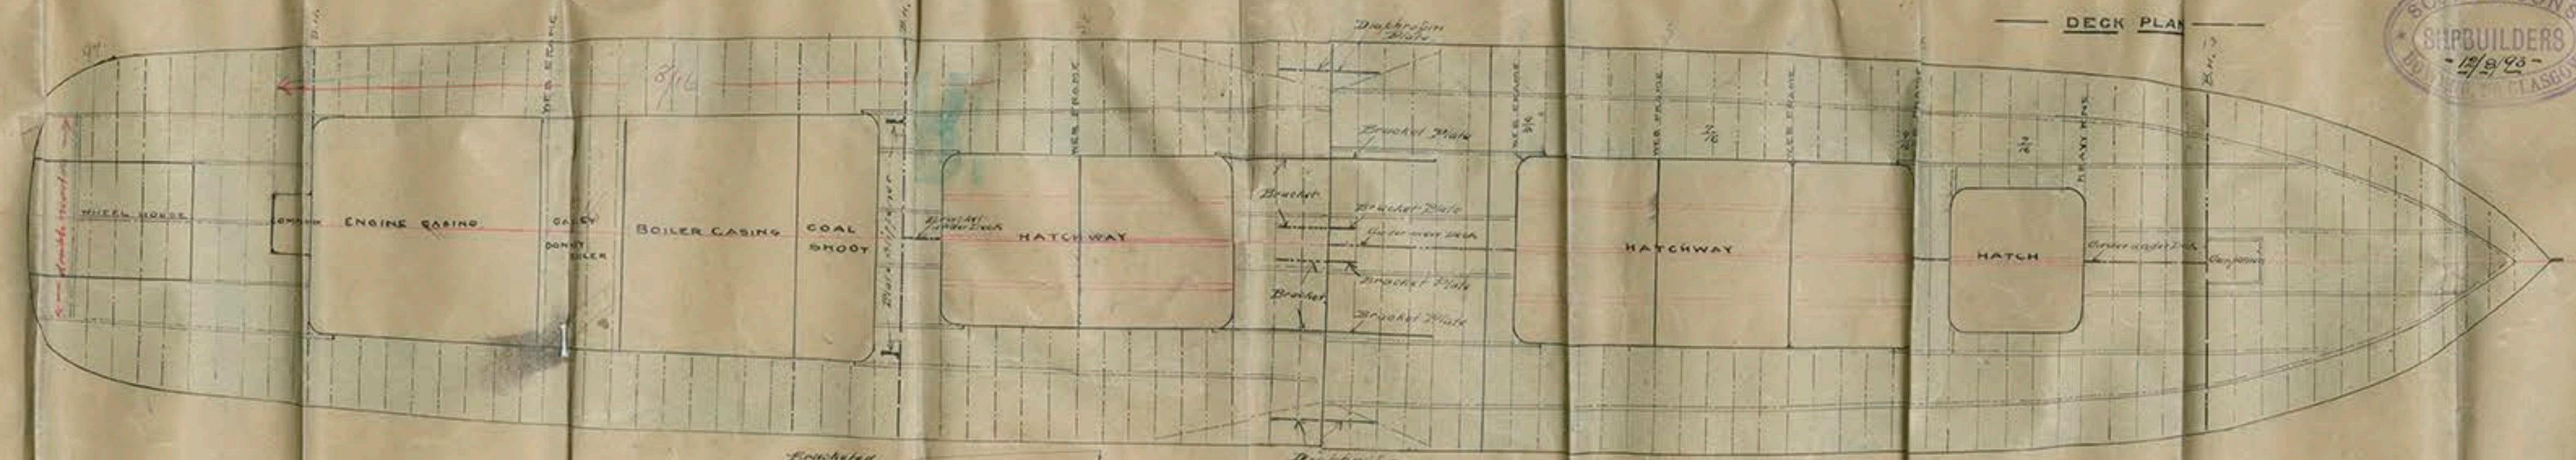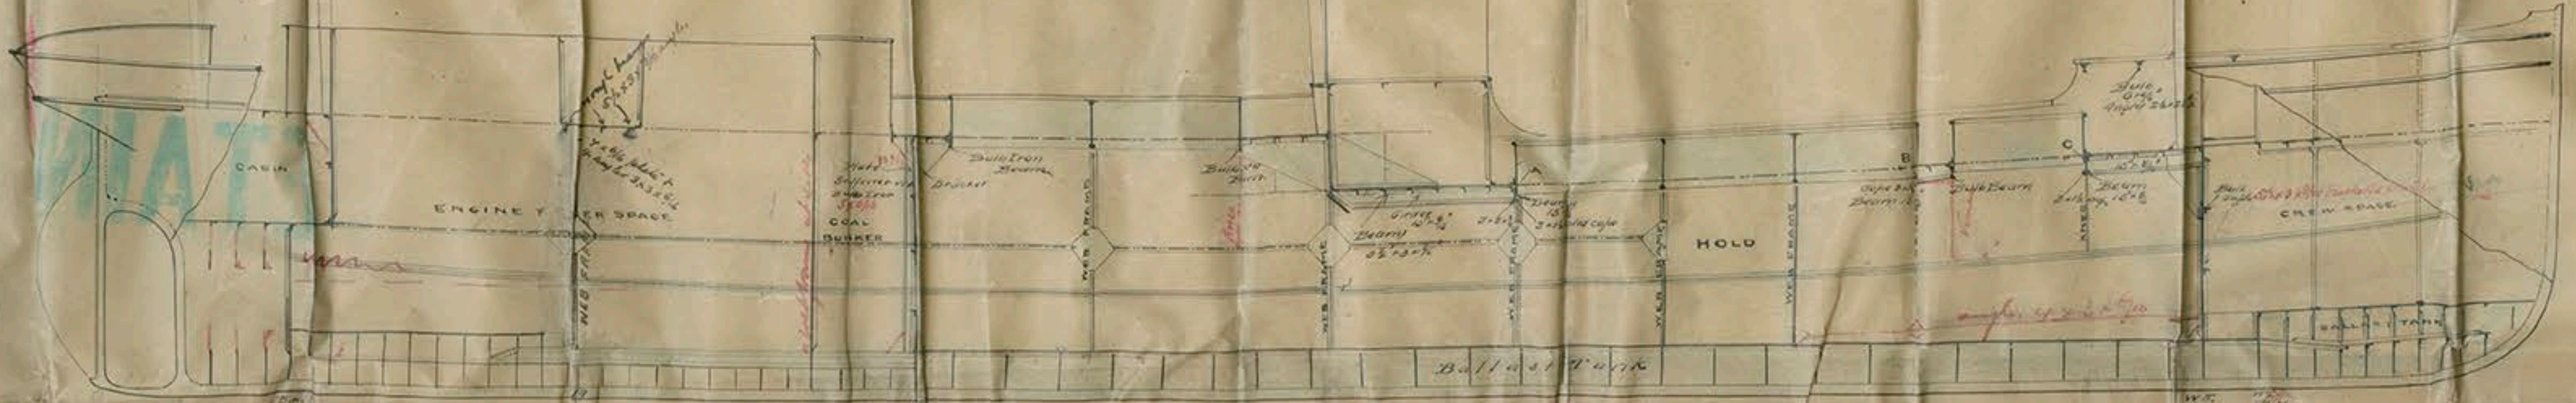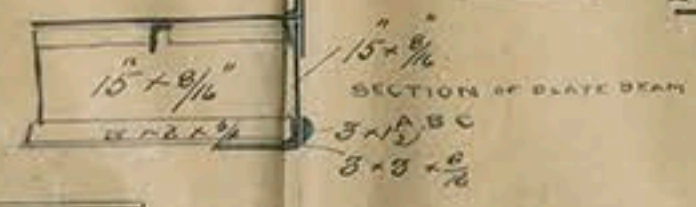

N. N. O'Leary

W. C. O'Leary Robert No. 12, 913

W. C. O'Leary Robert No. 12, 913

12938

13245

13403

Matthias

W. C. O'Leary Robert No. 12, 913

LLOYD'S REGISTER OF SHIPPING
REGISTERED
29 NOV. 94
LONDON

LLOYD'S REGISTER OF SHIPPING
REGISTERED
20 MAR. 94
LONDON

LLOYD'S REGISTER OF SHIPPING
REGISTERED
20 DEC. 95
LONDON

LLOYD'S REGISTER OF SHIPPING
REGISTERED
29 AUG. 95
LONDON

ETAIN



© 2018

Lloyd's Register
Foundation