

LENGTH B.P. 220'0" BREADTH Ex. 32'6" DEPTH MLD 16'1 1/2"

SINGLE DECK TYPE

1/2" SCALE.

LLOYDS NUMERALS

DEPTH ----- 16.79

1/2 GIRTH ----- 30.33

1/2 BREADTH-----16-16

63.28 1st N^o.

218' LLOYDS LENGTH

13795 2nd N:


GRADES 1st N^o 61-65.

2nd N° 13100-13900

DEPTH TO LENGTH 12.98 12 TO 13

BREADTH TO LENGTH 6.74 6-7

EQUIPMENT N° 14535 GRADES 13450-15120

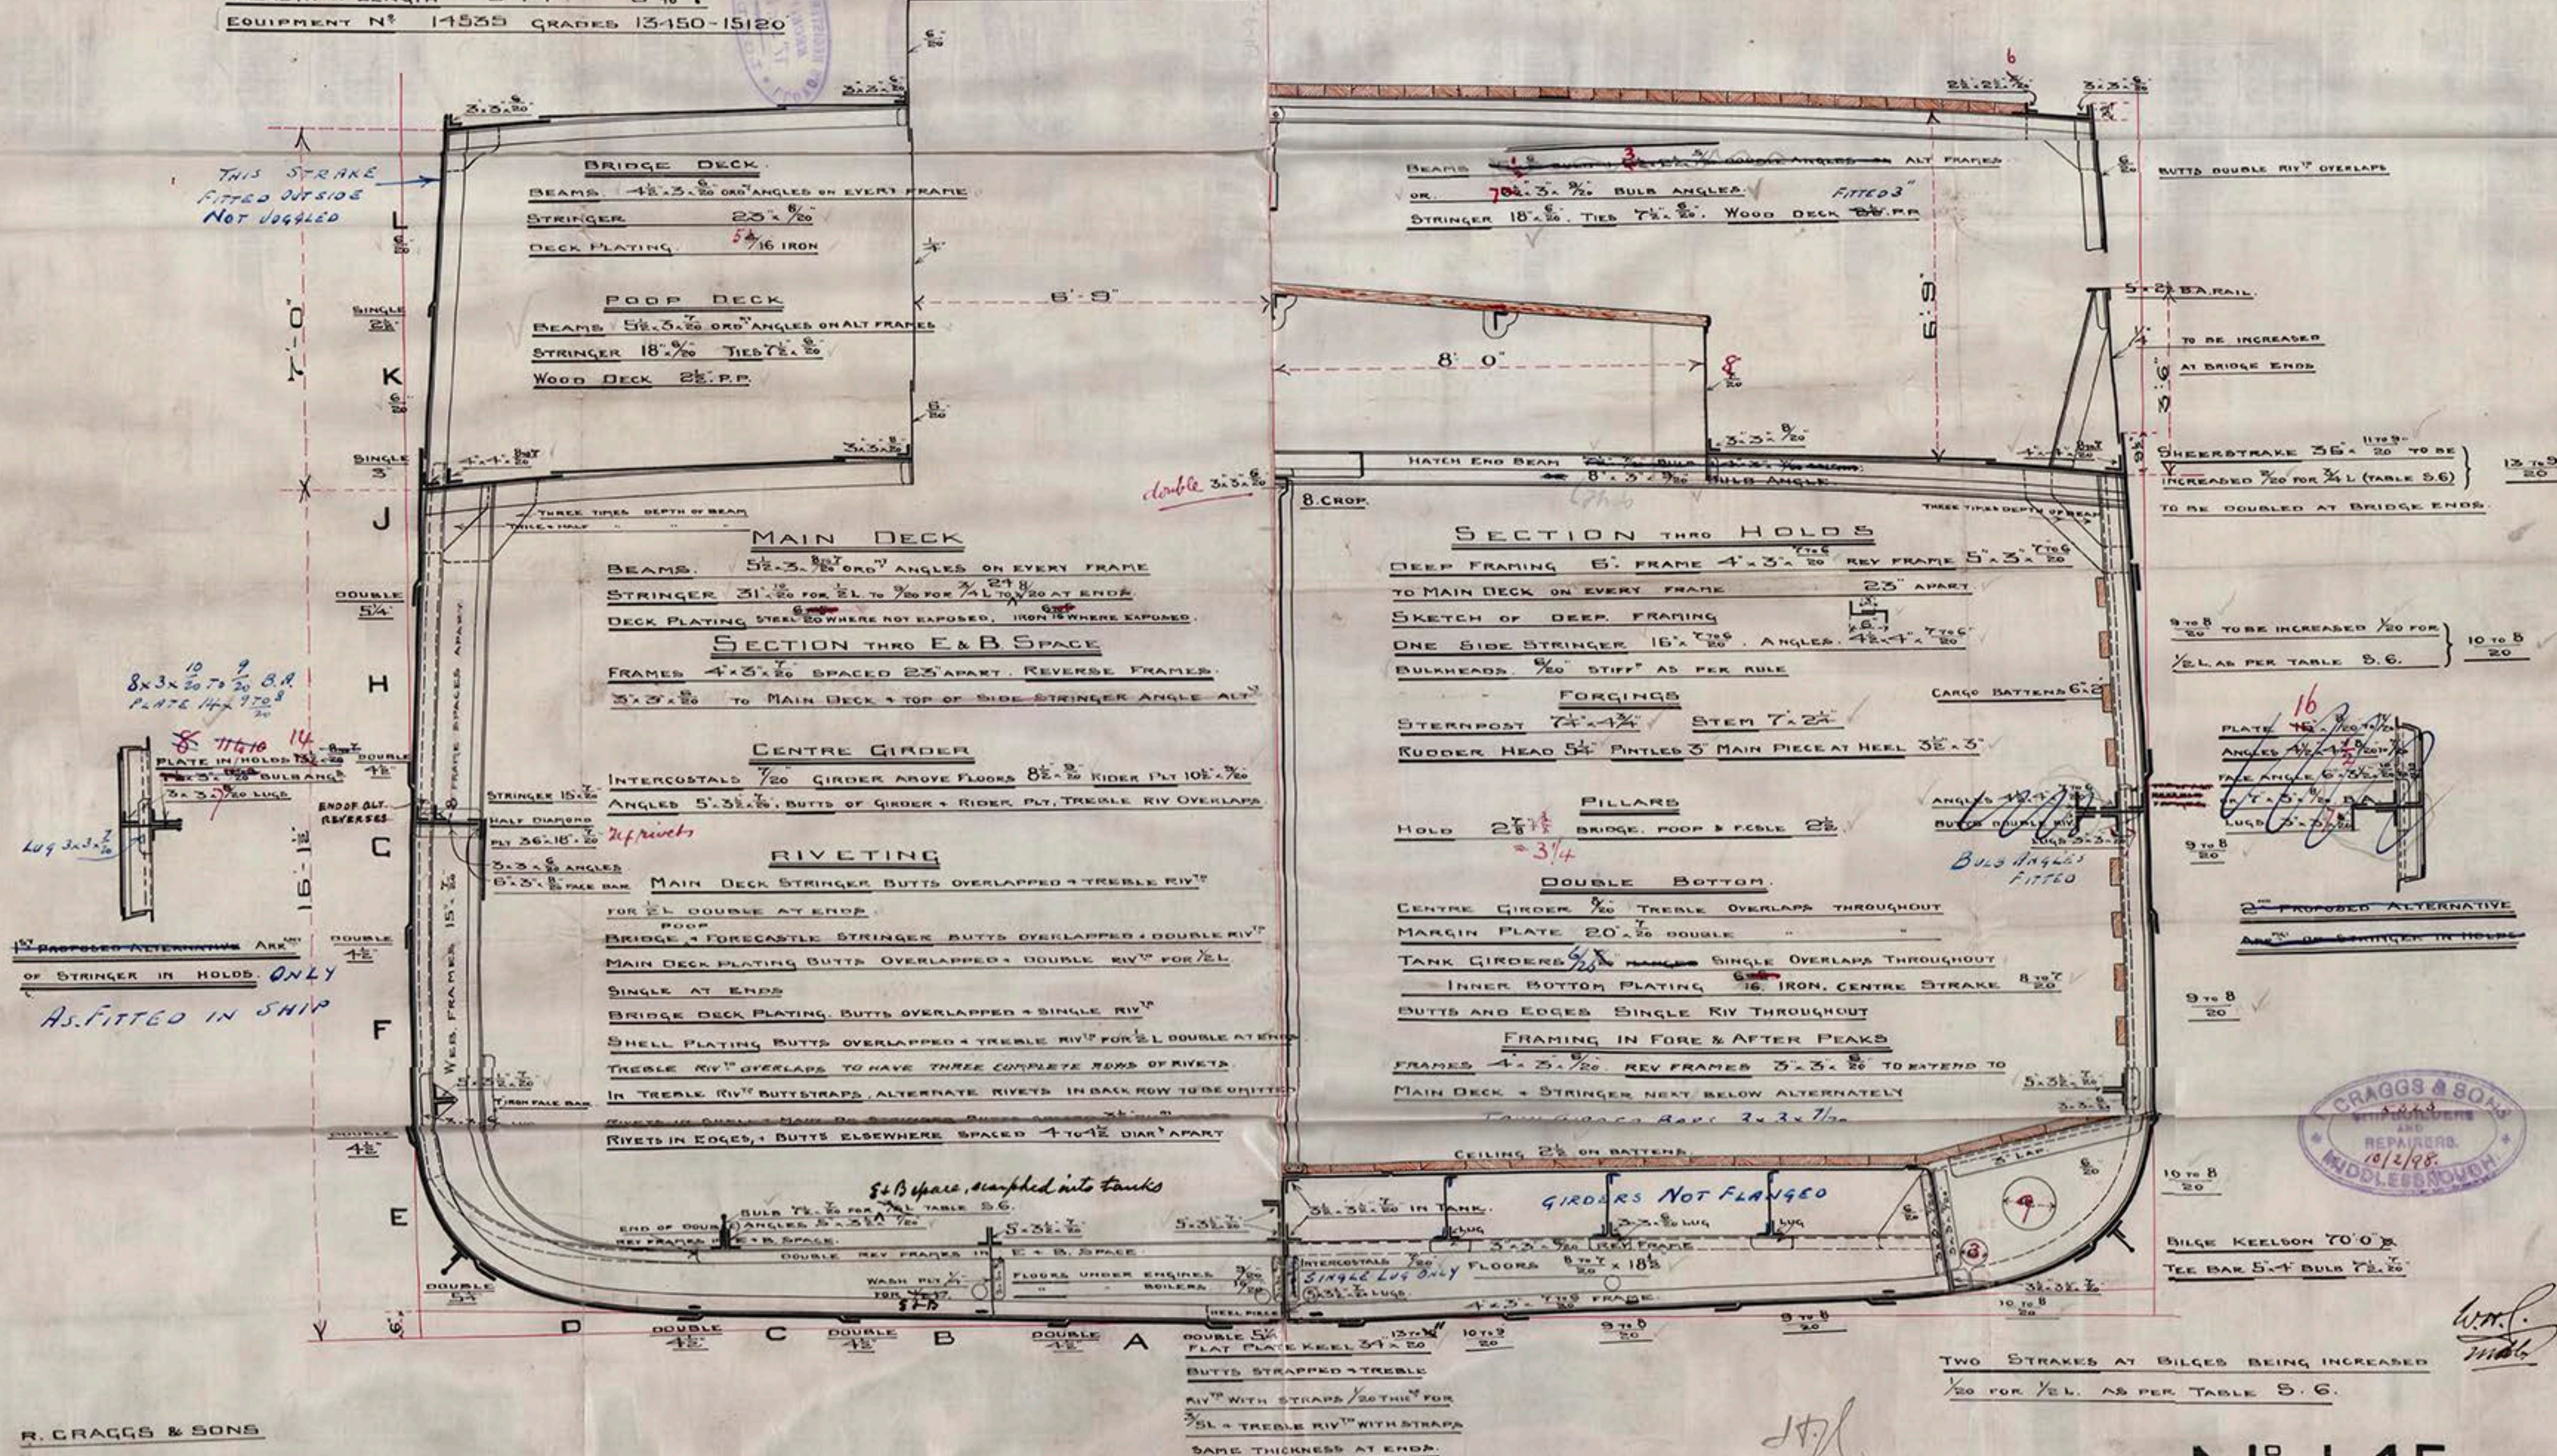

R. CRAGGS & SONS
TEES DOCKYARD
MIDDLESBROUGH-ON-TEES

Nº 145

MIDSHIP SECTION

TO CLASS 100A1 AT LLOYD'S

SINGLE DECK TYPE

1/8" SCALE

LR PAF-TB-2-0-43



1		