

MIDSHIP SECTION

— S S No 379 —


SCALE $\frac{1}{2}$ INCH = 1 FOOT.

$$\text{Dim}^S 195'0 \times 29'11 \times 13'6 \text{ ML}^D$$


QUARTER DECK 103'0" x 4'0"

- EQUIPMENT. -

| | |
|-----------------|--------------------------------------|
| 2 POWER ANCHORS | 10 CHAIN STAPLES |
| 1 - | 10 1/2 - |
| 1 STREAM | 5 1/2 - |
| 1 KEDGE | 2 1/2 - |
| 210 FATHOMS | 1 1/2 STUD CHAIN CABLE |
| 60 - | 1 1/2 STREAM CHAIN OR 3/4 STEEL WIRE |
| 75 - | 6 HAWSER OR 3 STEEL WIRE |
| 90 - | 8 AND 5 HANSERS AND WARPS |

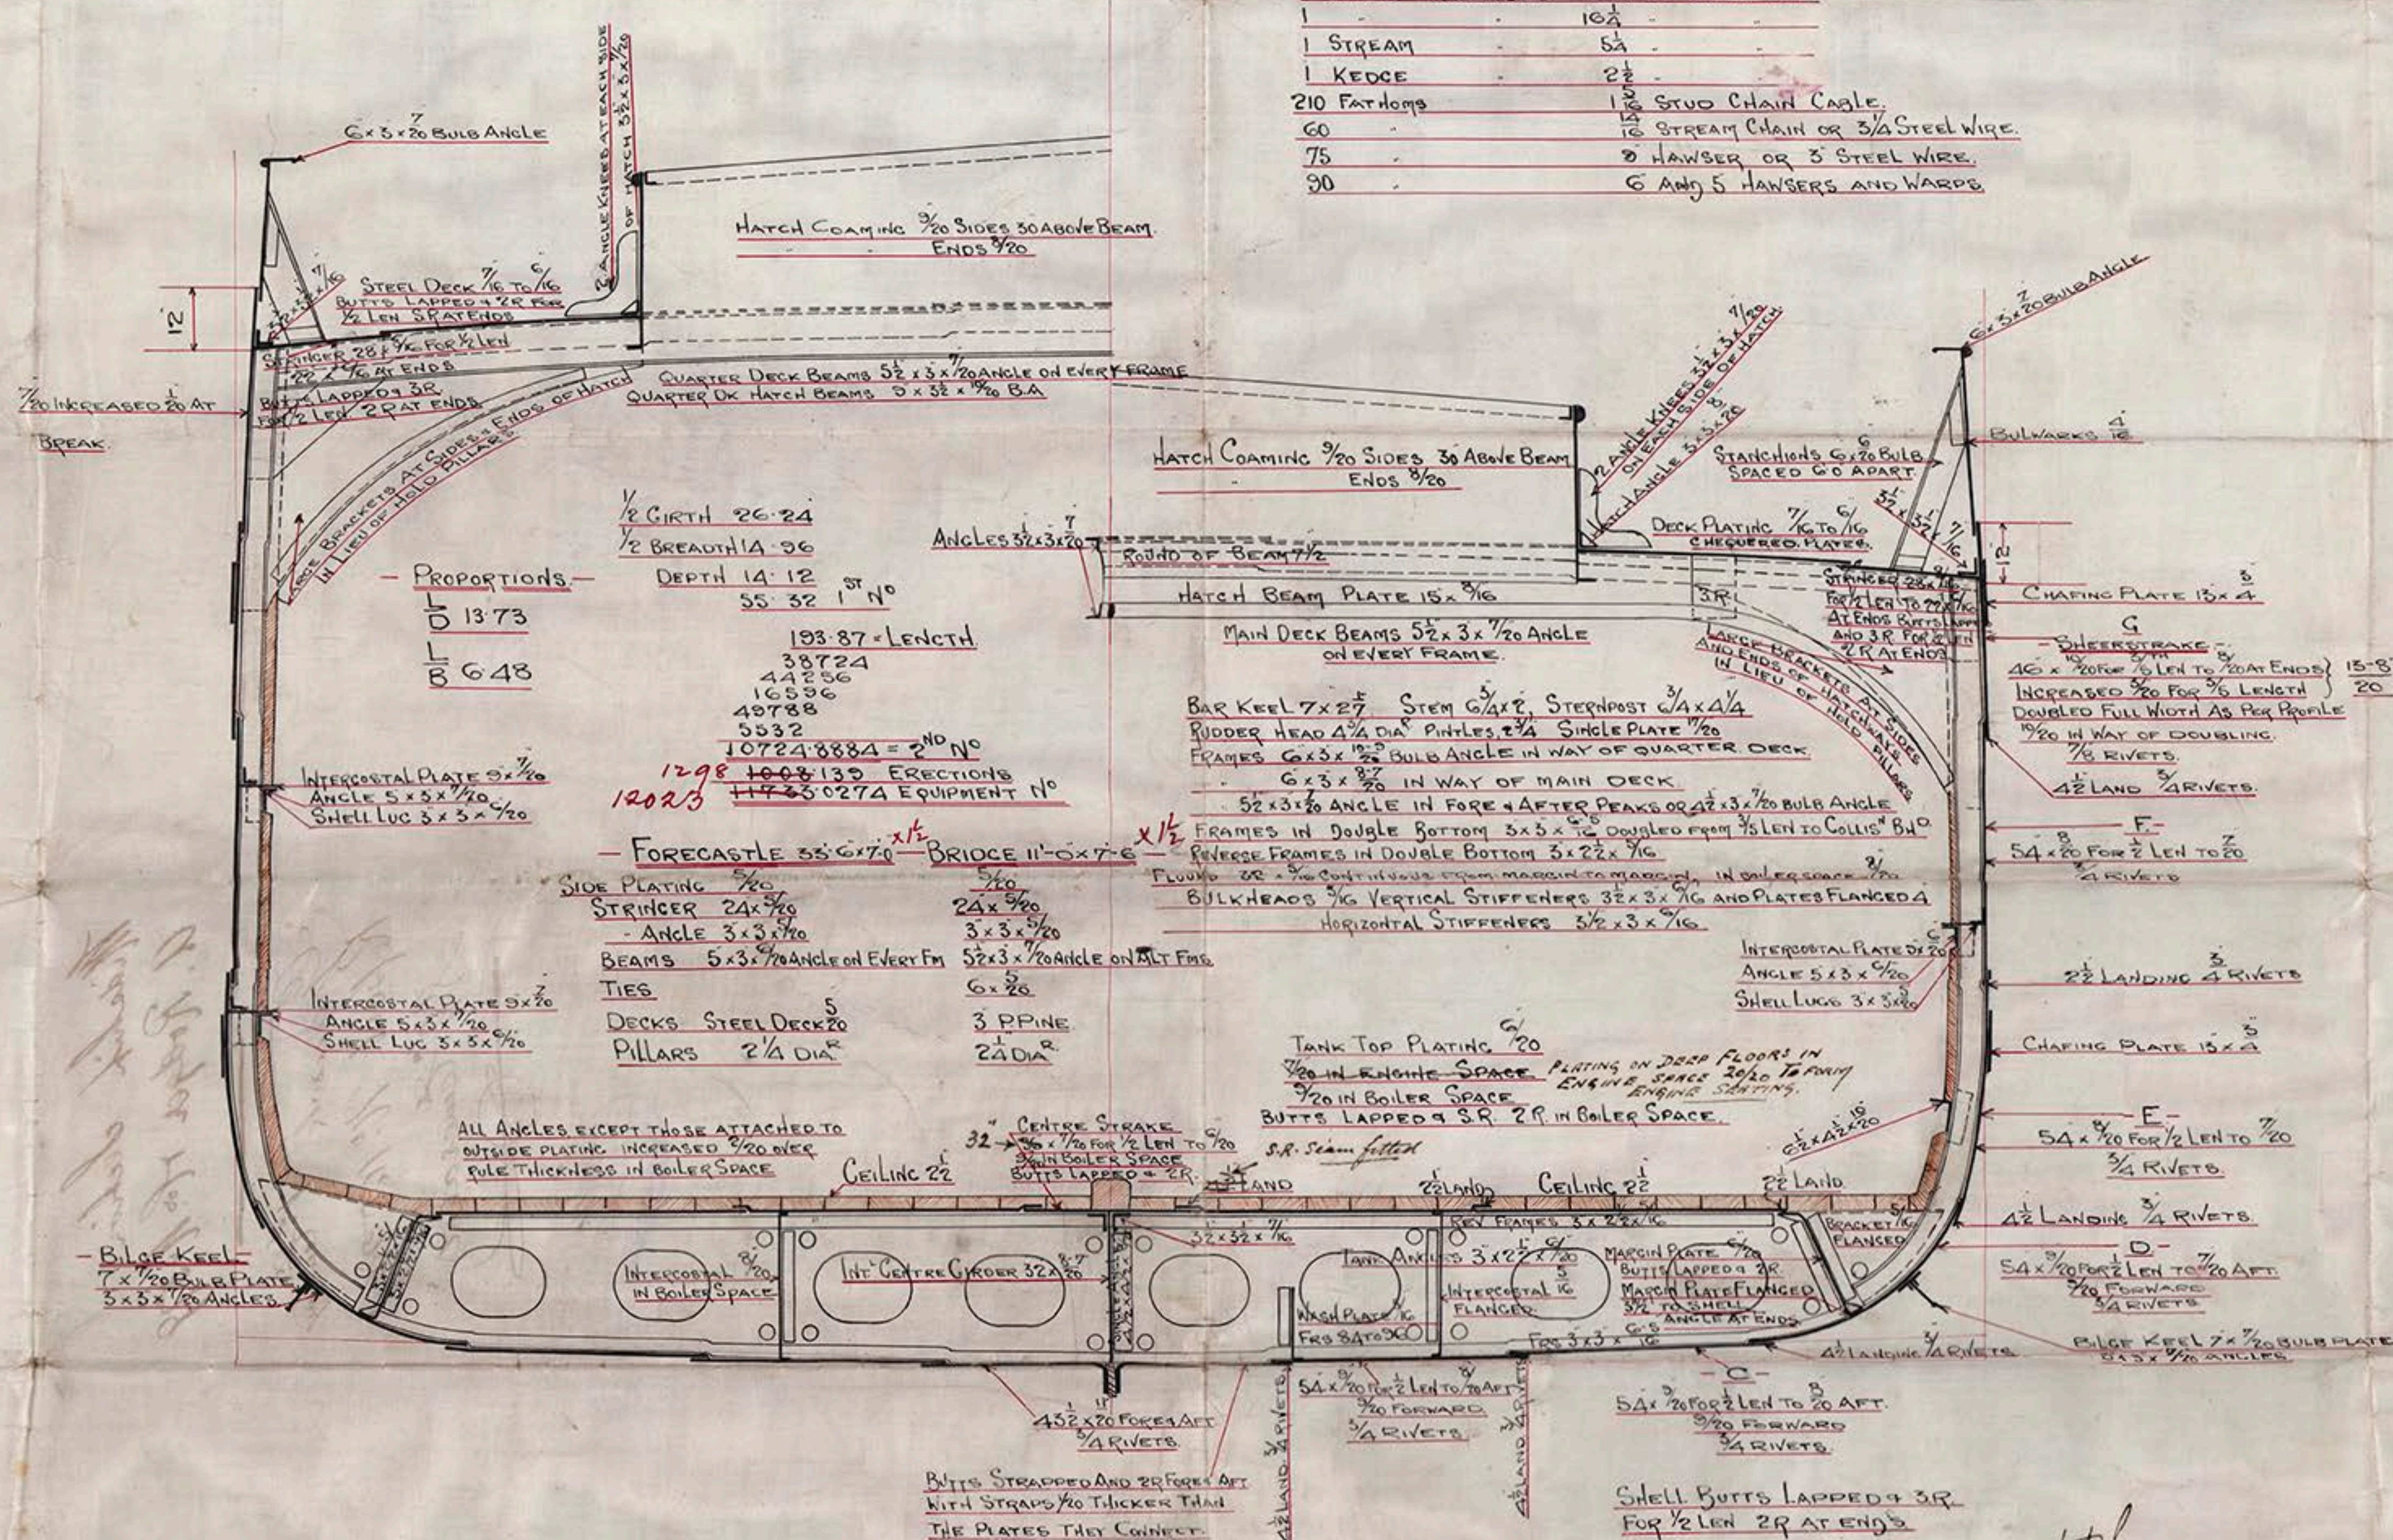


J.T.H.
5/3/04

Midship Section
A. Rodger No. 379

Greenock 1st Entry
Report N^o. 14098.

Ed. Emerald

Billars 5/4 Dir.
Decks 21/11 Dir.
Lies 2
Pewas 23/10/11 Dir.

36614E
34D1C