

9691



3/5 "EMERALD" Lon 110594

STEERING ARRANGEMENT

SCALE 1/4" = 1'-0"


SHEAVES 12" INSIDE DIA. PINS 3/8" DIA. 3/4" ✓  
 CHAINS TO SUIT SPROCKET BUT NOT LESS THAN 3/4" DIA.  
 RODS 13/16" DIA.

CHAINS OF B.B.B. CHAIN TO LLOYD'S TEST WITH CERTIFICATE.

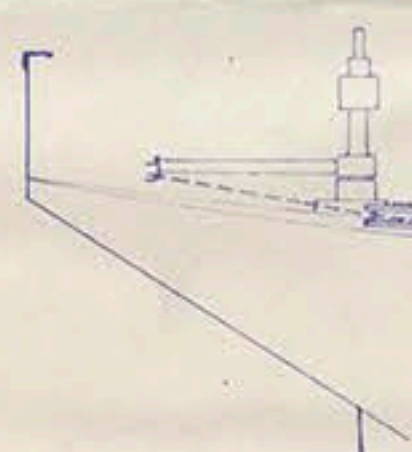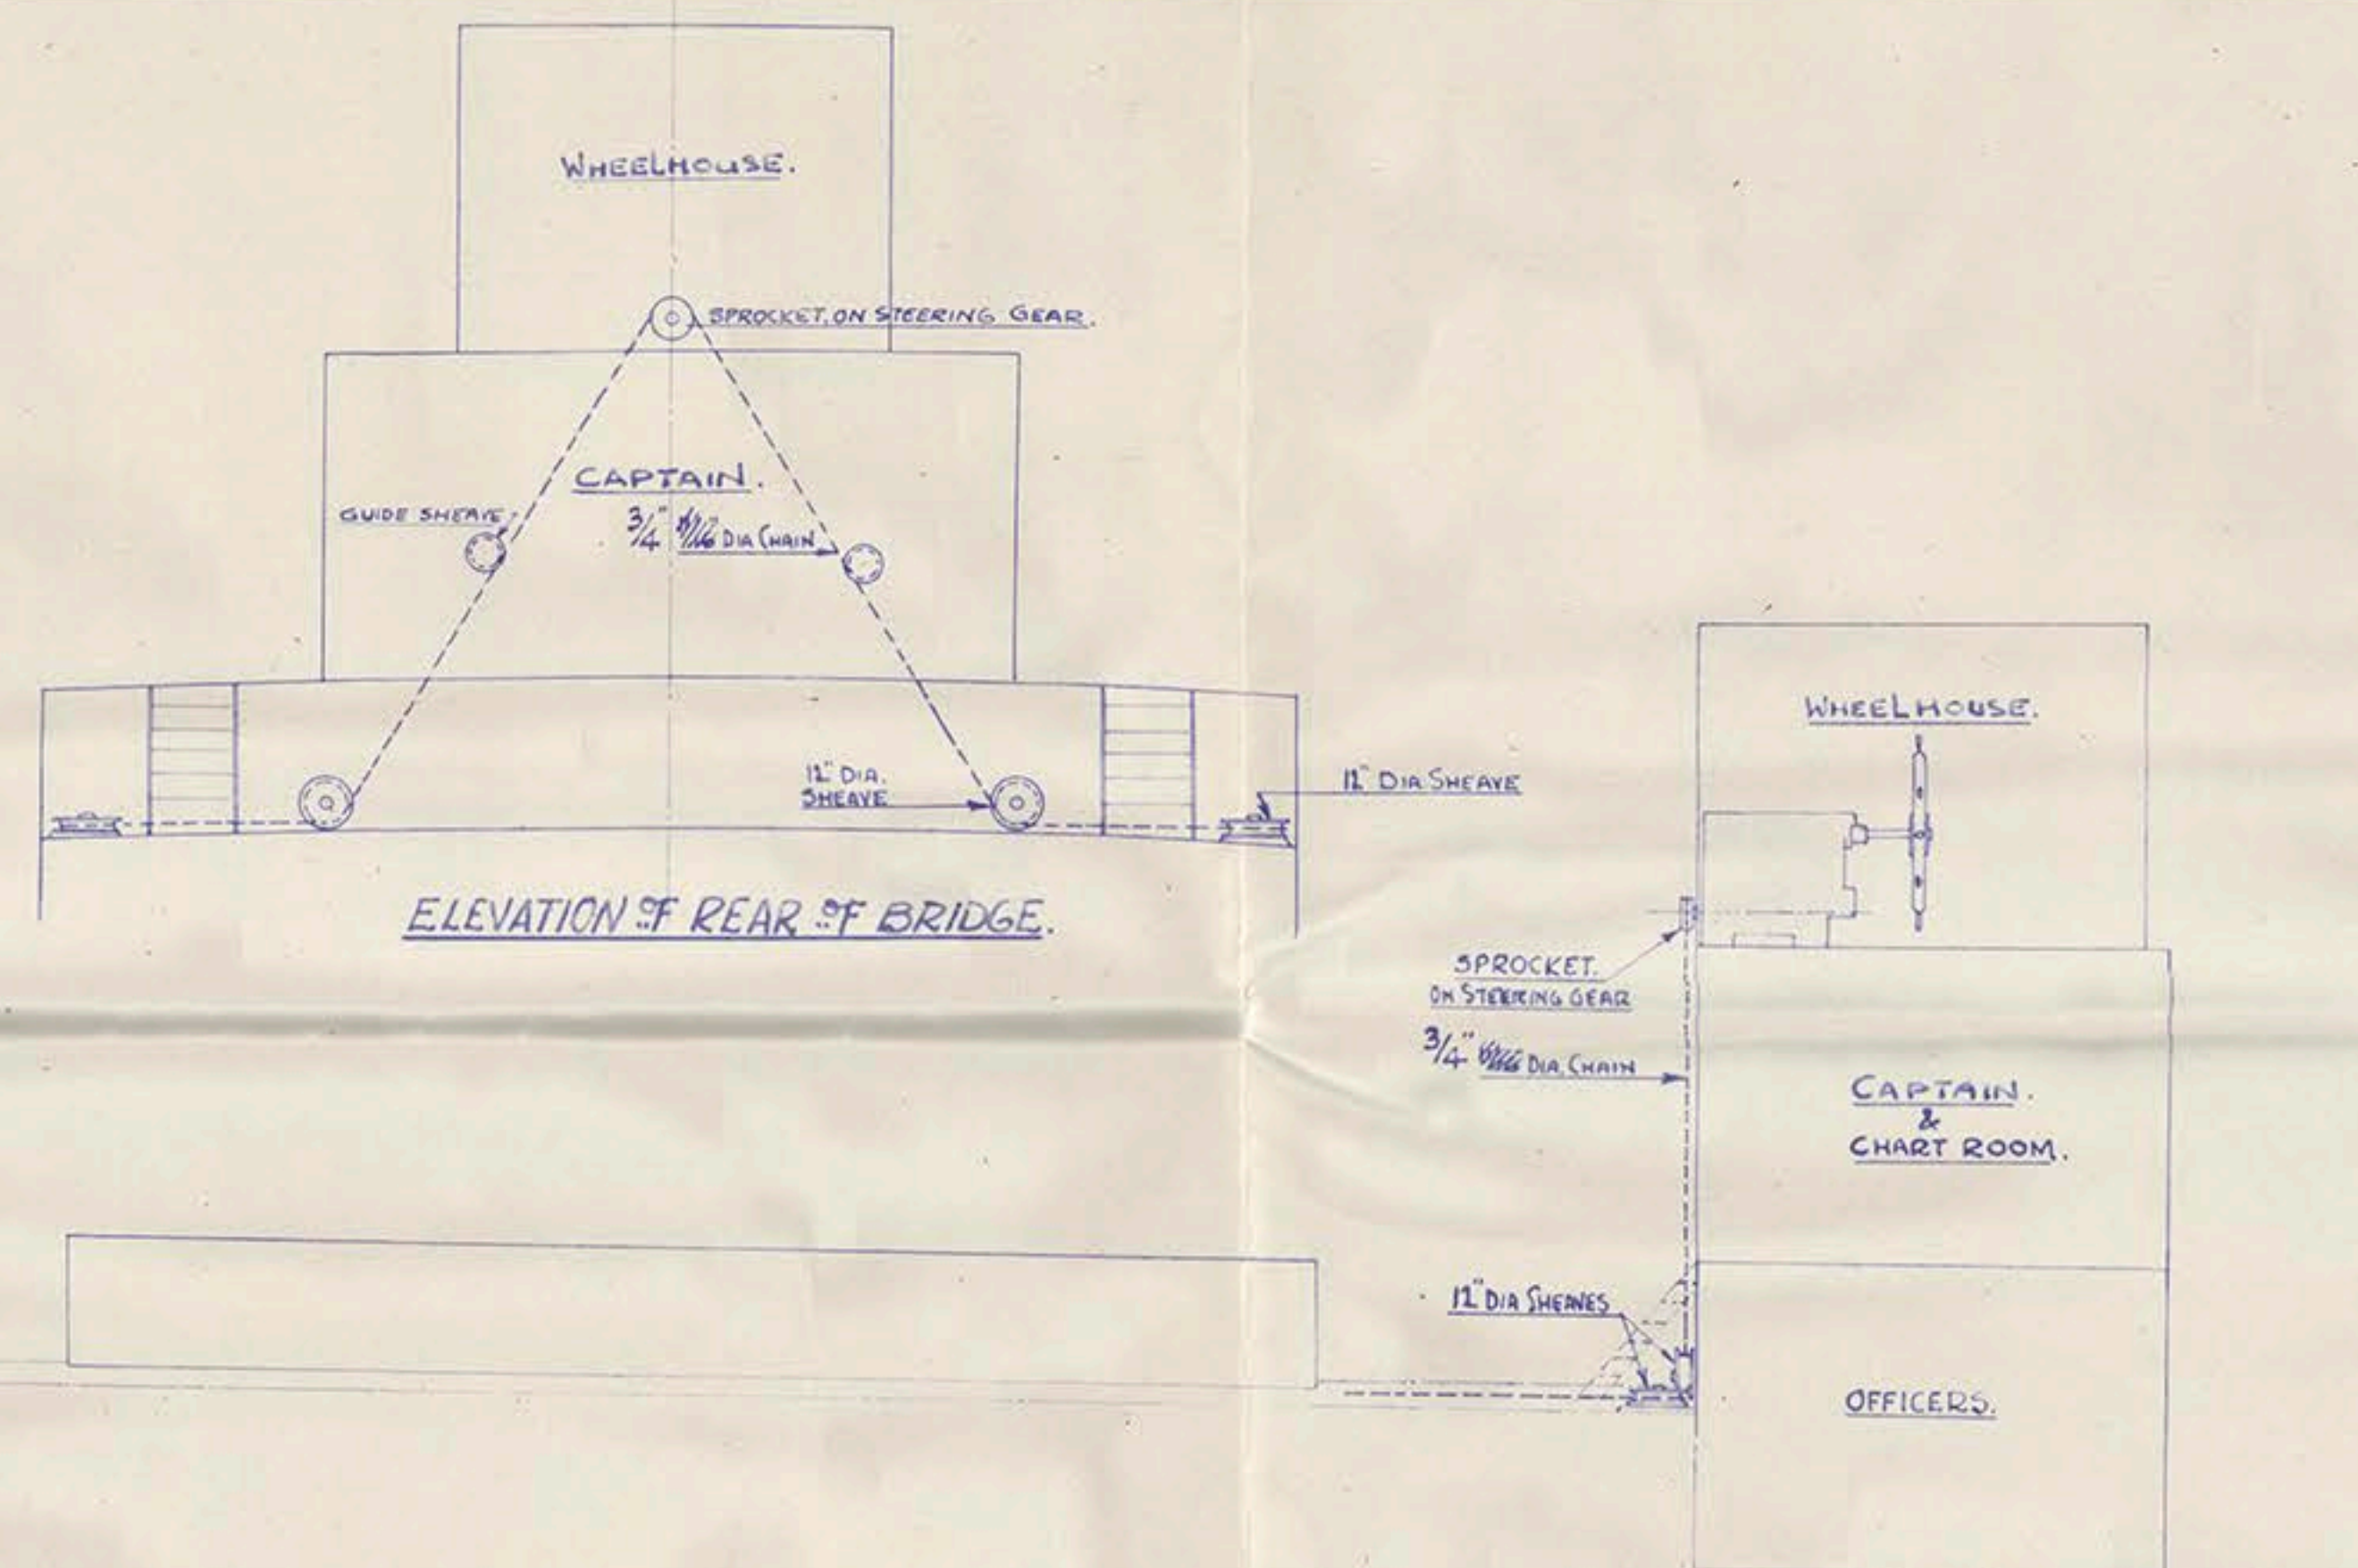

EXISTING FITTINGS AFT  
 TO BE RE-USED.

EXACT LENGTHS OF CHAINS & RODS TO BE DETERMINED AT SHIP.  
 GUIDE BLOCKS ARRANGED AS NECESSARY.

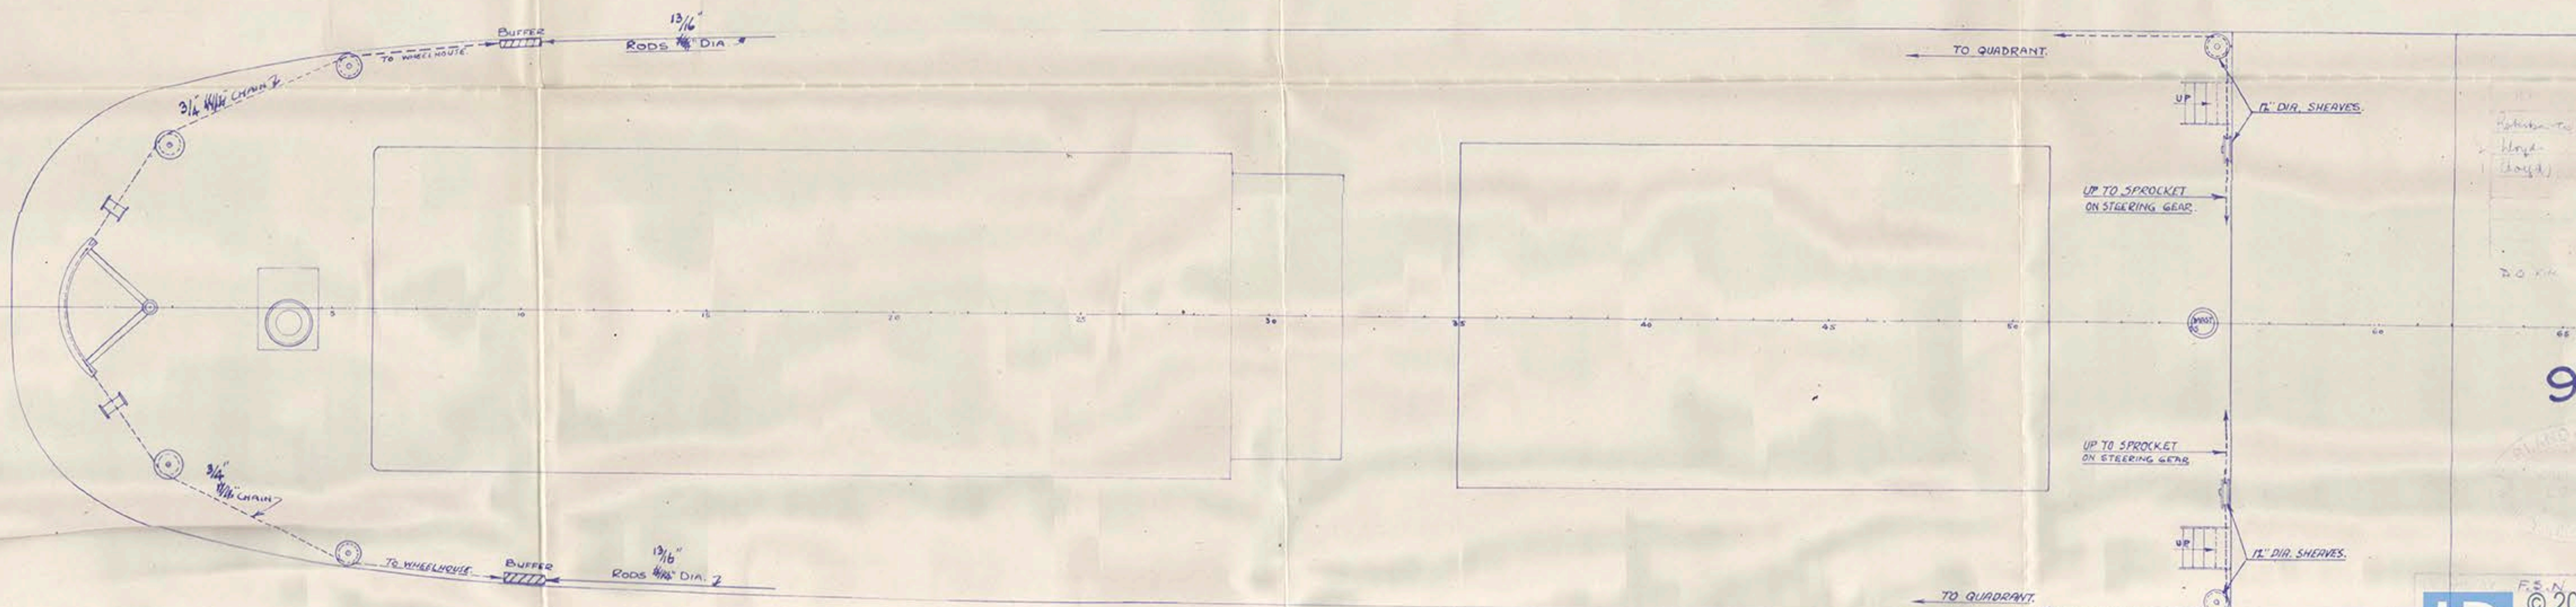

9691