


9696.

1/5" EMERALD LIFEBOAT ARRANGEMENT.

SCALE 1/4"=1'-0"

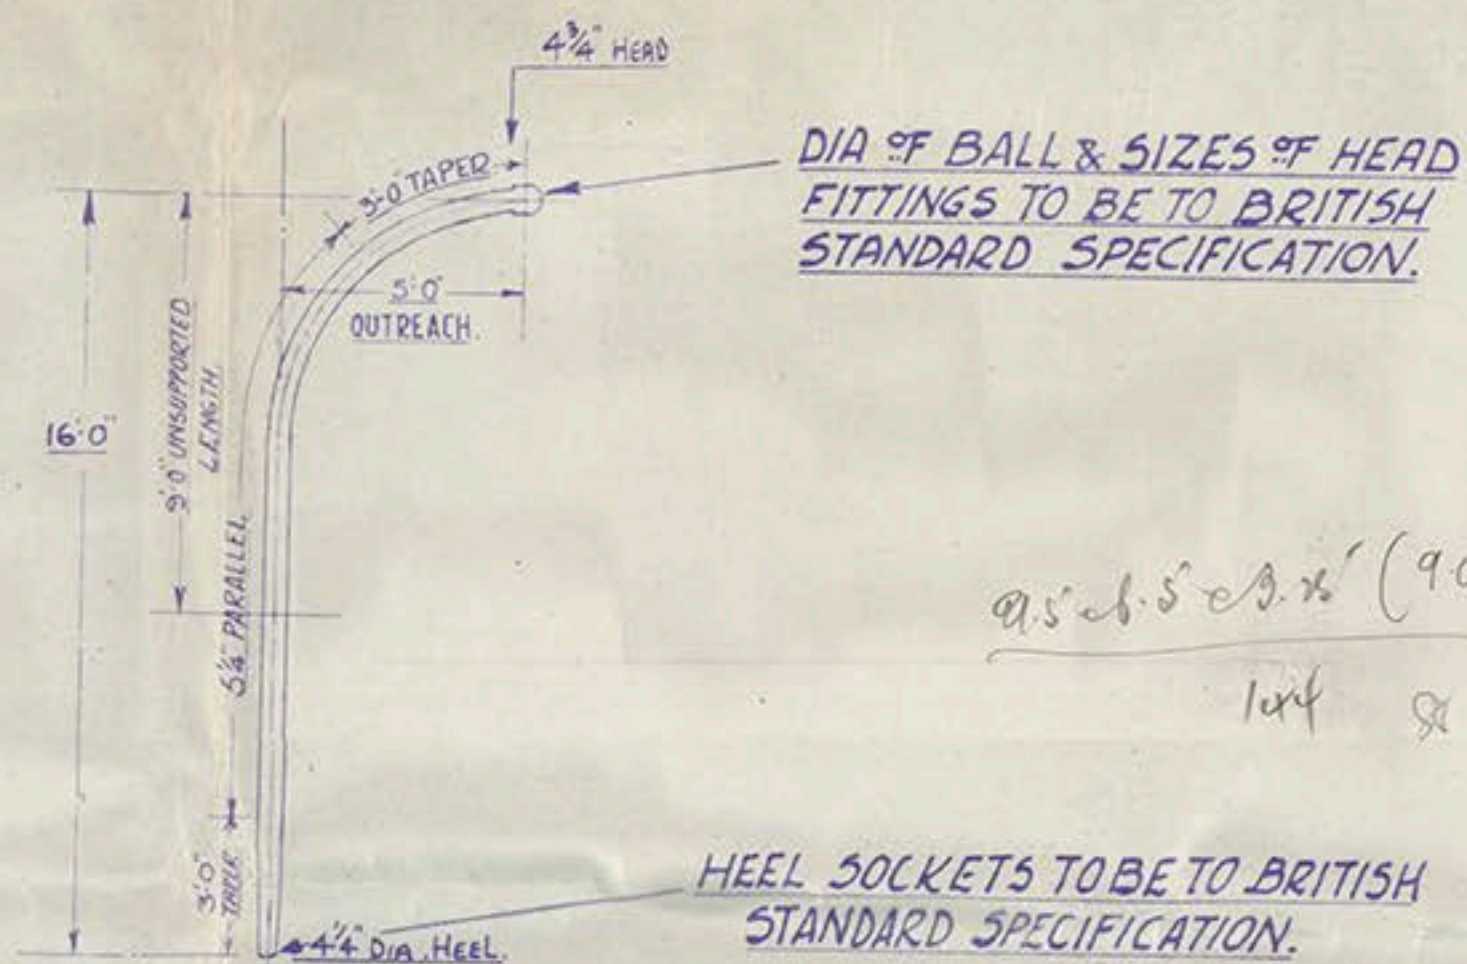

9.5' x 5' x 1/2" (90 + 20)

1 x 4

HEEL SOCKETS TO BE TO BRITISH STANDARD SPECIFICATION.

20'-0" P&S.

POSITION FOR 21'-6" LIFEBOAT.

LIFERAFT TO BE
ARRANGED IN THIS
POSITION.

E.R. SKYLIGHT.

GUNNERS'
ACCOMMODATION.

COAL

SHOOT.

21'-6" x 6'-6" x 3'-3"


21'-6" LIFEBOAT (P.R.S.)

6"x3" ANGLE SKID.

5"x4" TEE BAR SKIDS.

EXISTING WORKING BOAT.

12'-0"

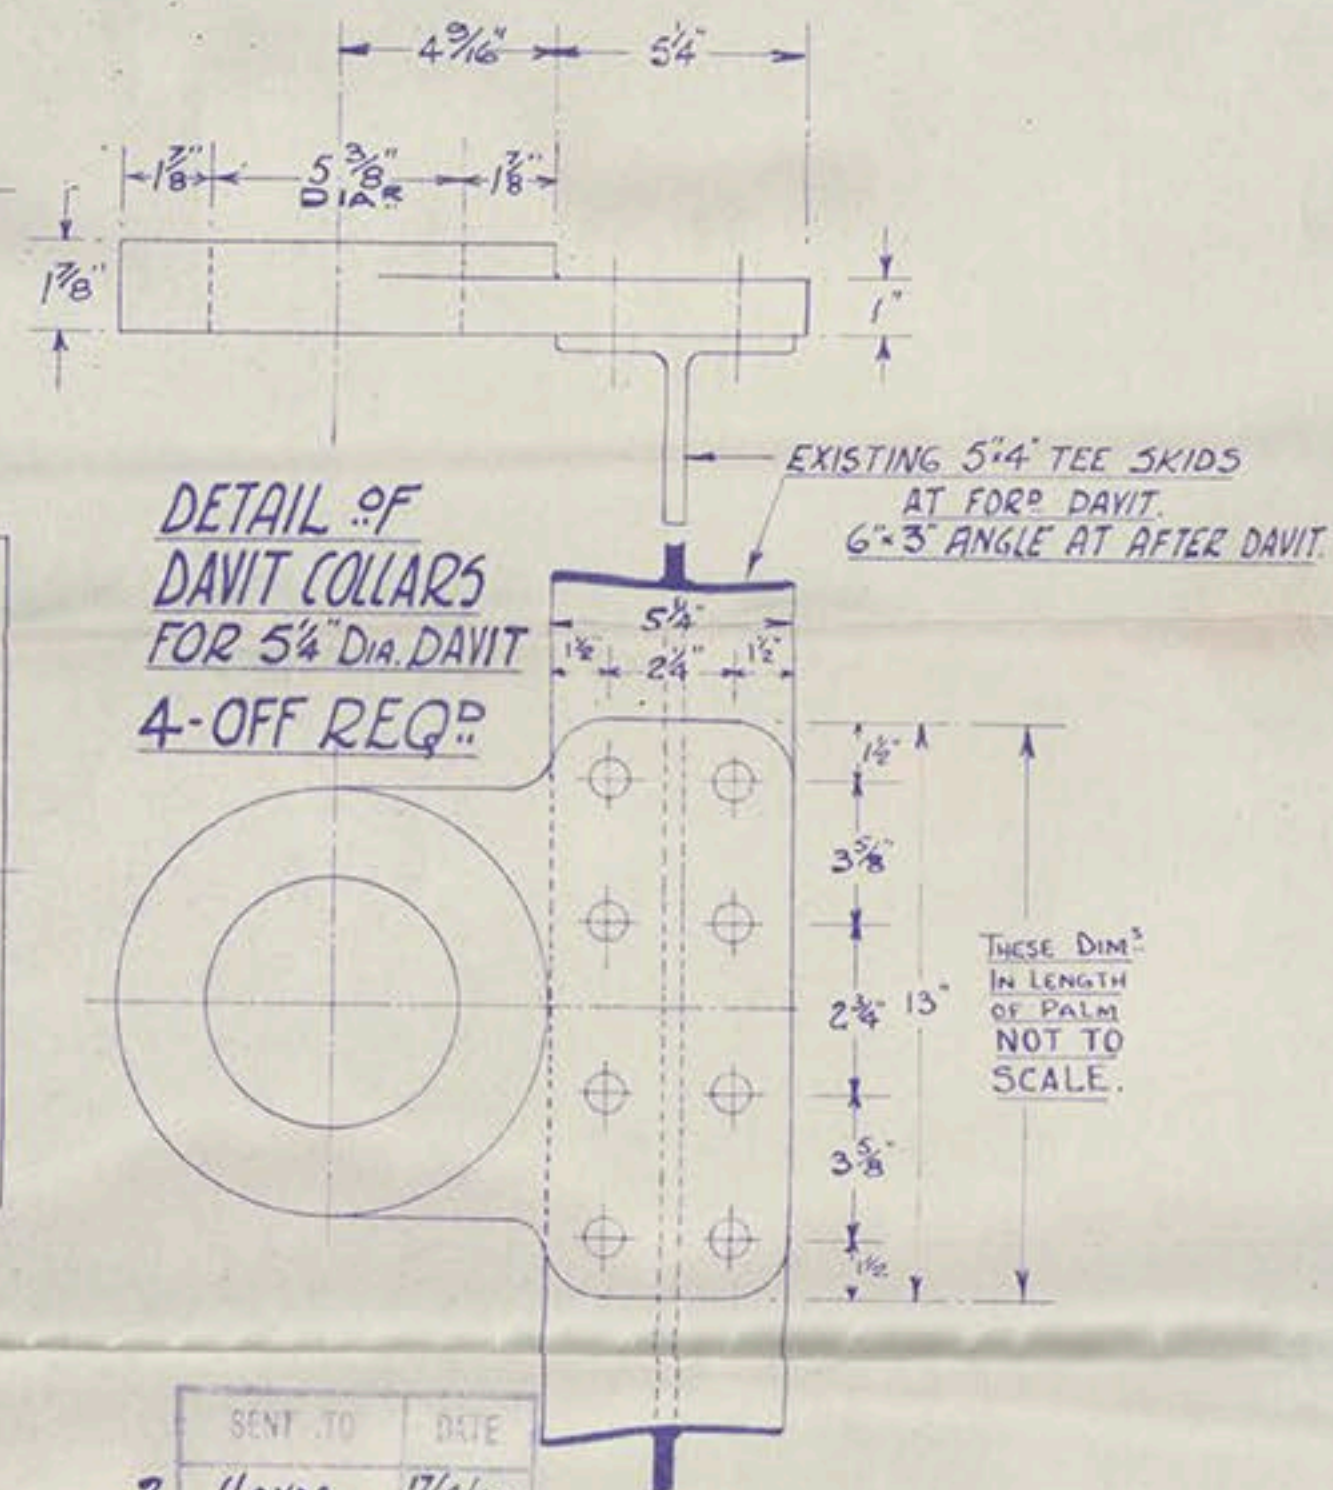

SENT TO	DATE
2 Lloyd's	17/4/42.

9696.

DRAWN BY... F.S.N. DATE 17/4/42.

CHECKED BY...

APPROVED BY...

FILED...



© 2018
Lloyd's Register
Foundation

approved for Standards
of Davits.

17.4.42

EMERALD

Lifeboat Arrangement

Lon 110594



© 2018

Lloyd's Register
Foundation

LR-FAF-TS22-P-18