

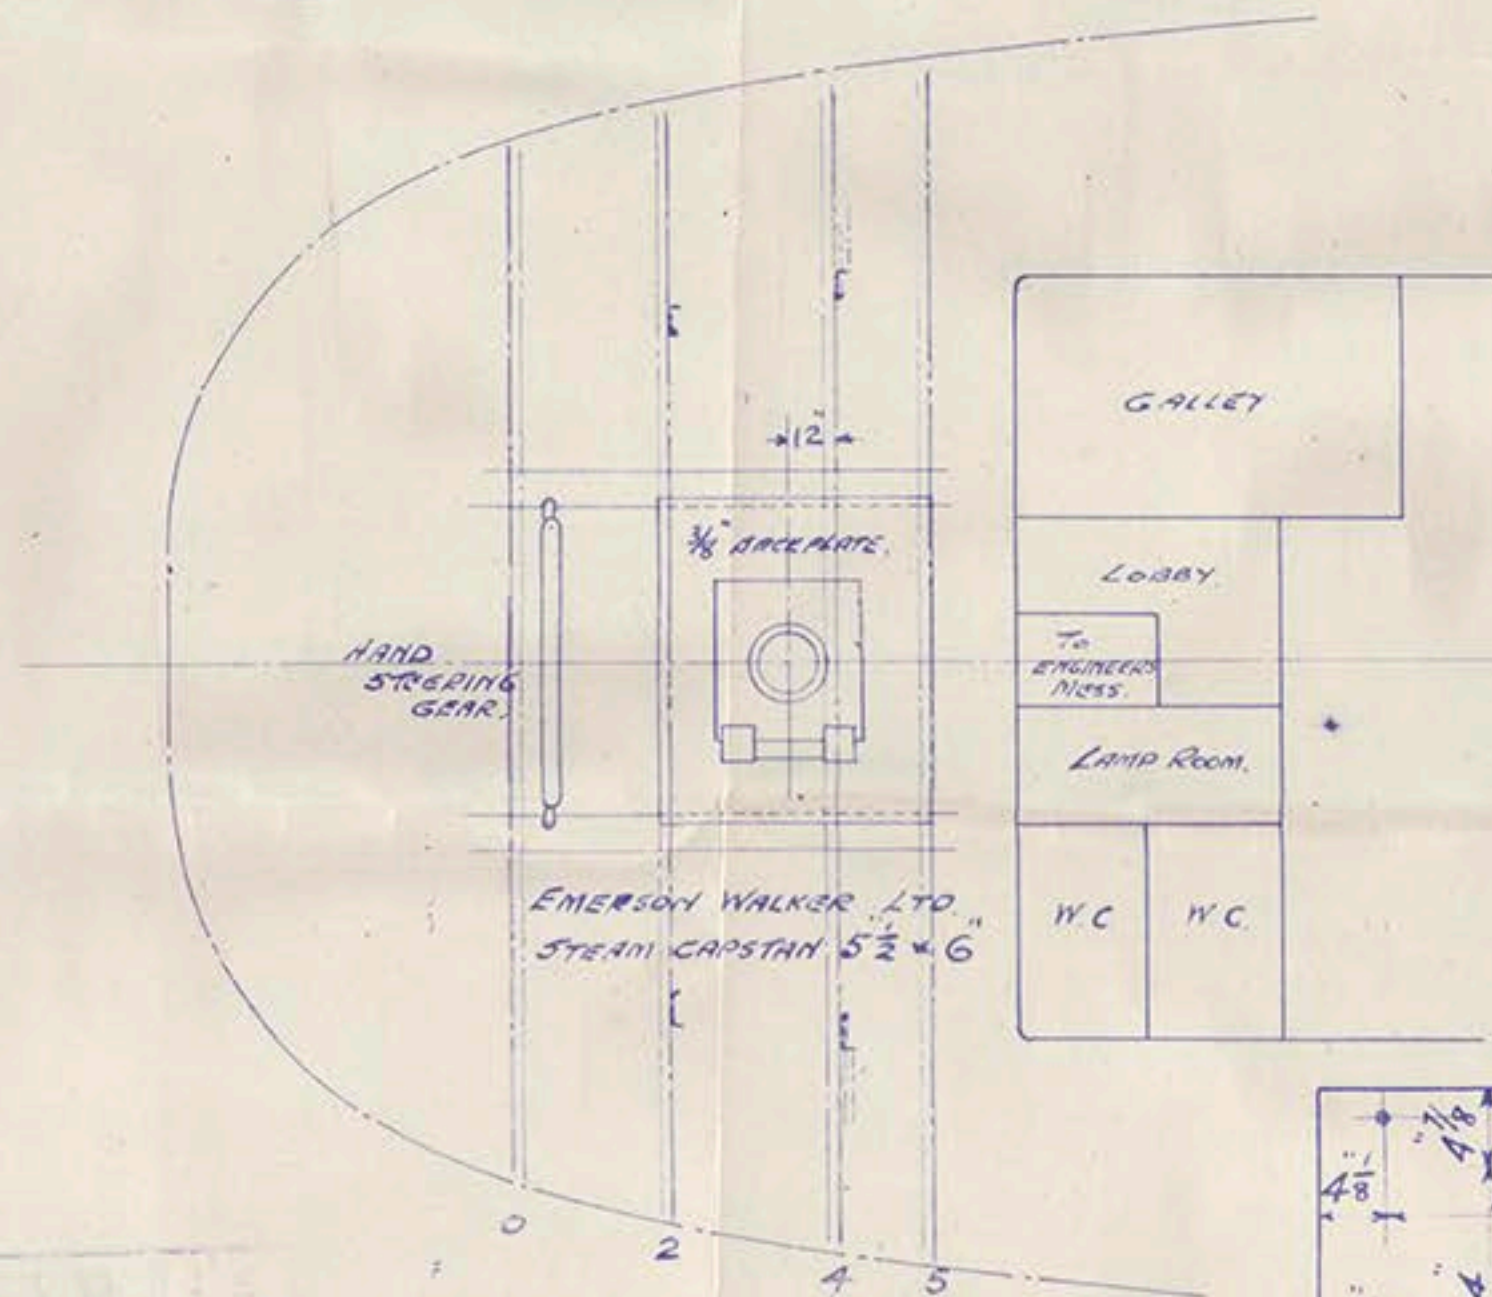


" <sup>Lon. 1105 9/16</sup>  
 S.S. EMERALD / 102.  
 CAPSTAN ENGINE SEATING.



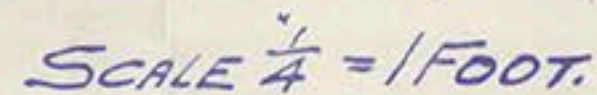


00 FILE 27442

BEDPLATE.  
1" = 1 FOOT.

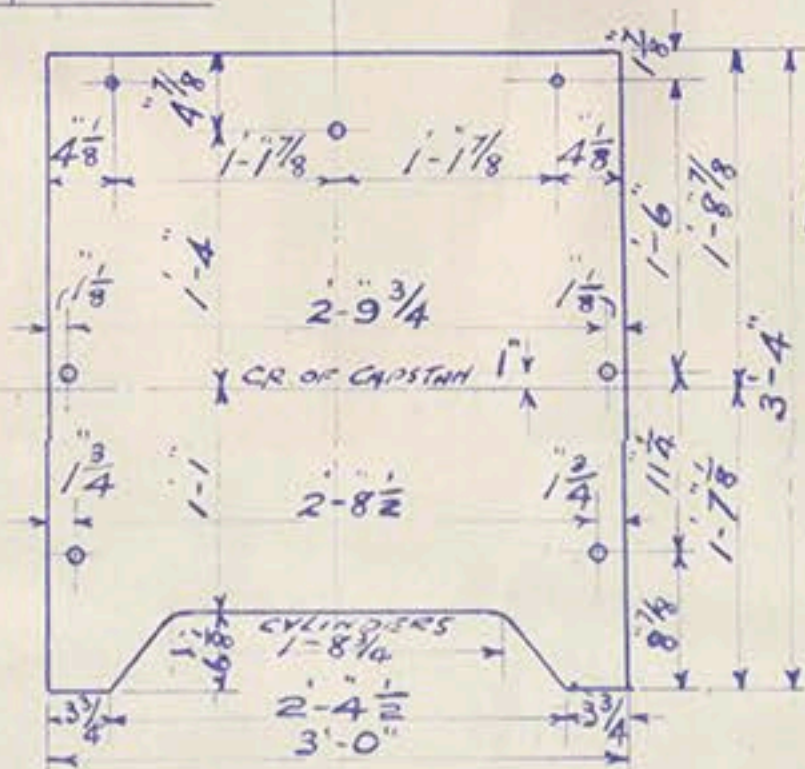

SCALE  $\frac{1}{2}$ " = 1 FOOT.

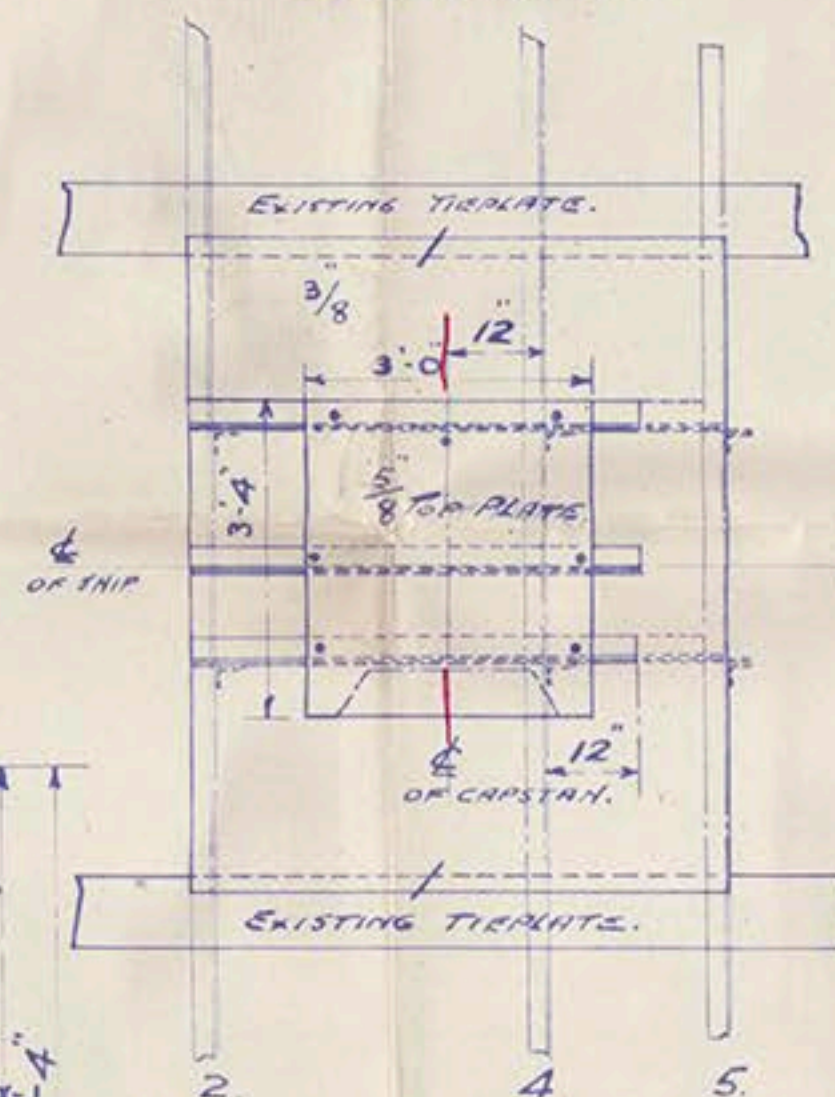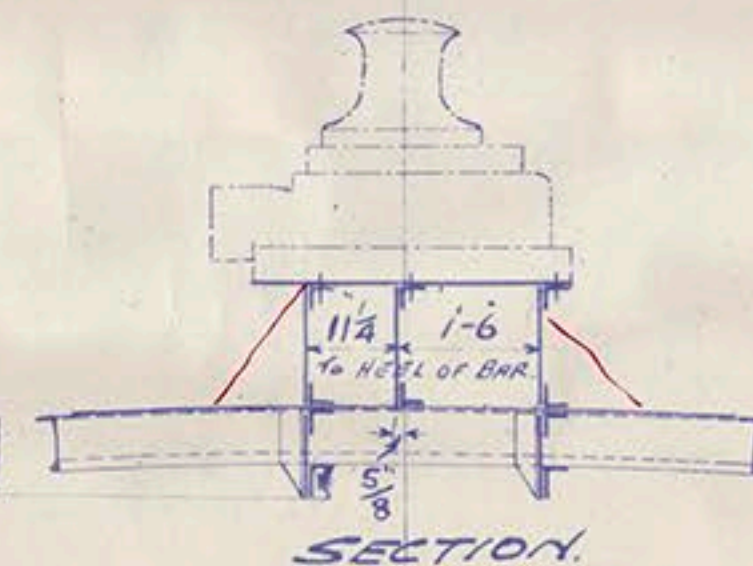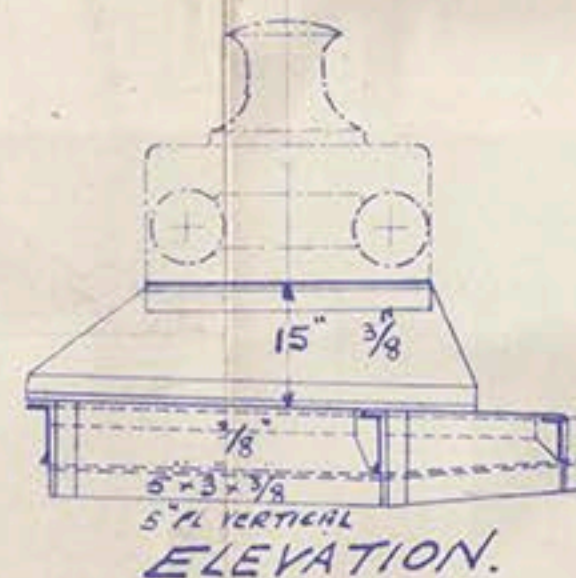

ALL ANGLES & LUGS  $3 \times 3 \times \frac{3}{8}$   
EXCEPT WHERE OTHERWISE MARKED.

ACTUAL POSITION OF HOLDING DOWN  
BOLTS TO BE TAKEN FROM BEDPLATE  
BY TEMPLATE.

MATERIAL FROM STOCK.

9717

HB 274-42

© 2018

Lloyd's Register  
Foundation

