
T.S.S.s Nos ~~442~~ -3

MIDSHIP SECTION.

DIMENSIONS L.B.P. 550'-0" x 65'-6" B.M. x 40'-0" D.M.

CLASS 100. A.1. LLOYDS 3 AND SHELTER DK. RULE.

SCALE 1/2" = 1 FOOT.

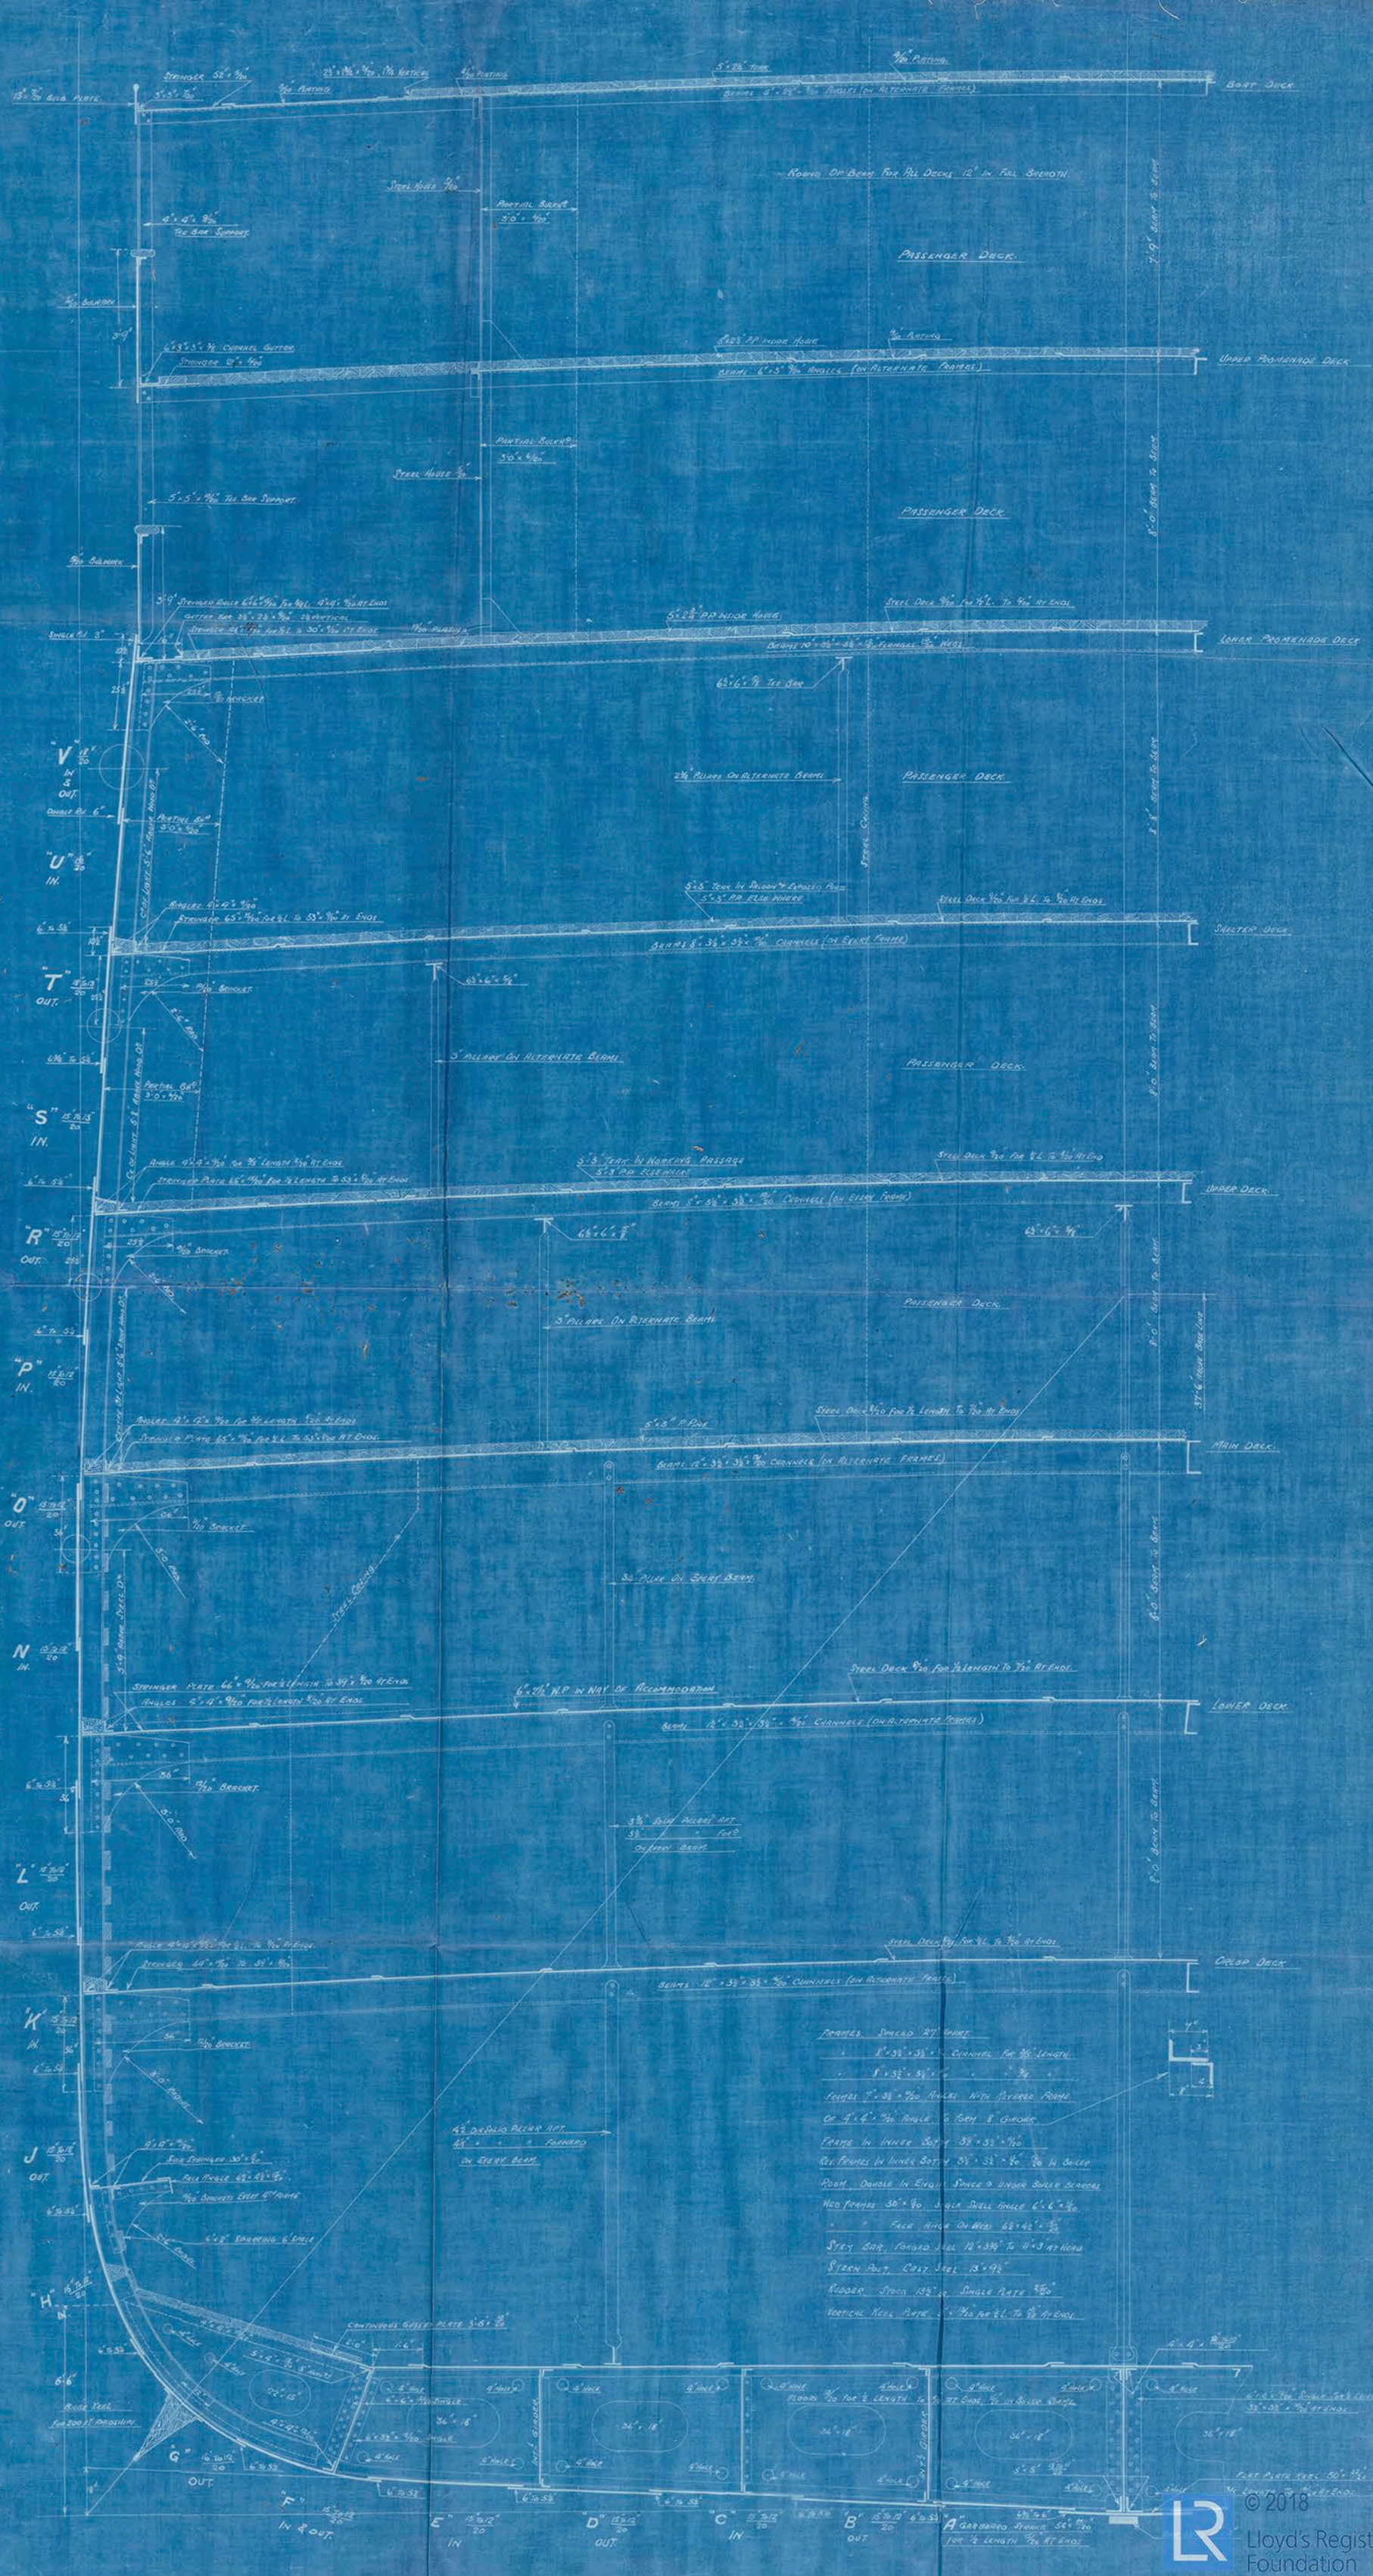

THE FAIRFIELD SHIPBUILDING & ENGINEERING CO. LTD. GOVAN GLASGOW
SHIP DRAWING OFFICE
No. 13274
EXAMINED BY
15 JUN 1928
Lloyds.

© 2018
Lloyd's Register Foundation

LLOYD'S REGISTER OF SHIPPING
RECEIVED

The Fairfield S.B. 1760

T. S. S. No 443

Empress of Ireland

Gls. rht. No. 24118

Midship section

as built.

RETAIN

© 2018
Lloyd's Register Foundation
LR-FAF-T022-1-33