


29.1.08

PLAN OF MAIN DECK SHOWING PROPOSED ALTERNATIVE METHOD

OF COMPENSATION FOR COAL SHOOT OPENINGS IN STRINGER

Nº 472

SCALE  $\frac{1}{8}'' = 1 \text{ FOOT.}$

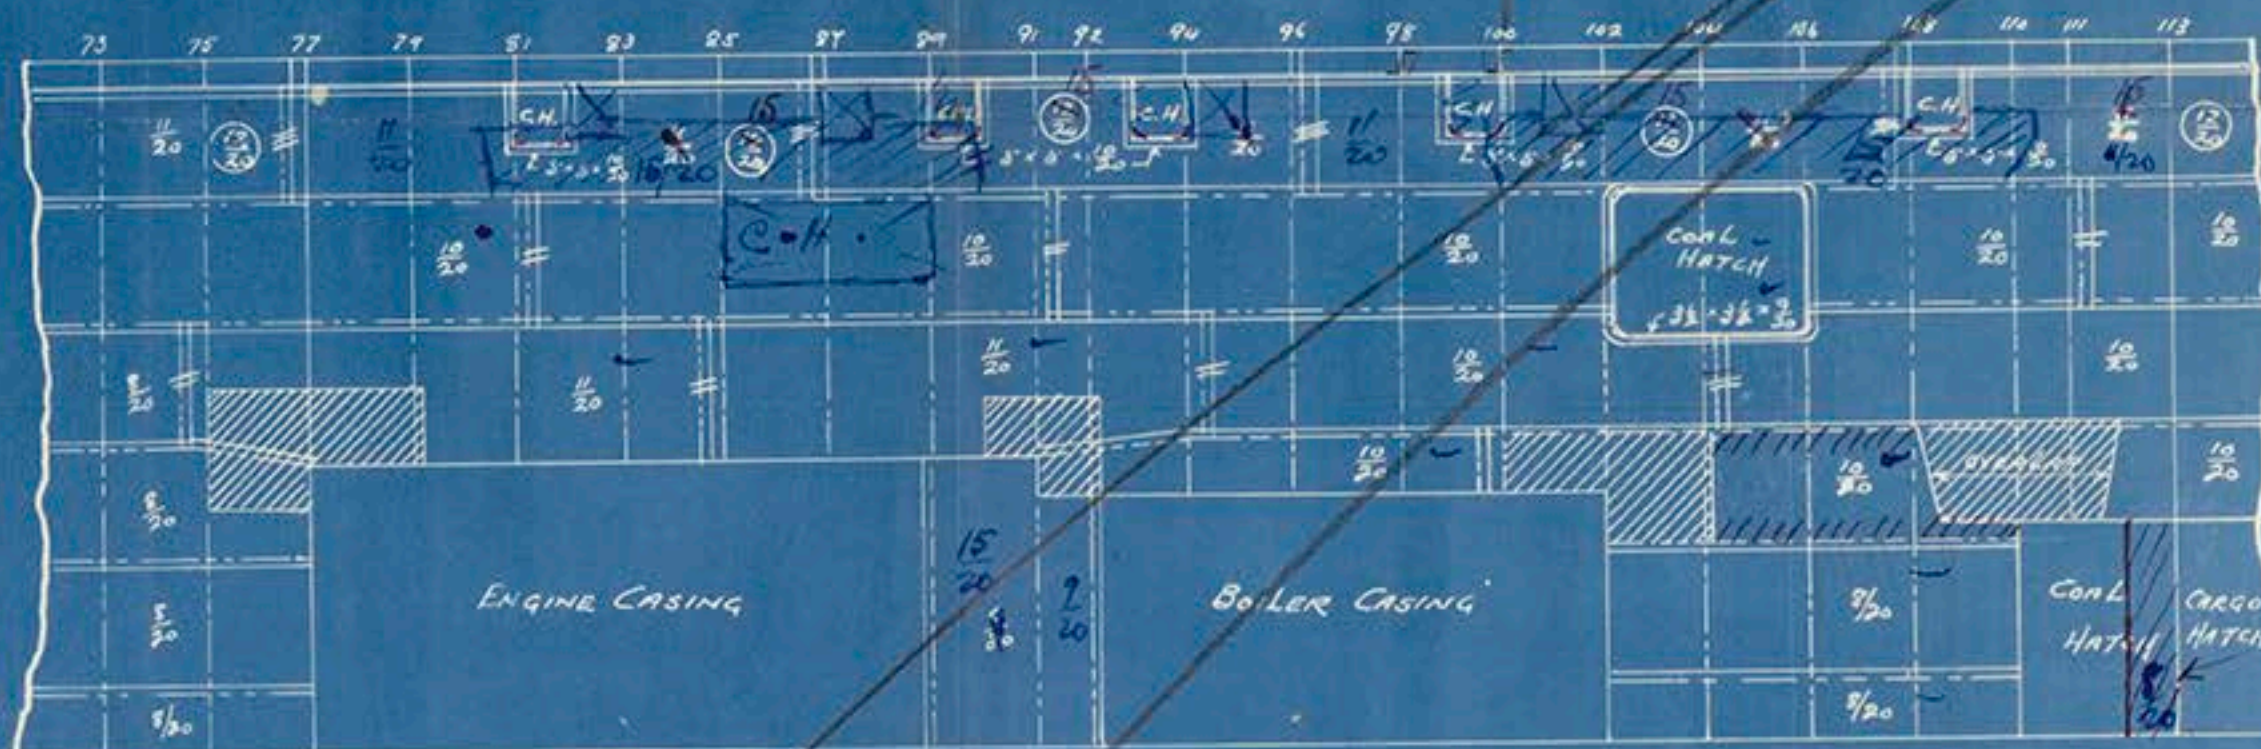

NOTE:- FIGURES IN RED ARE COMPENSATION TO STRINGER  
IN ADDITION TO  $5 \times 5 \times \frac{1}{2}''$  ANGLE FITTED ROUND OPENINGS.

Stiffeners fitted  
on after side.



472. Plan of Main Deck showing proposed alternative method of compartmentation for Coal Street Opening in Glasgow.

Glasgow.



St. Warabak  
GLASGOW Report No. 27140

Done

No. 472  
Burelay Curle No. 10.

Sketch showing doublings at  
side coaling hatch on main  
OK dispensed with & OK things  
thickened

REF  
3/12/18

not to be carried out  
as an extra to be added

RECEIVED



© 2018  
Lloyd's Register  
Foundation

472. Plan of Main Deck showing proposed alternative method of compartmentation for Coal Street Opening in Glasgow.