



31.5.12

ELEVATION AT HATCH SIDE COAMING AND INSIDE GIRDER
LOOKING FROM OUTSIDE OF HATCHWAY

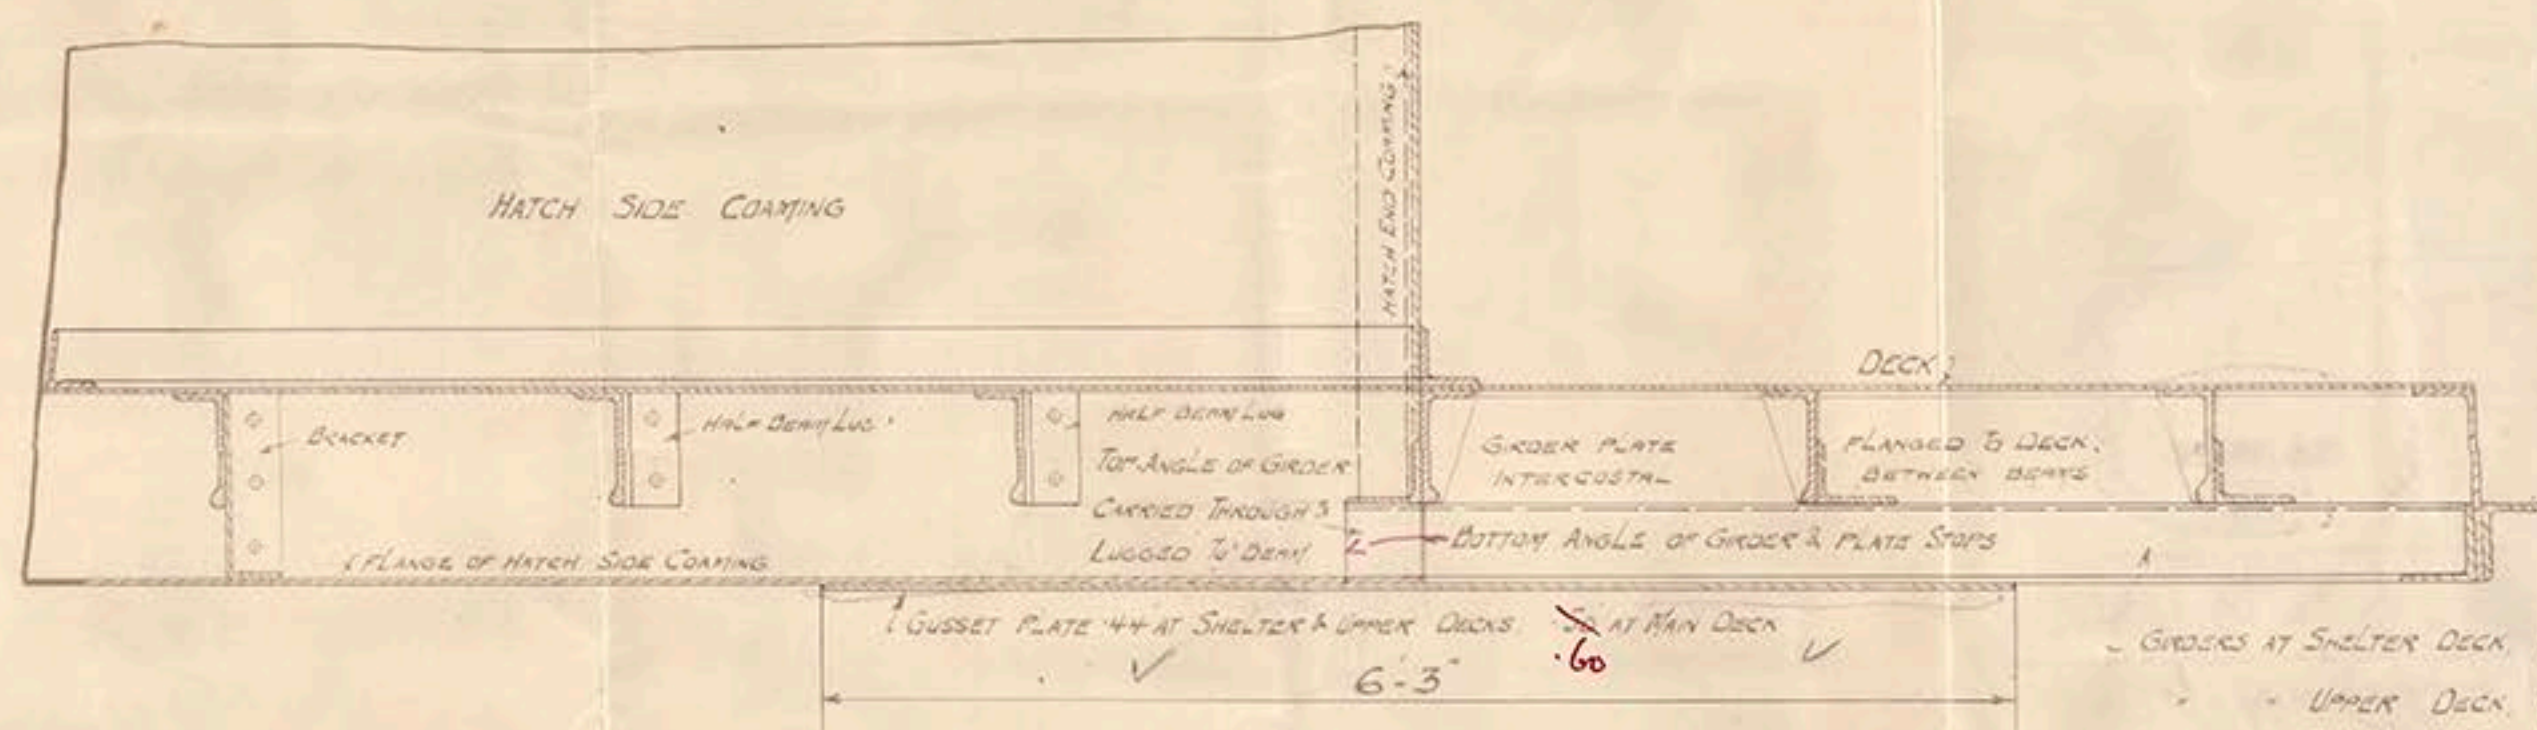

GIRDER BOTTOM ANGLES AND FLANGE OF HATCH SIDE COAMING
CONNECTED TO GUSSET PLATE BY 3/4" RIVETS AT UPPER AND
SHELTER DECK AND 3/8" RIVETS AT MAIN DECK.

PLAN AT CORNER OF HATCHWAY

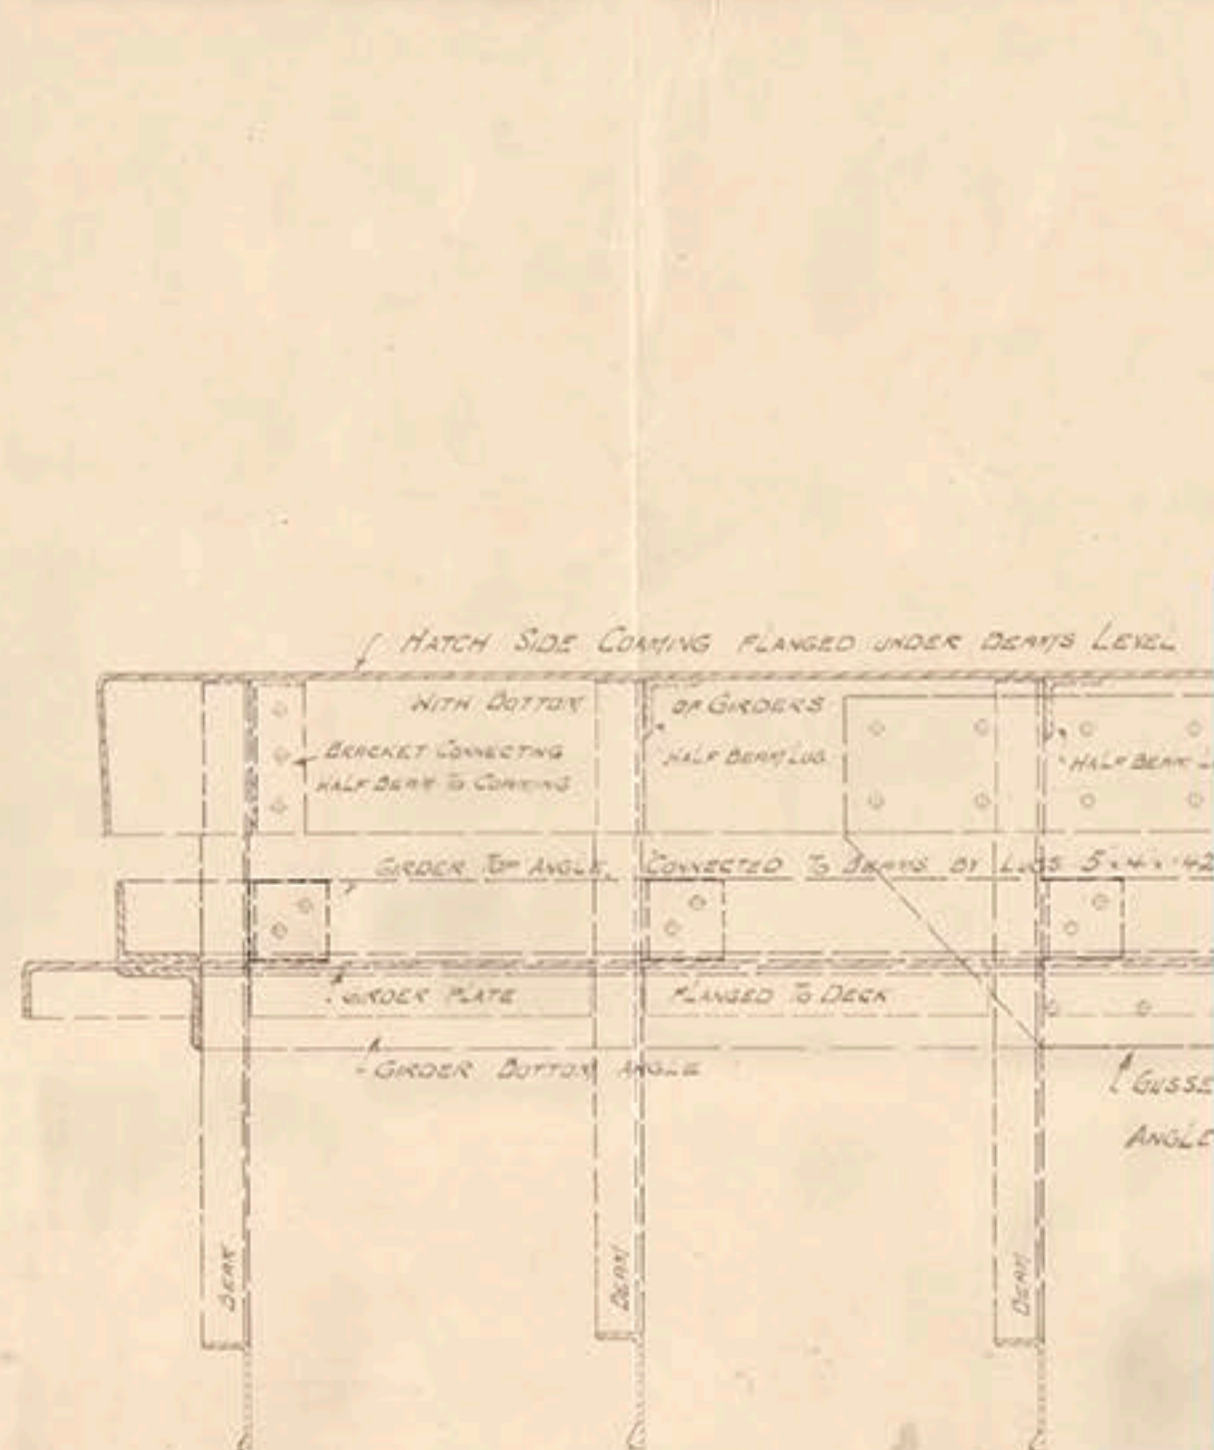

SKETCH SHEWING ARRANGEMENT OF GIRDERS
FOR WIDE SPACED HOLD PILLARS
AT CORNERS OF HATCHWAYS

— Scale 1 inch = 1 foot —

- GIRDERS AT SHELTER DECK, PLATE 44 & ANGLES 5.5.144 ✓
- UPPER DECK, PLATE 44 & ANGLES 5.5.148 ✓
- MAIN DECK, PLATE 50 & ANGLES 6.6.56 ✓

© 2018

Lloyd's Register
Foundation

No 527

IRVINE'S
SHIP BUILDING
AND
DRY DOCKS CO LTD
© 2018
Lloyd's Register
Foundation

Irvine S.B. & D.D. Co.
T. I. No 527

Arrangement of Deck
girders at corners
of Hatches.

"DIGBY"



Ref. No. 14645

DESTROY
1975

's Register
dation



© 2018

Lloyd's Register
Foundation