

RUDDER PLAN.

— SCALE  $\frac{3}{4}$  = 1 FOOT. —

RUDDER TO BE OF FORGED STEEL.

$$A \times D = 47.51 \times 2.47 = 117.34.$$


SPEED NOT EXCEEDING 10 KNOTS.

### DETAIL OF COUPLING.

— 3" = 1 FOOT —

SECTION IN WAY OF ARMS.

—  $1\frac{1}{2}$  = 1. FOOT. —

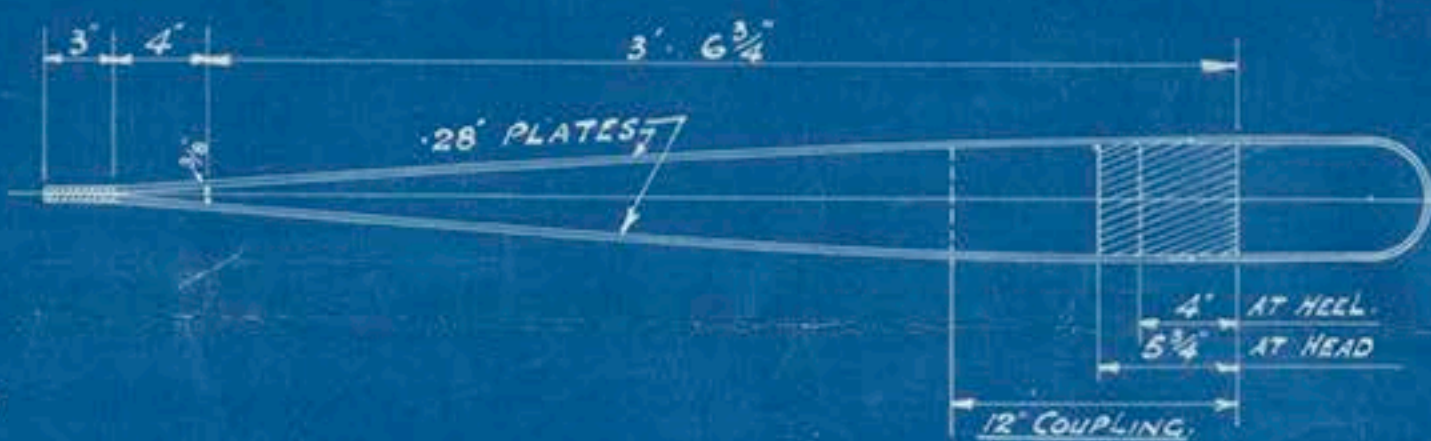

WM PICKERSGILL & SONS  
SHIPBUILDERS,  
SOUTHWICK,  
SUNDERLAND.

Nº 234.

DETAIL OF PINTLES.

— 3' = 1 FOOT. —



Pickersills

No 234

Amended midder

No. 235.

No. 236.

Correct  
plan

SUNDERLAND RPT. NO. 31924

234 "PORTSLADE" \* -

Sunderland Rpt. No 32024.  
236 "ARTHUR WRIGHT"

235 Henry Moon.

PLANS TRANSFERRED  
[ TO SISTER VESSEL

Auston



© 2018

Lloyd's Register  
Foundation

LR-FAF-TB23-P-33