

Nº 18.

1/2 SECTION AT 21 FRAME
LOOKING AFT


15/2/21

STAR[®] SIDE FRAME BRACKETS
CARRIED TO TUNNEL SIDE WITH
WOOD PLATFORM ON TOP

PLAN AT LOWER DECK

SCALE $\frac{1}{4}$ " = ONE FOOT

ALTERNATIVE METHOD OF SUPPORTING GIRDER AT 25 FRAME

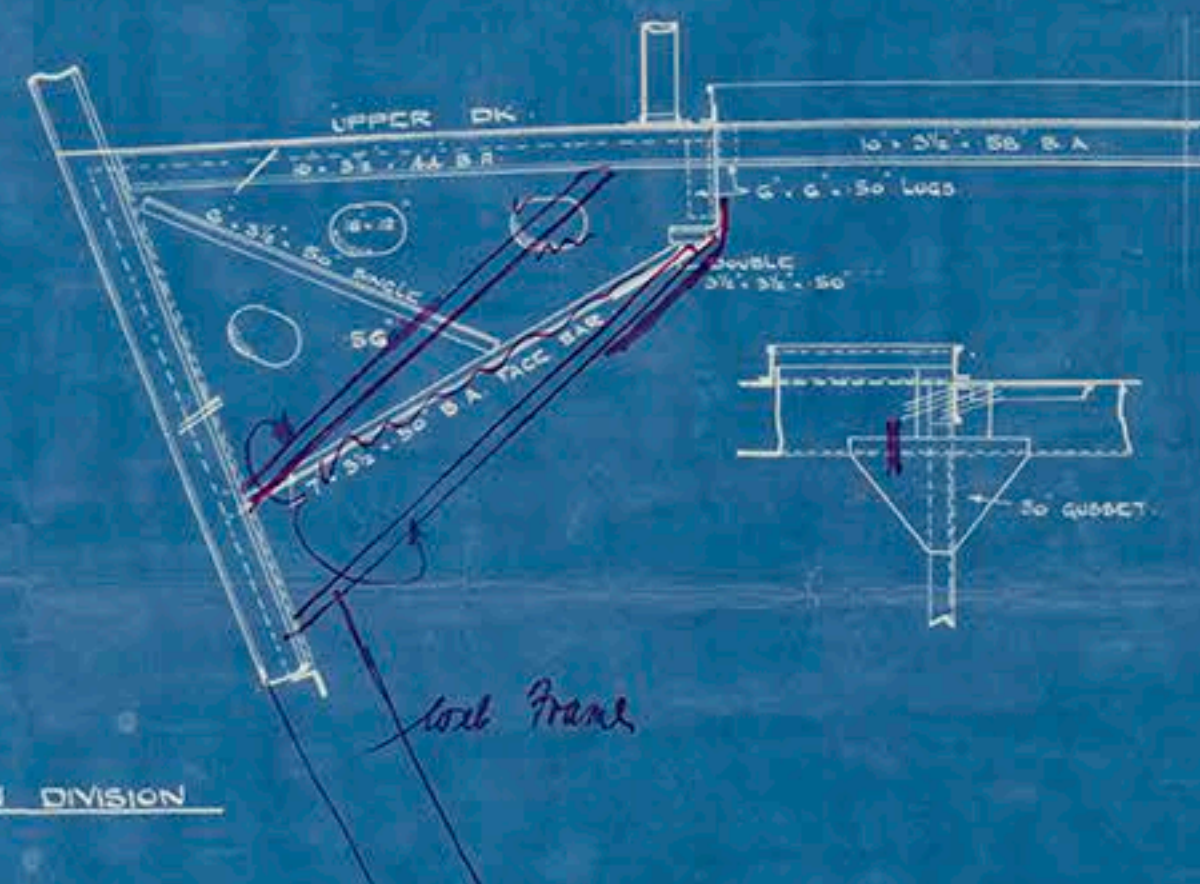


5 1676

SEE PLAN N° 3 1682 FOR STEEL GRAIN DIVISION

SECTION AT 25 FRAM

LOOKING AFT

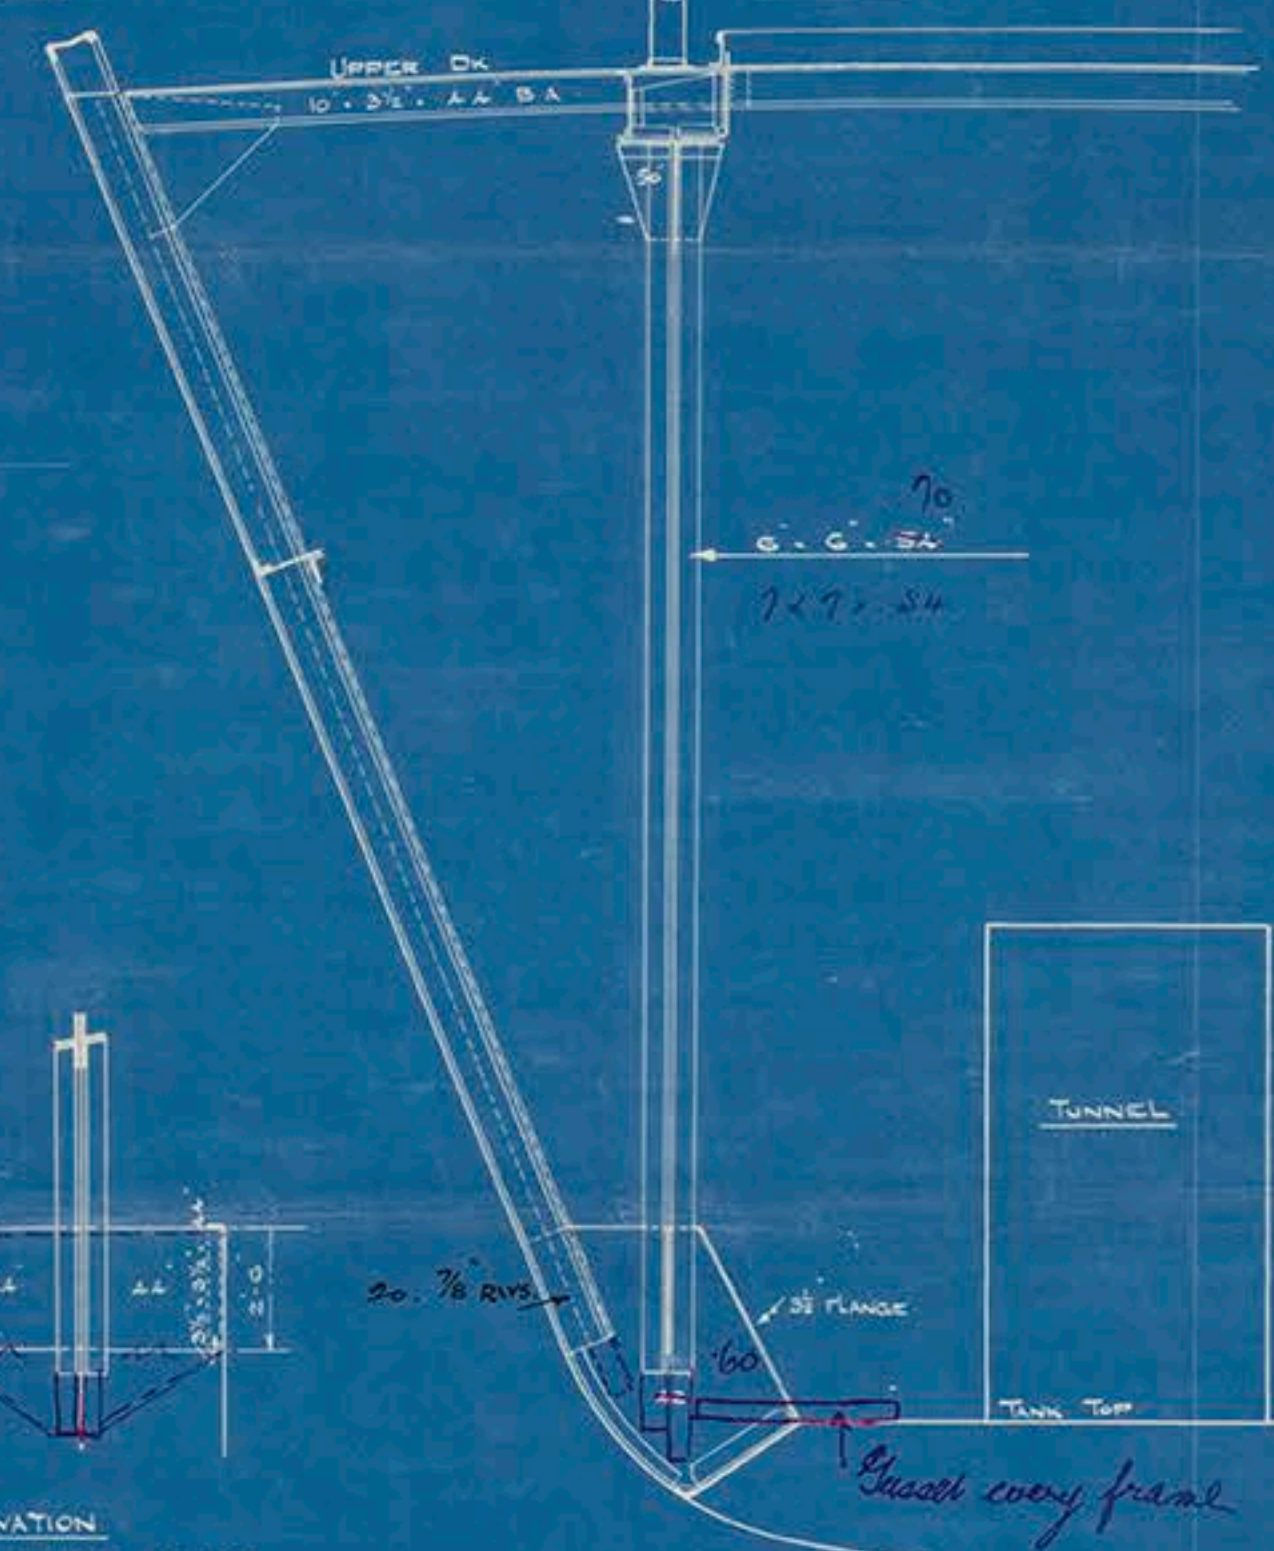

PLAN VIEW

ELEVATION

LOOKING TOWARDS CENTRE

P.M.M.
17.2.2

Mr. S. J. Turner S.B.C.

Nº 18

Overseer of Lower Deck
in After. Hold

Compensation to Side Passages
and rearrangement of Ropes

S.S. Manchester Regiment
(No 18)

MIDDLESBRO' Rpt No. 11370

RETAIN

2



© 2018

Lloyd's Register
Foundation

LR FAF-T015-P-11