

T.S.M.V. No 651


430'0" x 60'0" x 38'6" TO UPPER DECK

PROFILE & DECK PLANS

SCALE 1/16" = 1 FOOT

LLOYDS 100 A1 WITH FREEBOARD CORRESPONDING TO A DRAFT OF 24'6"

WILLIAM BEARDMORE & CO., LTD.
DESIGNING DEPT.
NUMBER 4497.
DATE 24/11/27.
EXAMINED BY
NAVAL CONSTRUCTION WORKS,
DALMUIR, N.B.

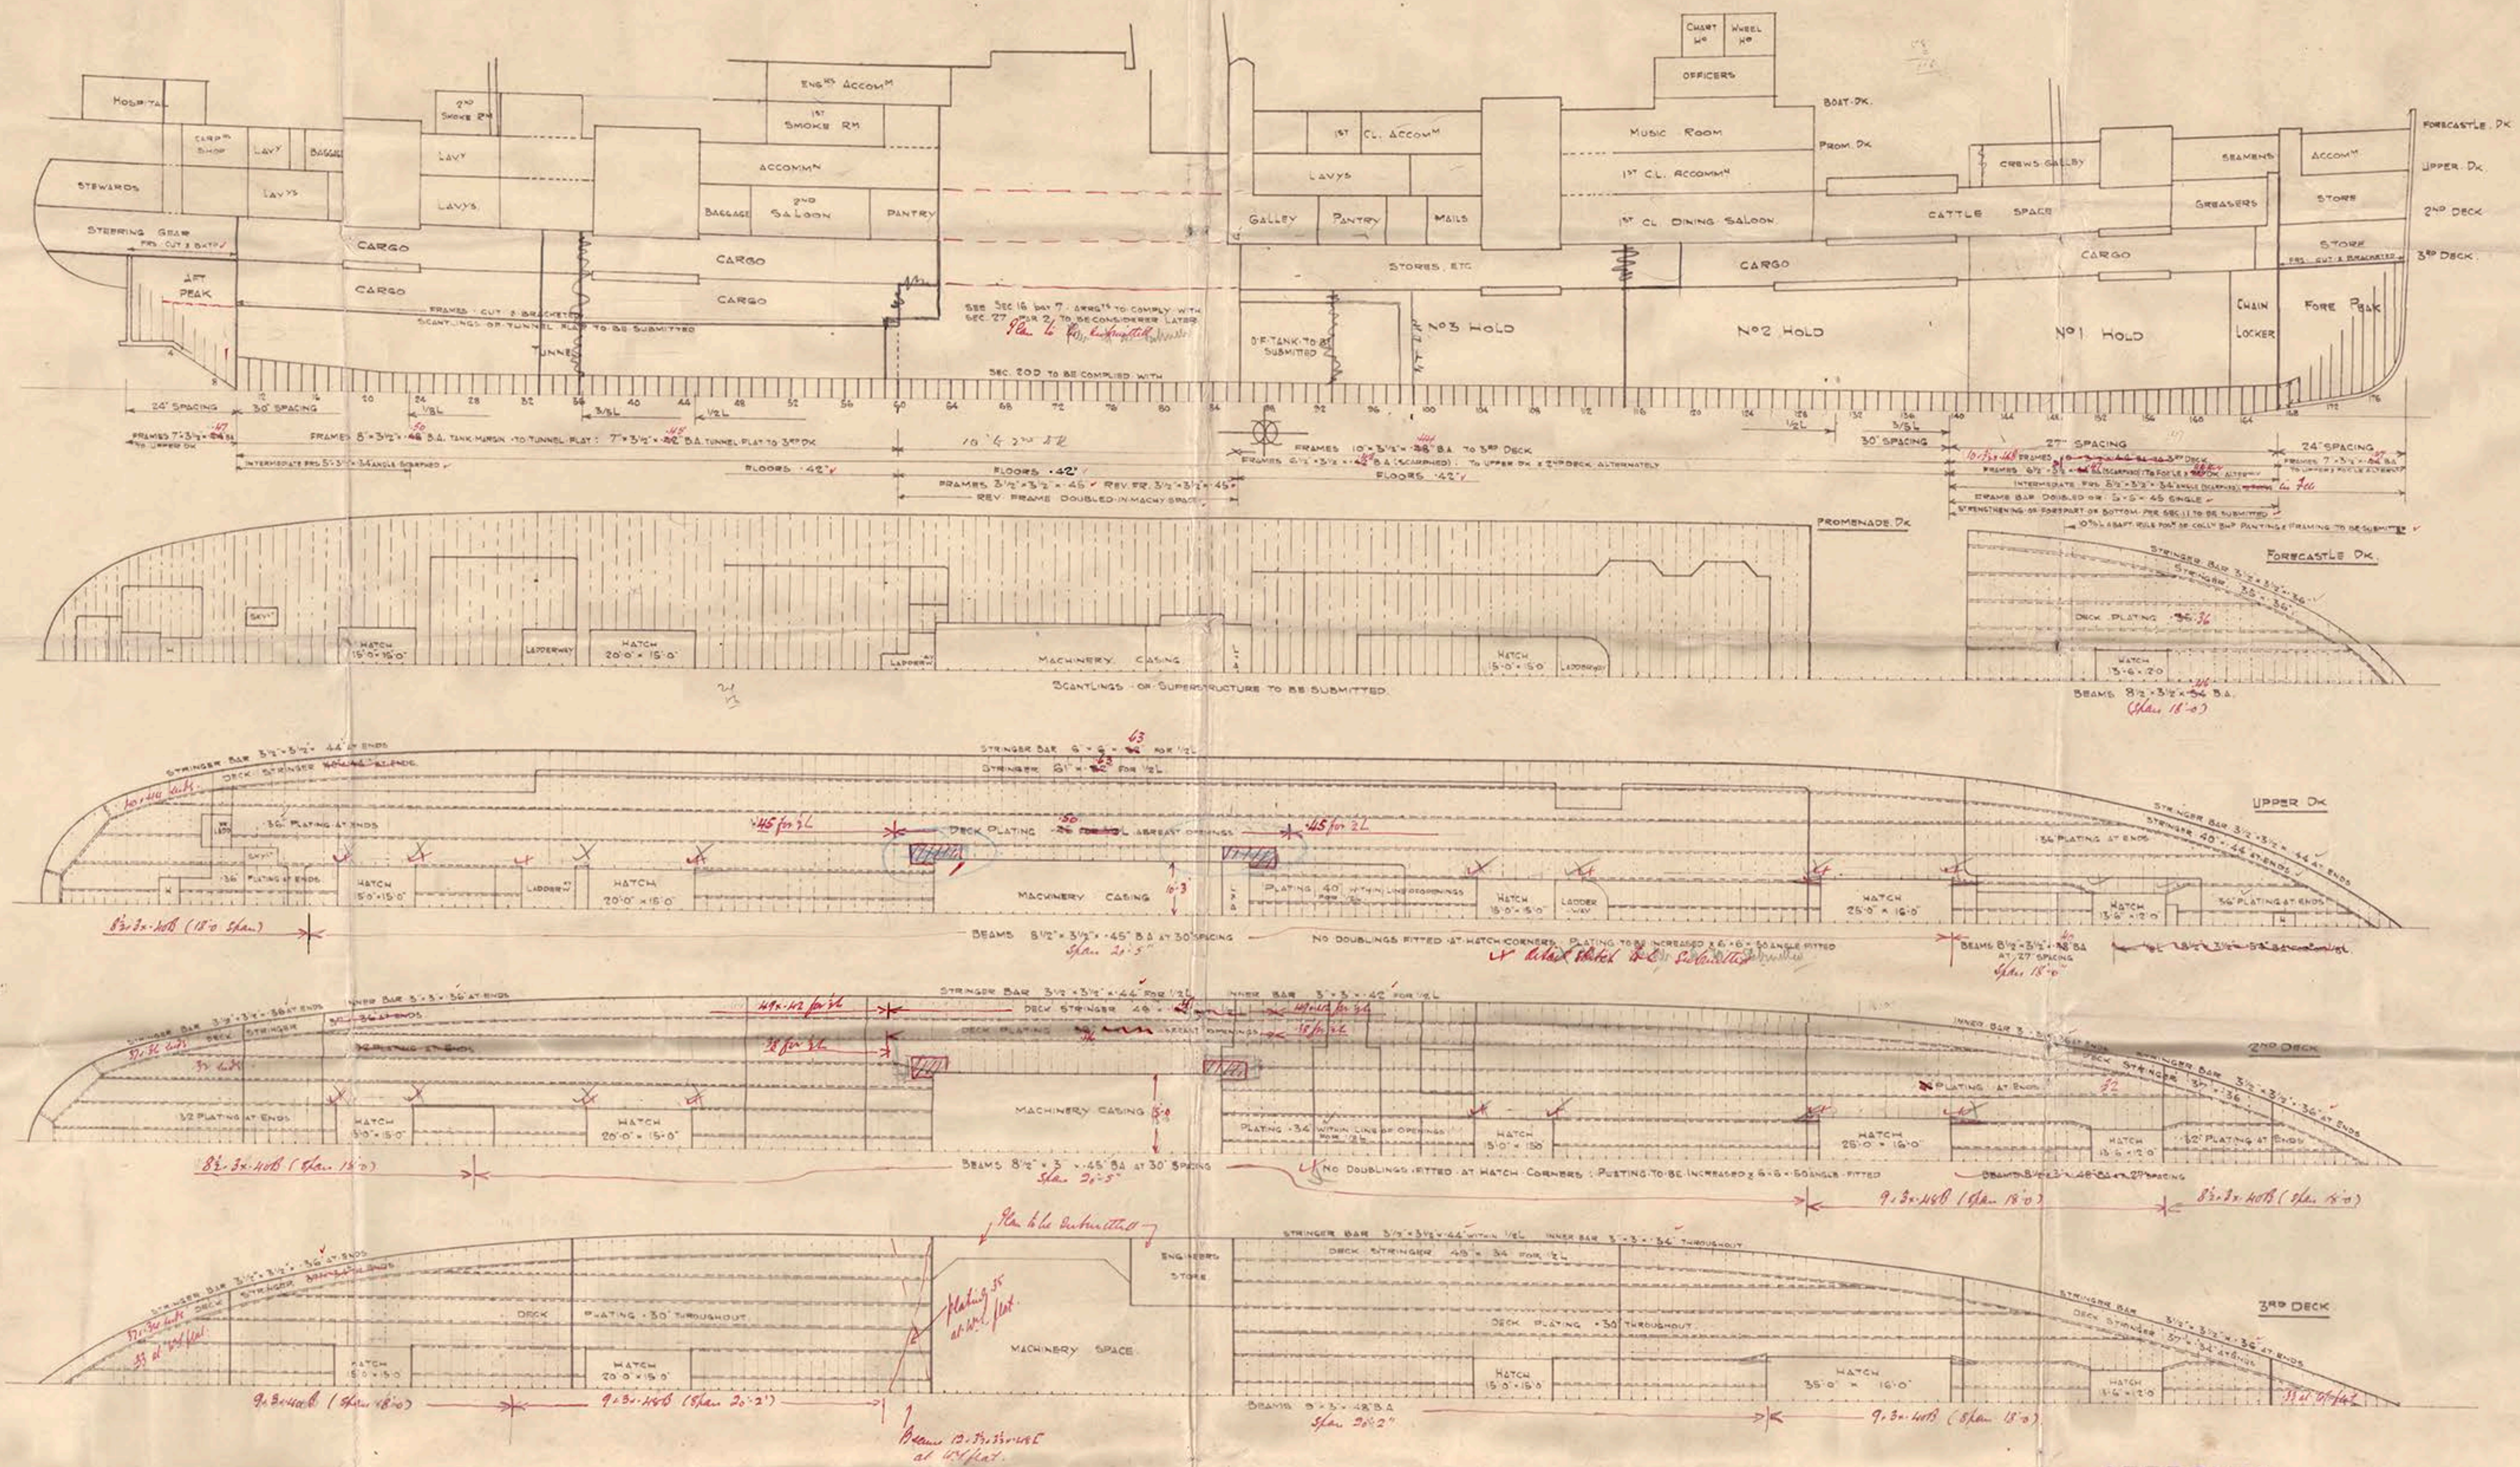

The following additional scantlings required by Census are not embodied on this plan
The floor, brackles and angles under the engines to be 20% in excess of Floysds
Tank Top in Machinery space to be not less than .56"

APPROVED
LLOYDS REGISTER OF SHIPPING
J. H. G. G. G.
DATE 1/12/24

Profile & books

Wm. Beadmore Ho

no 657

Fbol

GLASGOW REPORT No. 149021

GLASGOW REPORT No.

Manuela

GLASGOW REPORT No. 49089



© 2018

Lloyd's Register
Foundation