

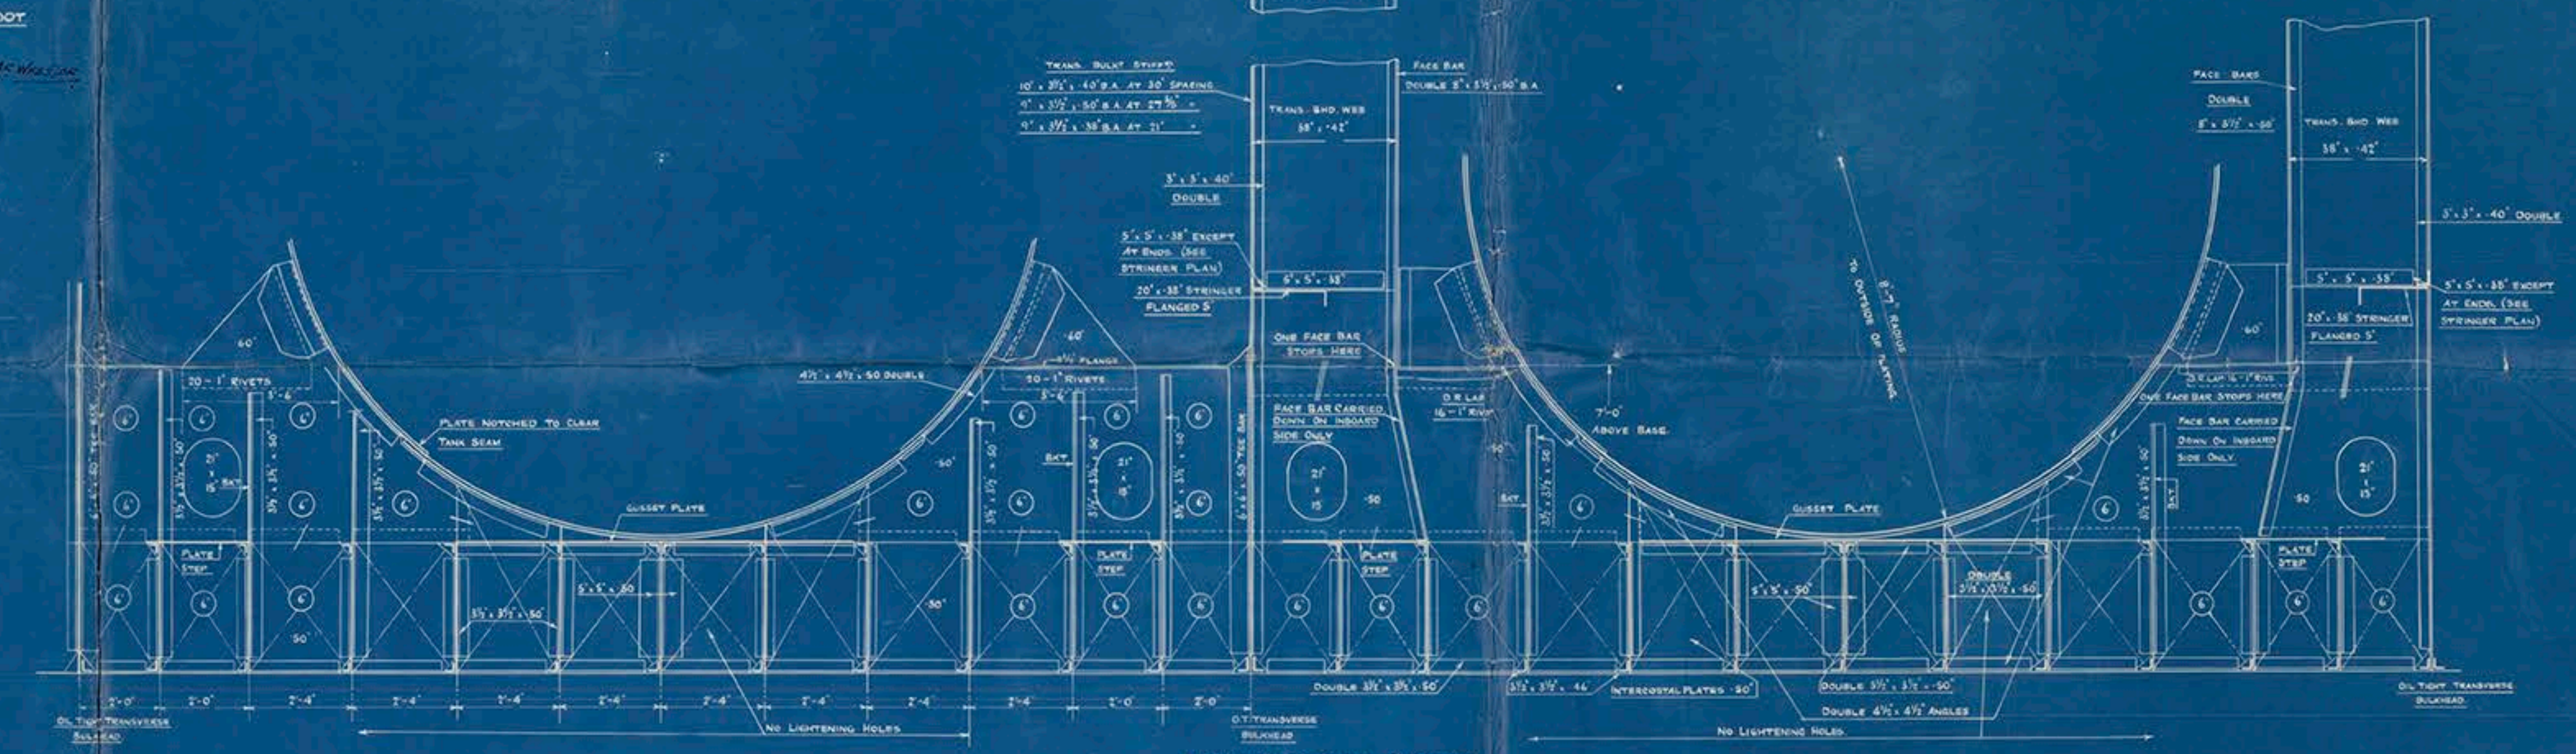
(AS FITTED)

SCALE $\frac{1}{2}$ = 1 FOOT

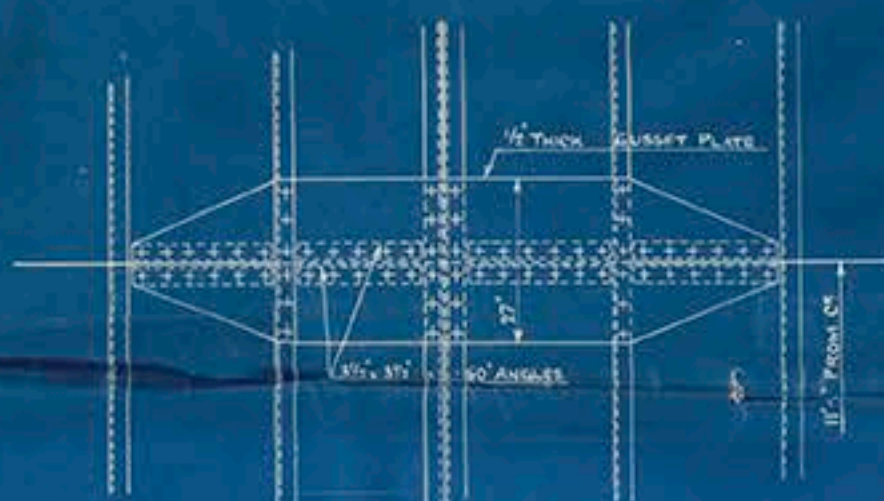
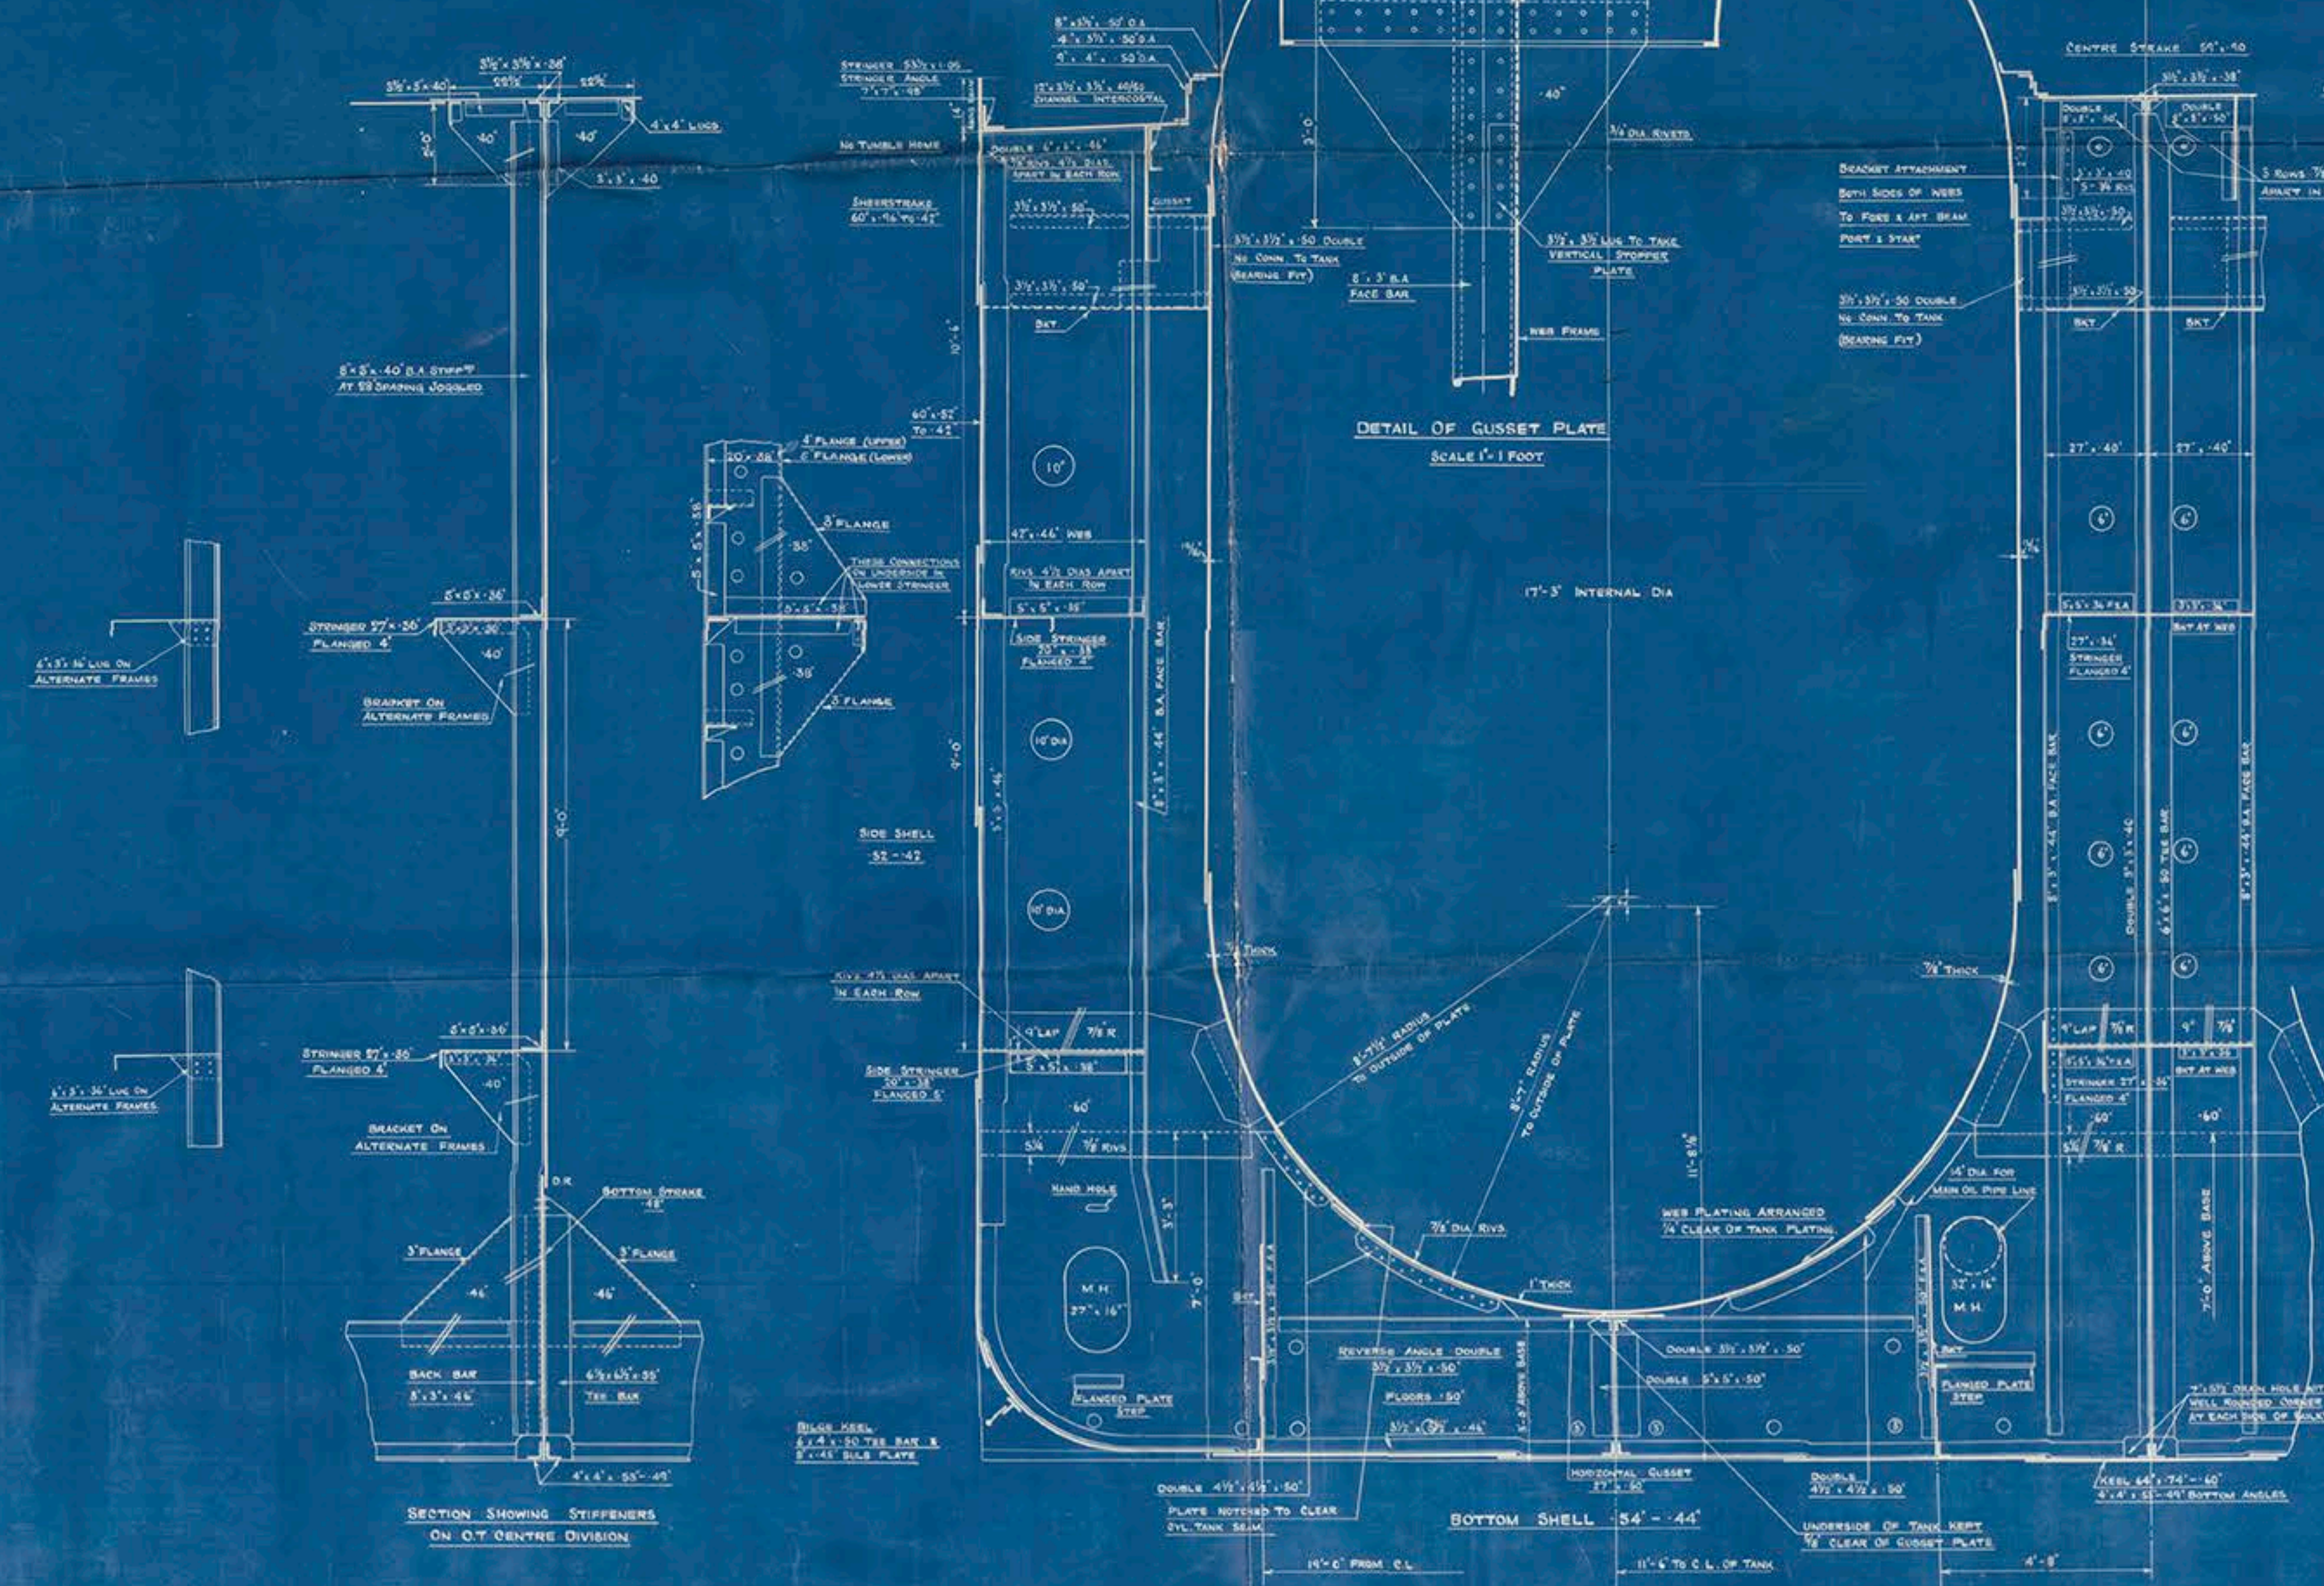


2 BOWER ANCHORS STOCKLESS	45 CWT
1 " " " "	38
1 STREAM EX STOCK	12
270 FMS. OF 1 1/2" STUD LINK CABLE.	
90 FMS. OR 4 1/2" F.S. WIRE ROPE (STREAM)	
100 FMS. OF 4' " " "	TOWLINE
2 AT 90 FMS. 2 1/2" F.S.W. HAWSER	
2 AT 90 FMS. 2 1/2" F.S.W. WARP	

$L \times D$	=	8410
$L \times (S + D)$	=	23650
$L \div D$	=	10.7



DETAIL OF GUSSET PLATE ON FLOOR TOPS.

[illegible]

SECTION OF FRAMING CLEAR OF WEB

S/S AGNITA

Metched Section
of Bevel at Buik

Hawthorn Leslie & Co

No 578

S.S. "AGNITA"

NEWCASTLE ON TYNE.

Report No. 86948.



© 2018

Lloyd's Register
Foundation