

TURBINE PASSENGER STEAMER

FOR THE UNION STEAM SHIP COMPANY OF NEW ZEALAND LIMITED.

MIDSHIP SECTION.

SCALE 1/2 INCH = ONE FOOT.


TO CLASS + 100 A.I. "WITH FREEBOARD" SCANTLINGS ARRANGED FOR A SUMMER DRAFT OF 25'-5" MLD.

ALL CHANNEL AND BULB ANGLE SECTIONS TO NEW BRITISH STANDARD.



LENGTH ON W.L. (OVER CRUISER STERN) = 538'-0"
 LENGTH B.P. = 520'-0"
 BREADTH MLD = 74'-0"
 DEPTH MLD TO A DECK = 44'-9"
 DEPTH MLD TO B. DECK = 35'-6"
 L ÷ DM. TO PROMENADE DECK (53'-0") = 9.8
 L ÷ DM. TO A DECK (44'-9") = 11.6

EQUIPMENT TO RULE. See approved plan. Letter J.

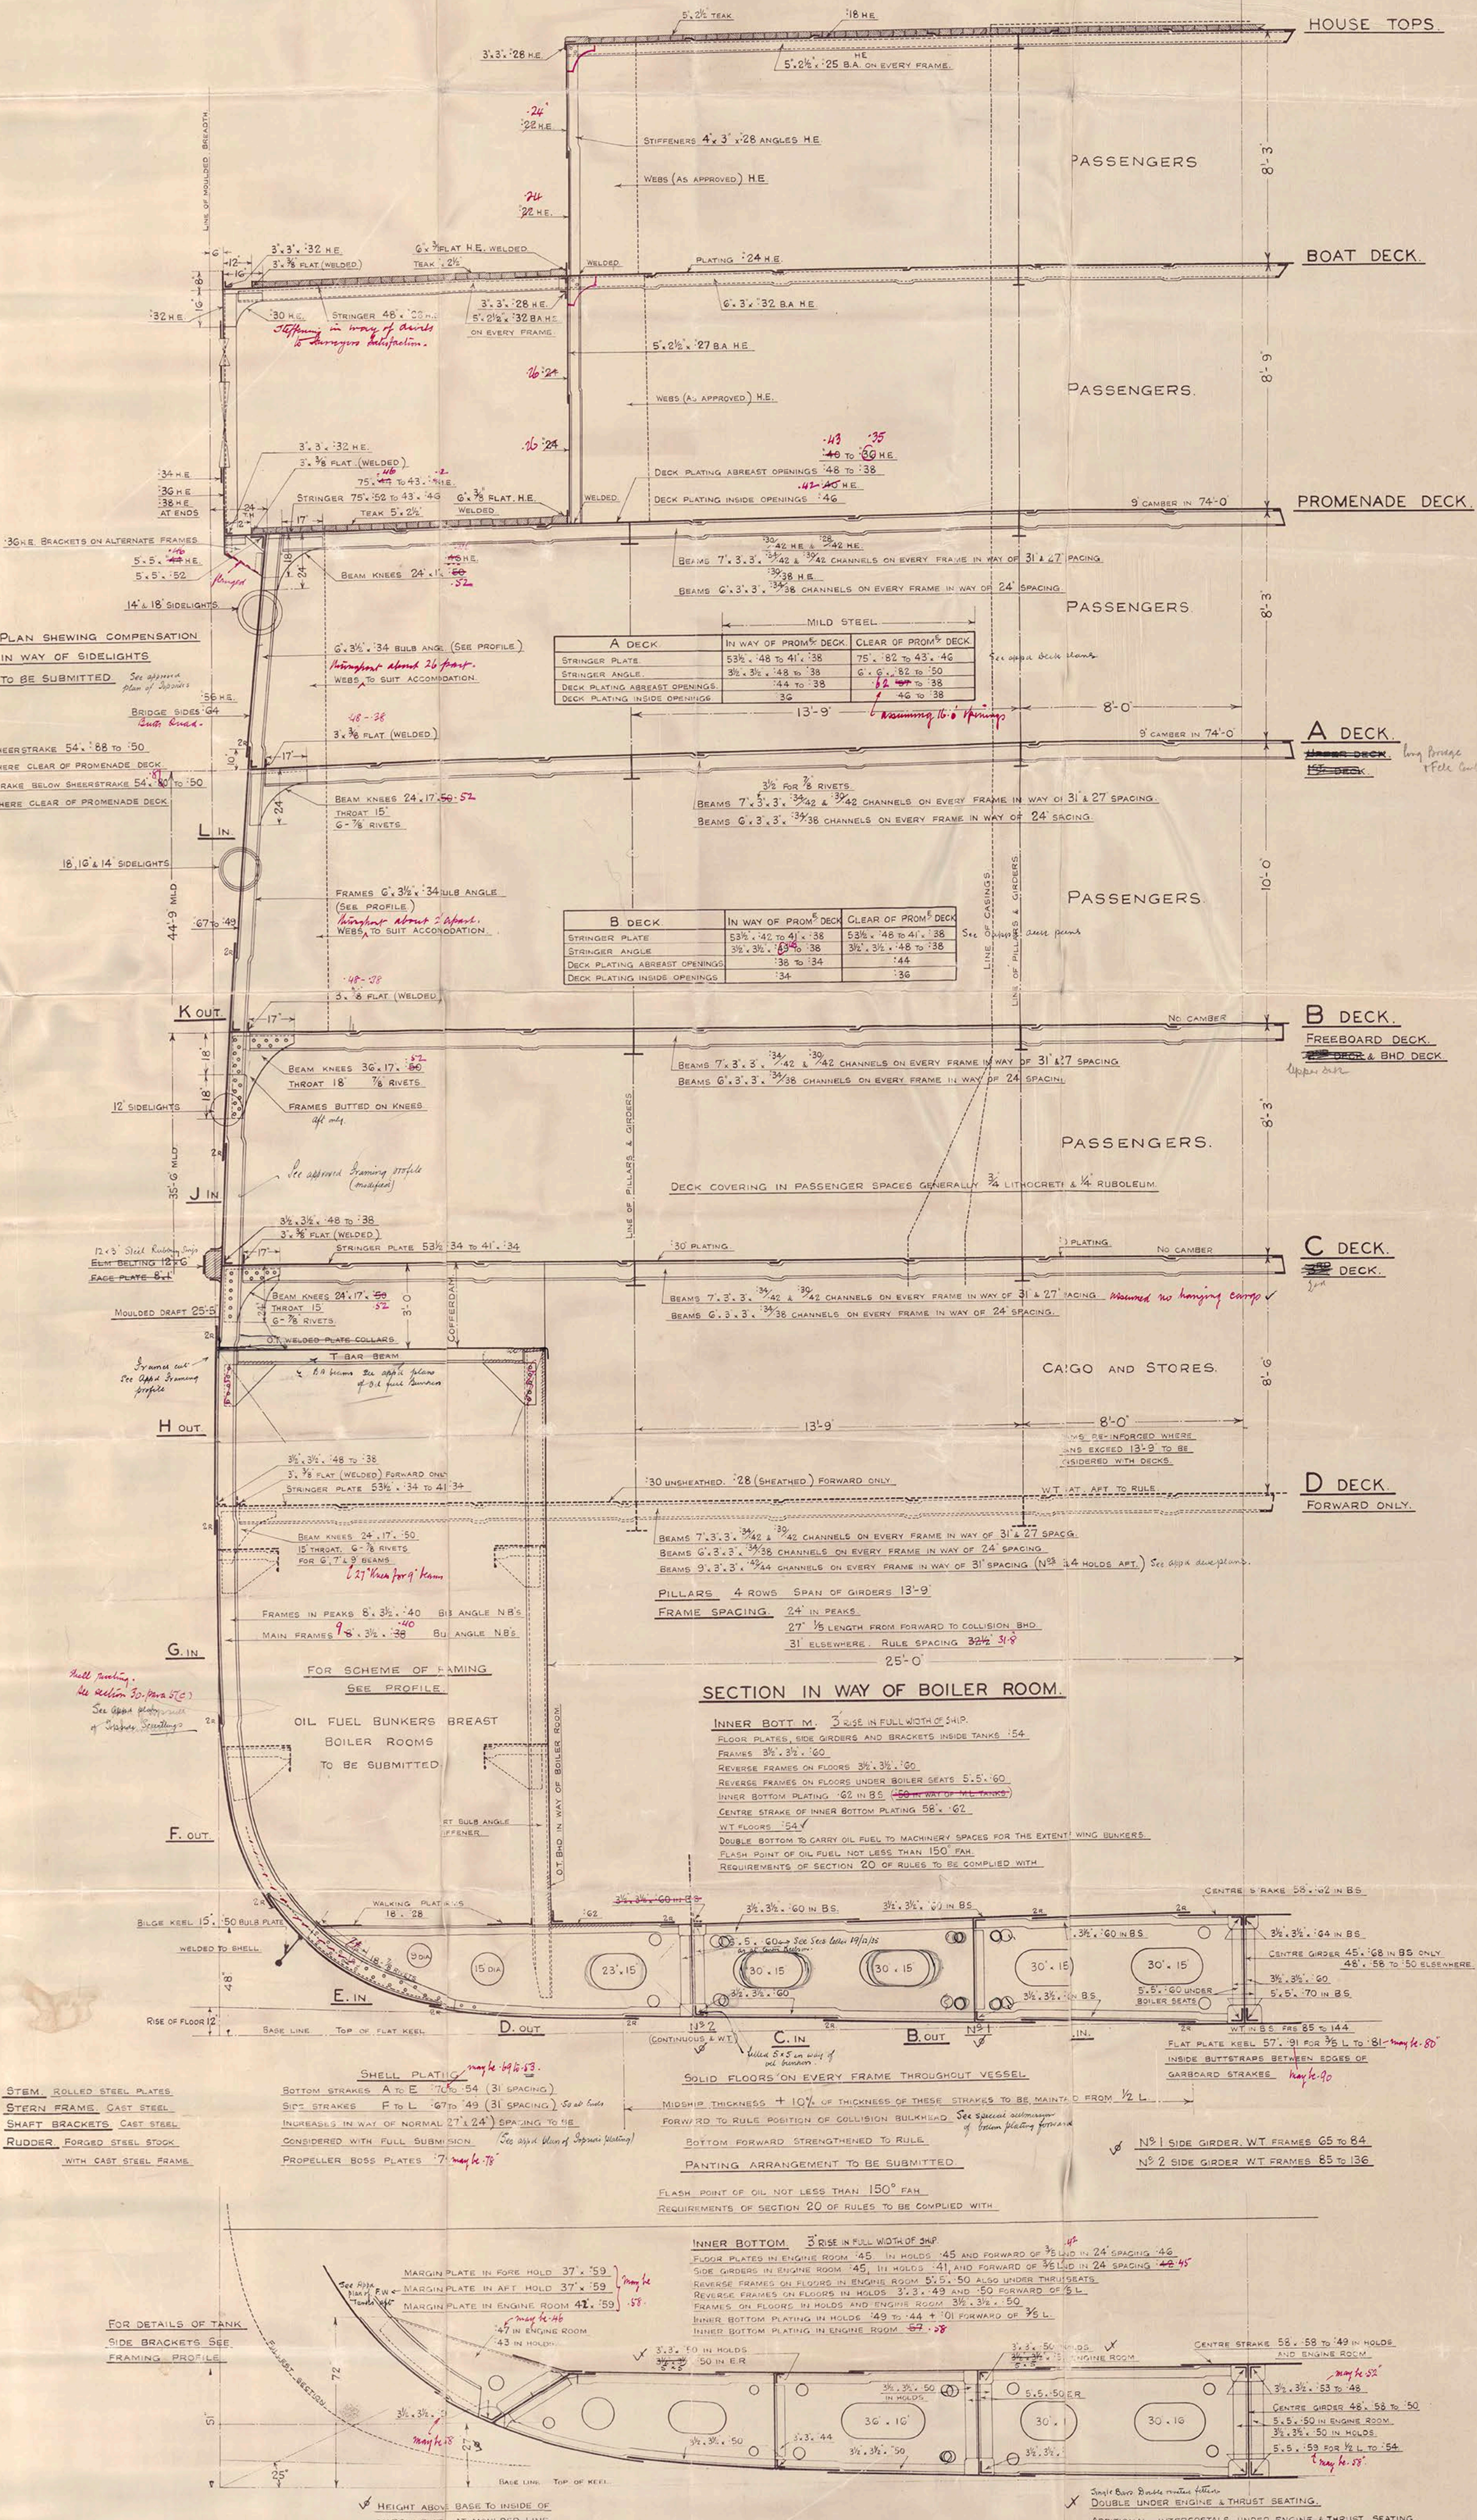

bickers - Armstrongs & S.S. No 404

Midship Section

T.S.S. "Awatea" - Barrow Report 2619

W.S. 155



© 2018

Lloyd's Register
Foundation

LR-FAF-TB29-P-17