


AUXILIARY GEAR

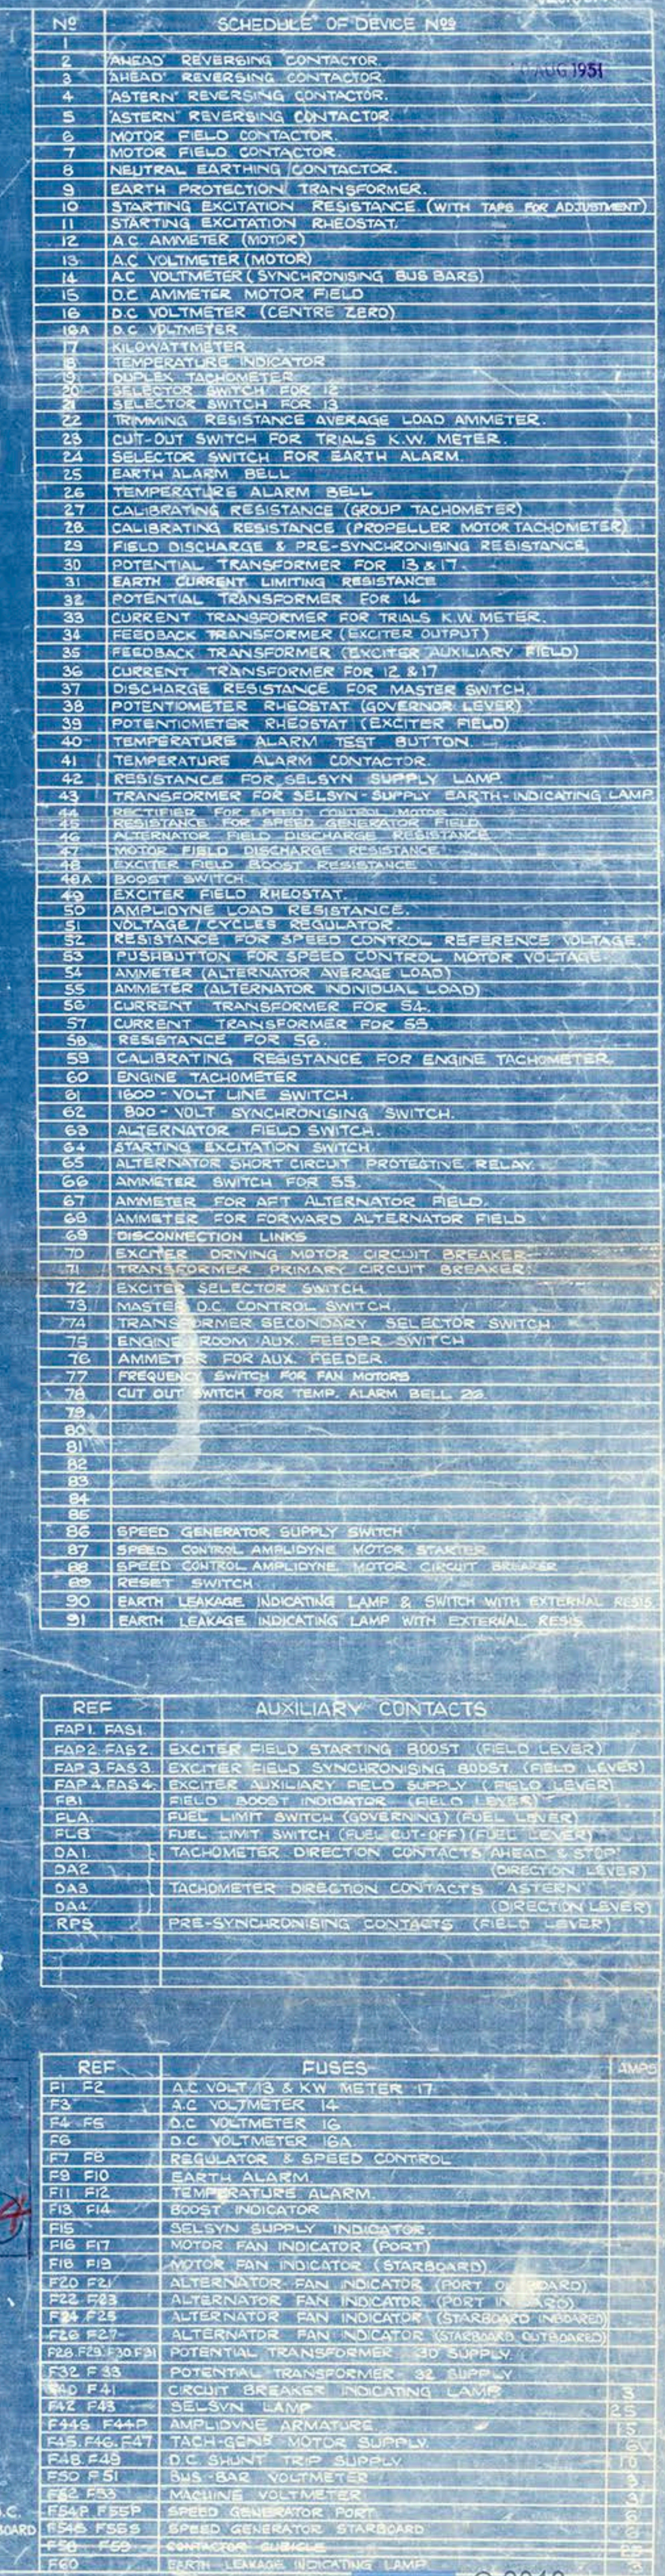

PLEASE
NOTE
REVISION NO. 14

15/8/11

30 kW
OR
BOARD 30kW
OR
V, D.C.
25 VIA

FROM
110 V. D.
SWITCH

© 2018
Lloyd's Register
Foundation