

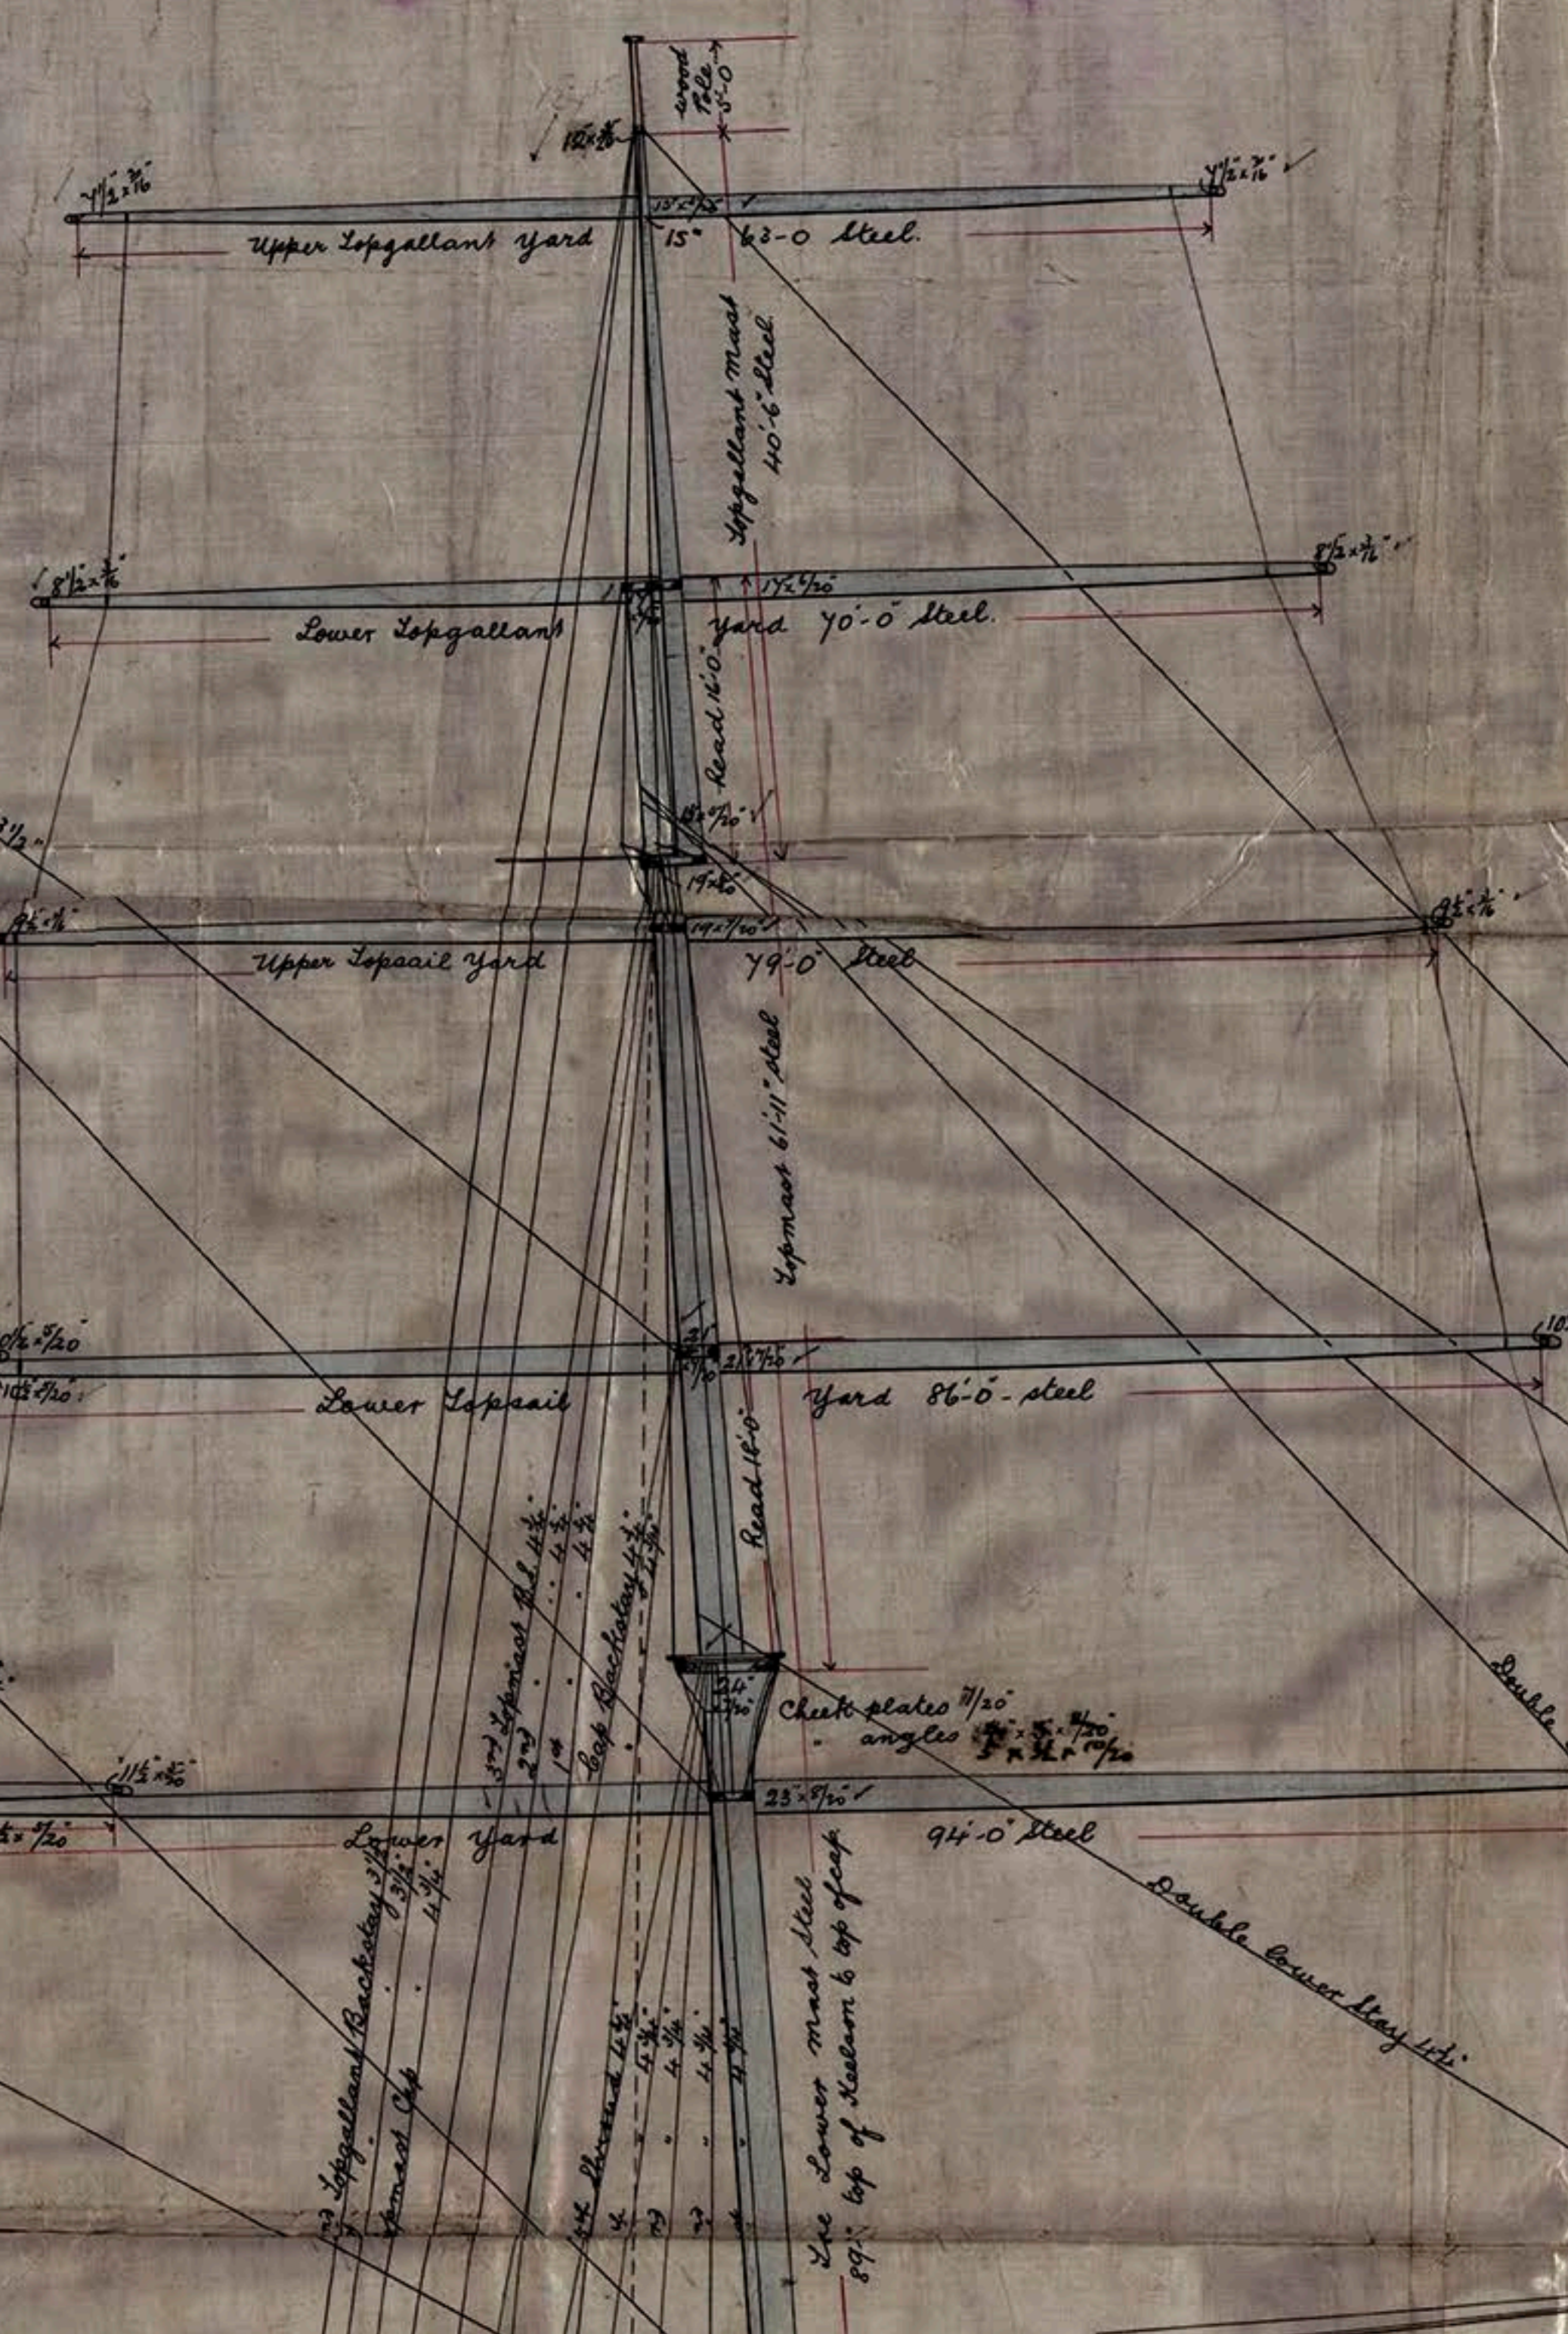
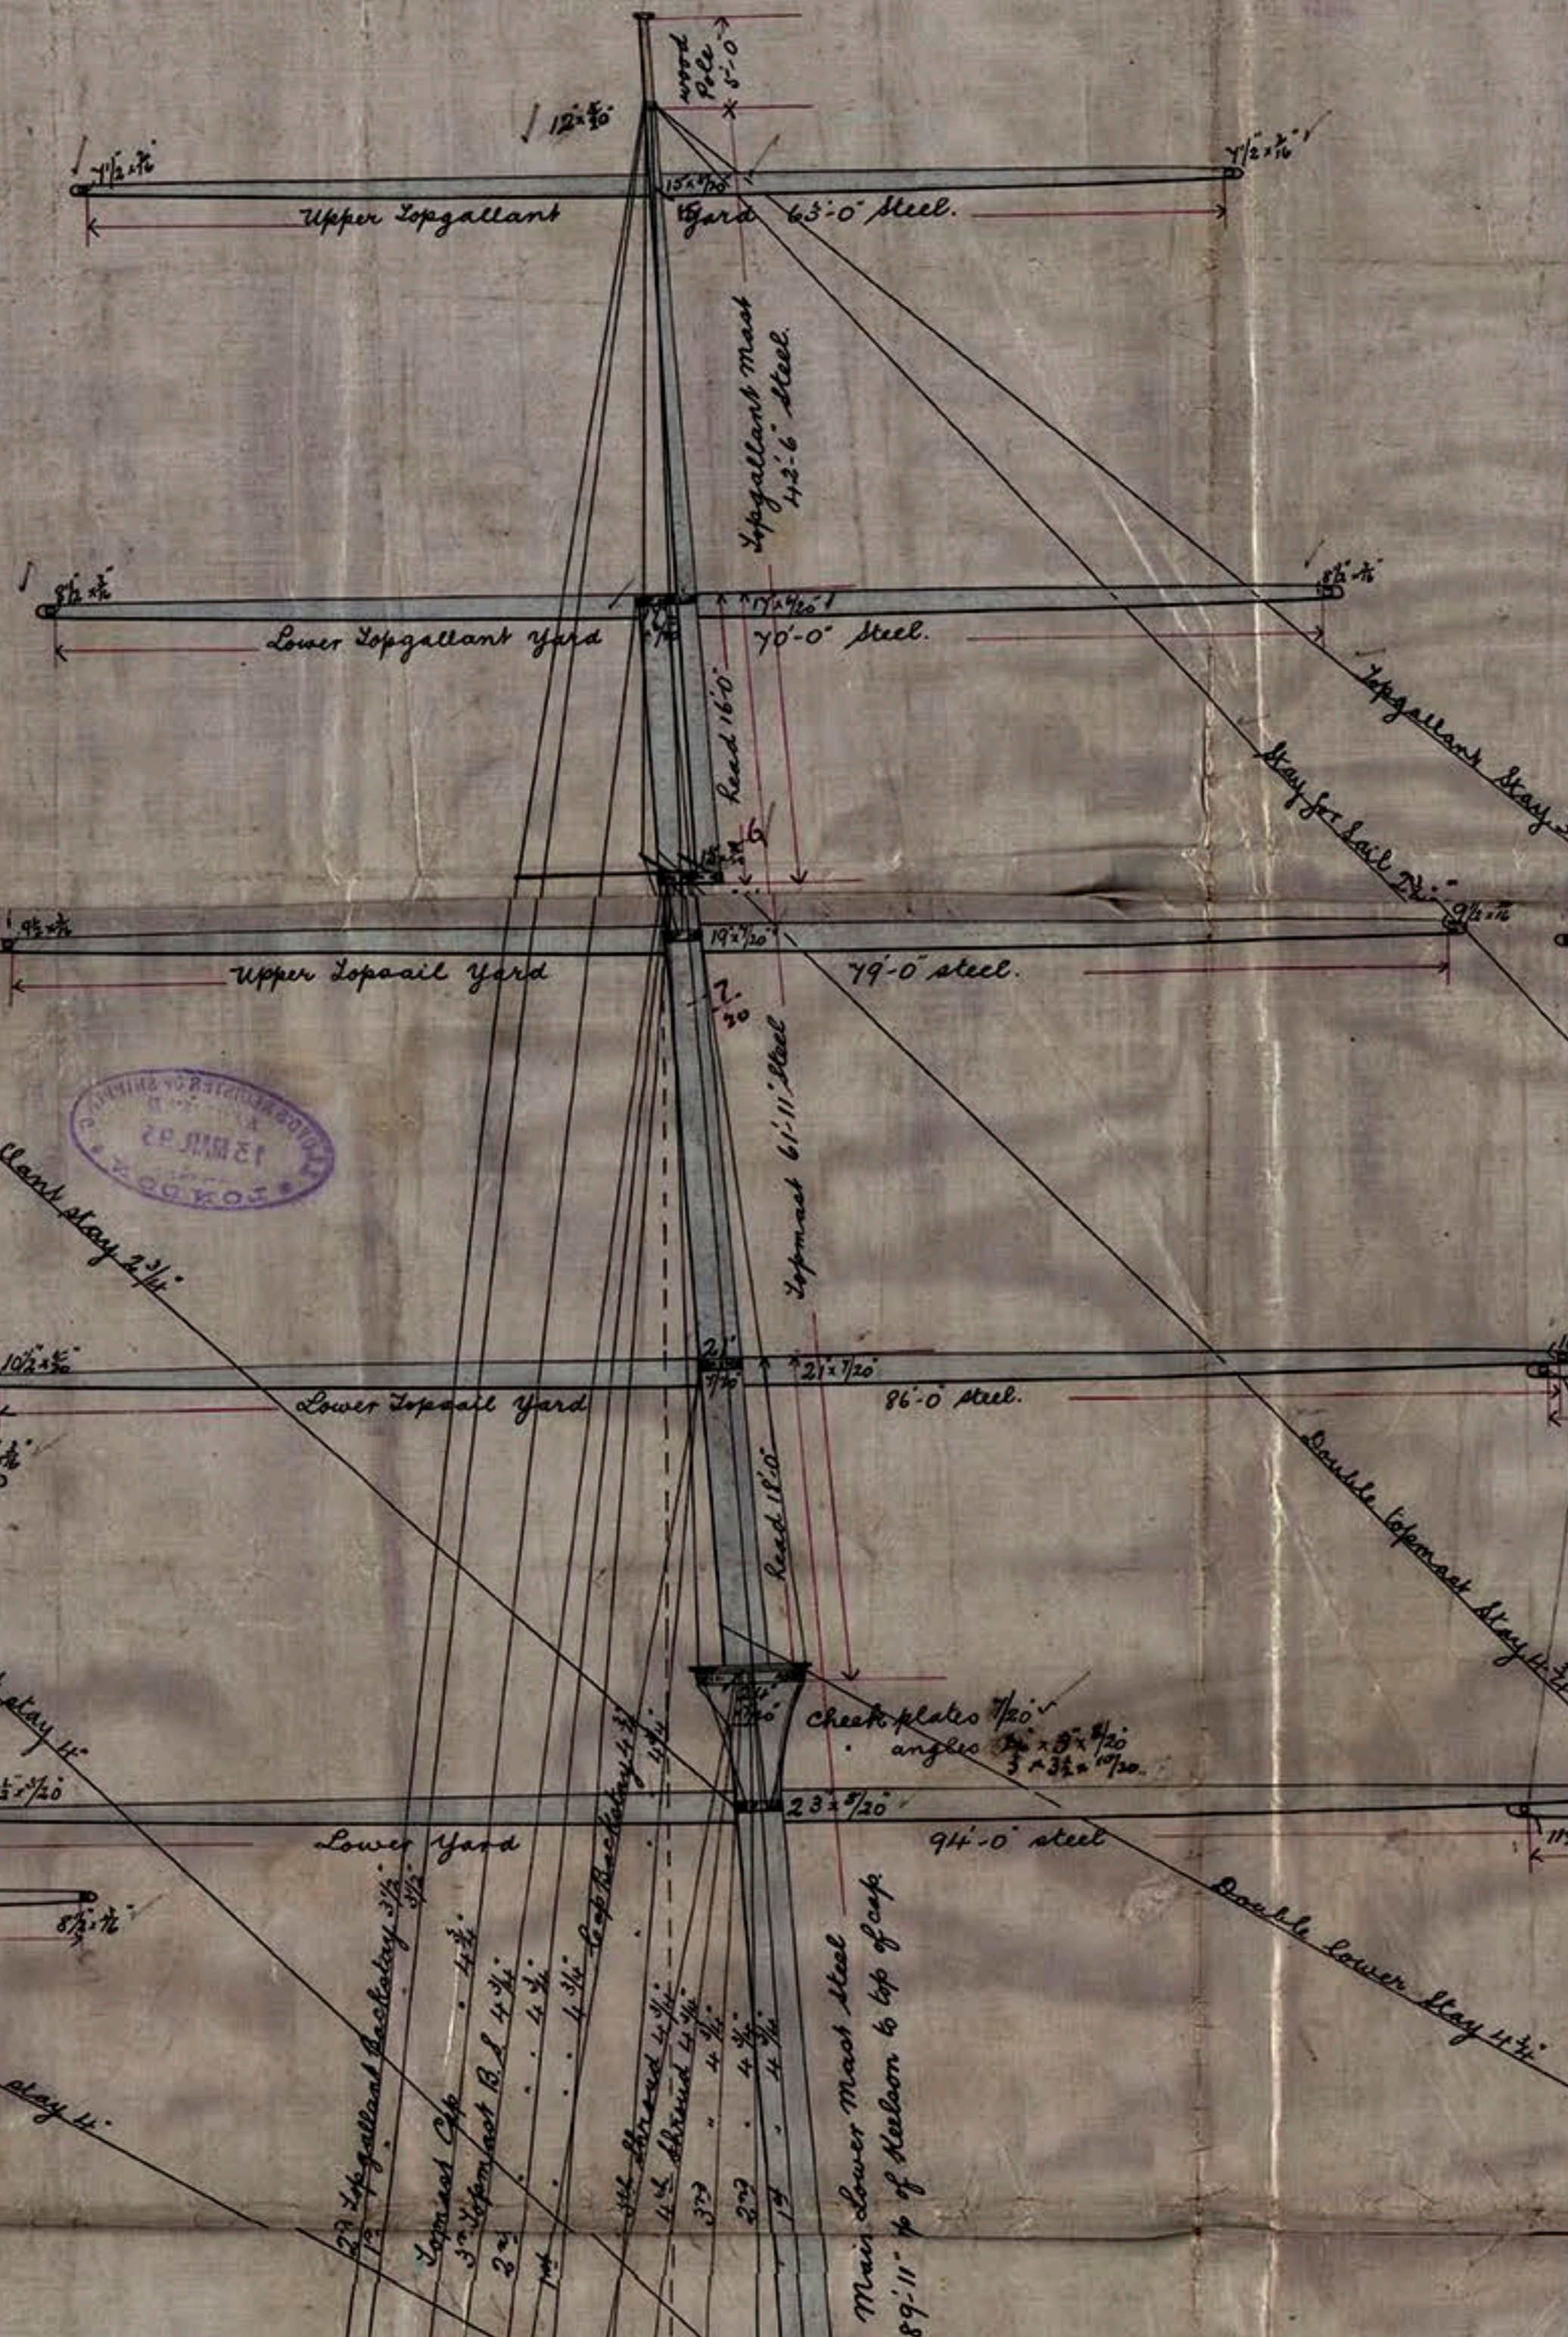
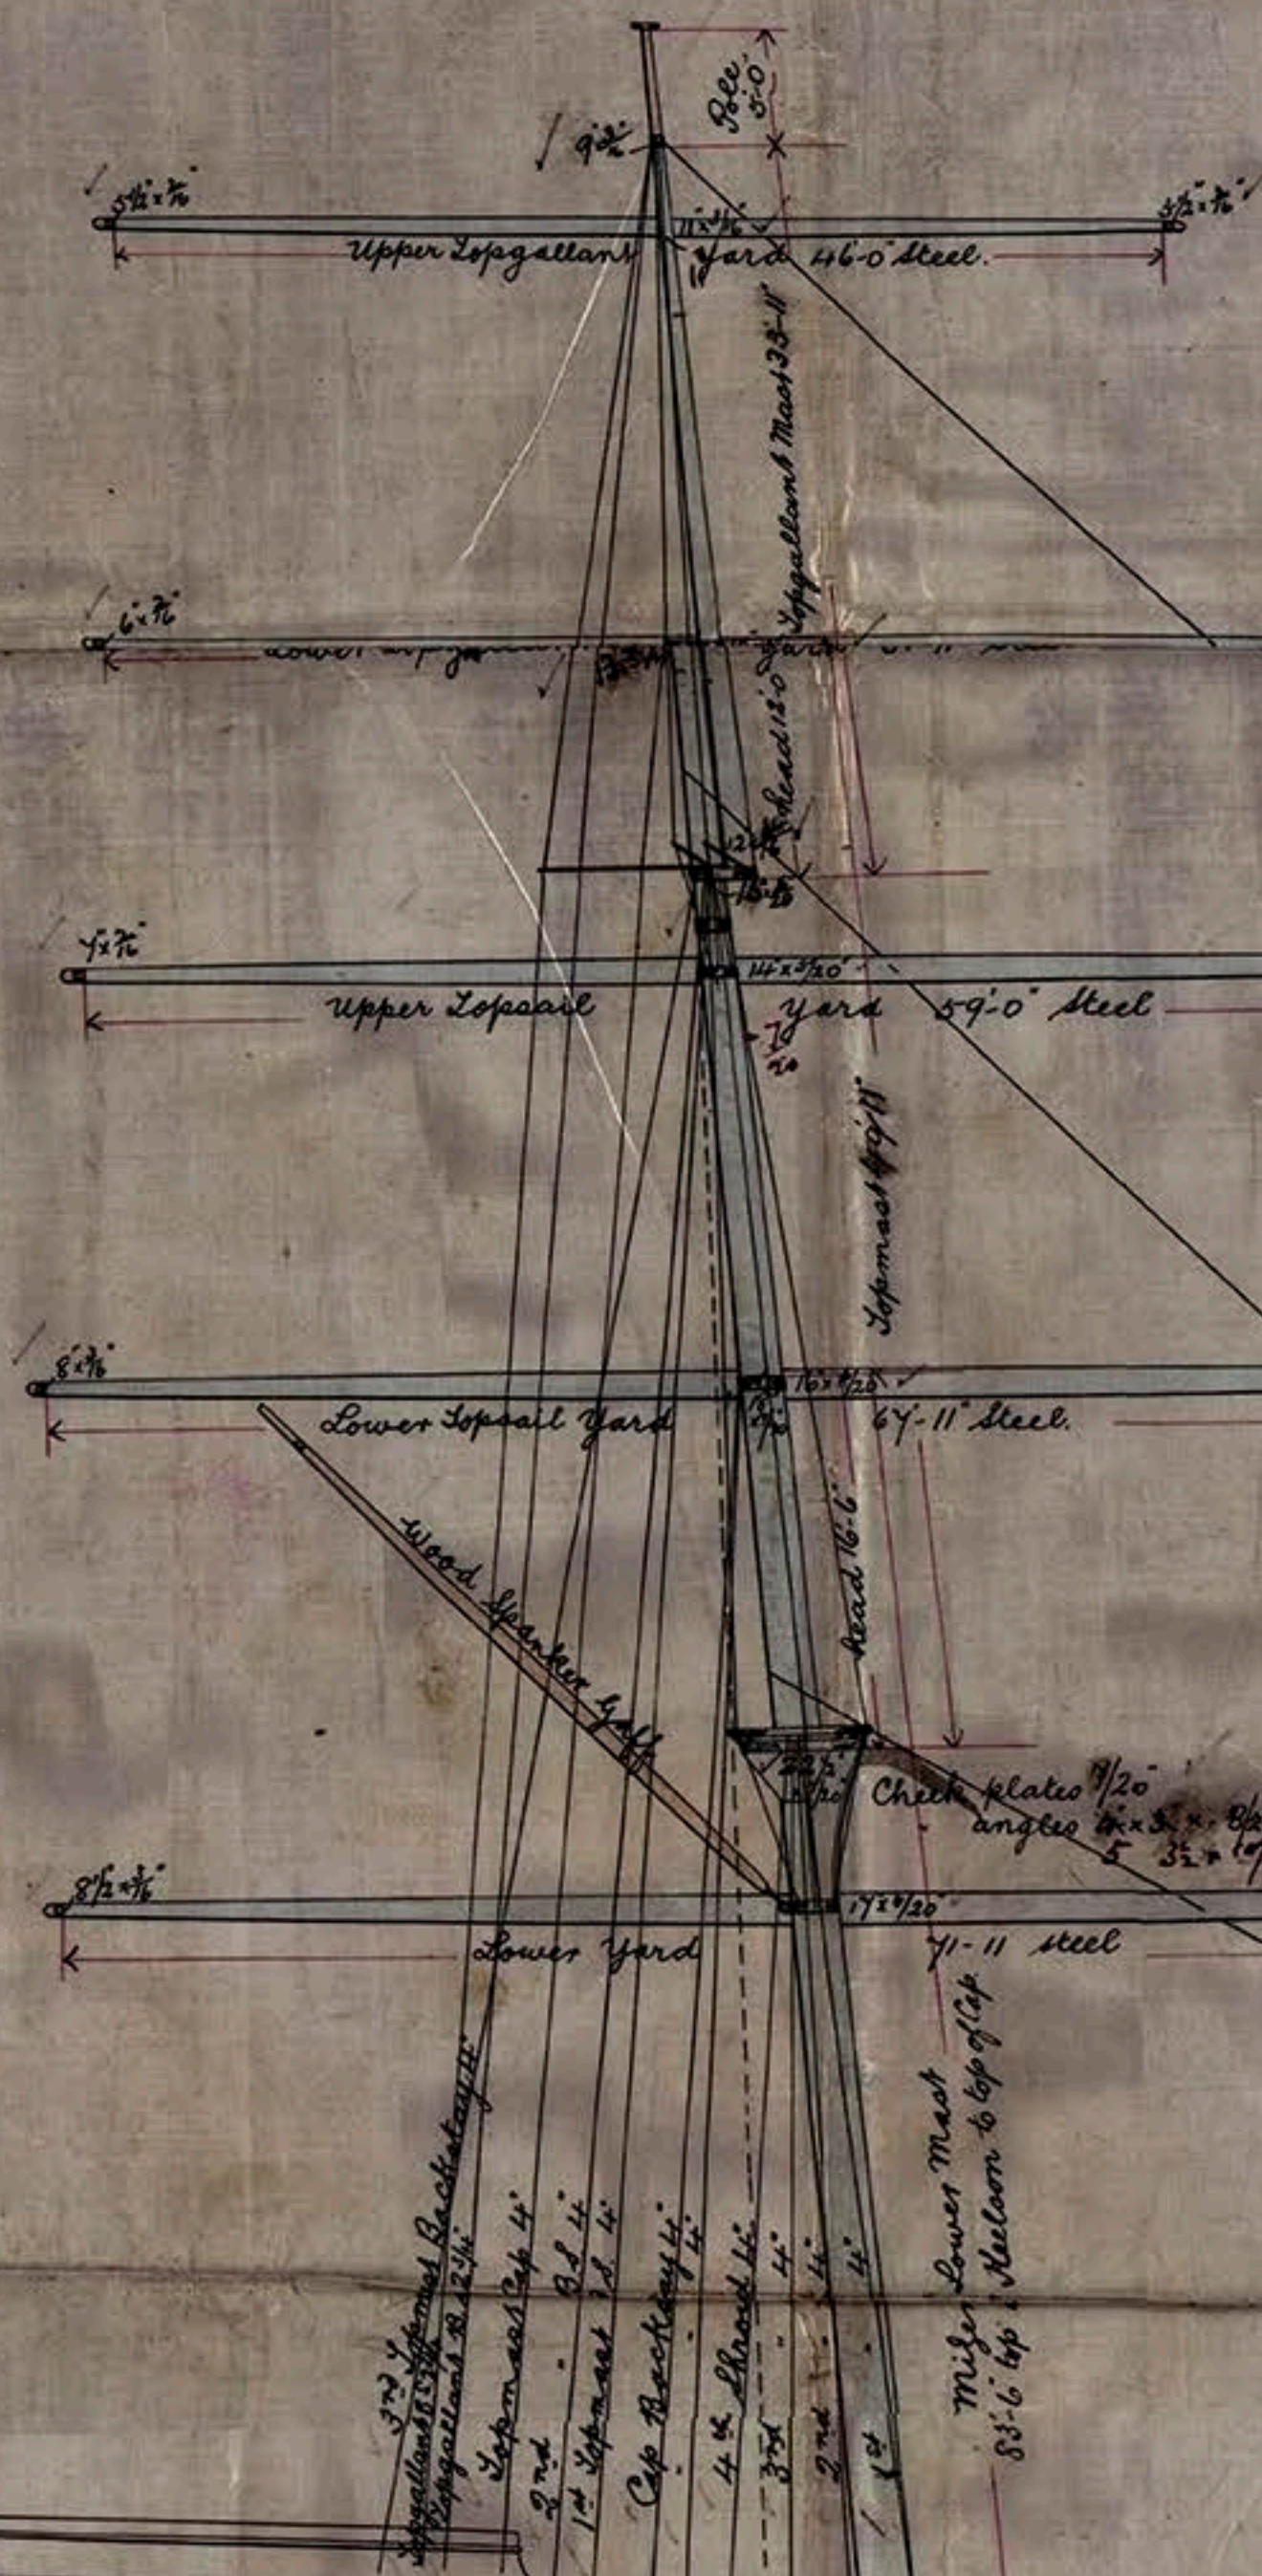


15.3.93

Mizen Mast.

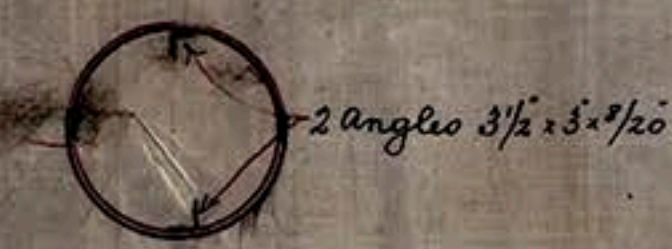

Fore & Main Masts.

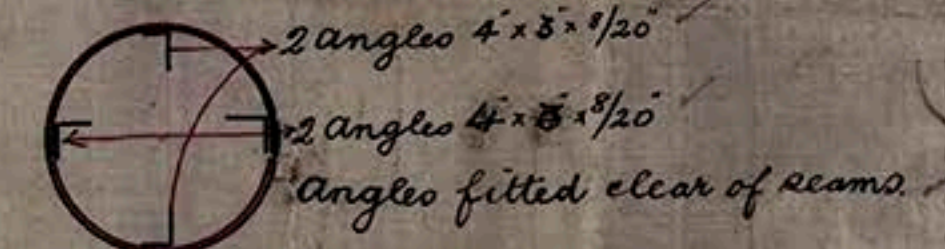



Wire Rigging according to Table 11.

# Rigging Plan

SHIP N° 386

Scale 1/8" = 1 foot

2nd Numeral 23985

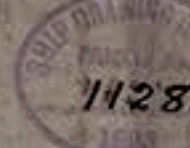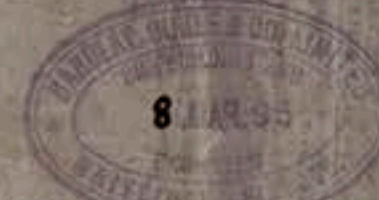

15.3.93

Mizen Mast 2 plates in the round & 2 angles fitted 3 1/2 x 3 1/2 from heel to topmast cap. Butts overlapped & treble riveted above wedging doubling & double riveted below. Seams double riveted.

Main Mast 2 plates in the round & 3 angles fitted 4 x 3 1/2 to above lower topgallant yard. 2 angles fitted 4 x 3 1/2 from heel to topmast cap. Butts overlapped & treble riveted above mast doubling for wedging & overlapped & double riveted below. Seams double riveted.

Fore Mast 2 plates in the round & 2 angles fitted 4 x 3 1/2 to above lower topgallant yard. 2 angles fitted 4 x 3 1/2 from heel to topmast cap. Butts overlapped & treble riveted above mast doubling for wedging & overlapped & double riveted below. Seams double riveted.

All topmasts to have two plates in the round & seams single riveted. Butts overlapped & treble riveted, doubled at way of lower mast cap & sheave holes luffed below.

All lower masts doubled at wedging at deck and at heel.

All yards two plates in the round & seams single riveted. Butts overlapped & treble riveted, doubled in 8' beyond along hoops.



*J. J. W. 11. 2. 18*

[illegible]


[illegible]

11.2.73

1019 41799-2  
 25679183  

© 2018  
Lloyd's Register  
Foundation