


Ship "Bon-Lou" Morgan Report 18.12.88

30.3.93

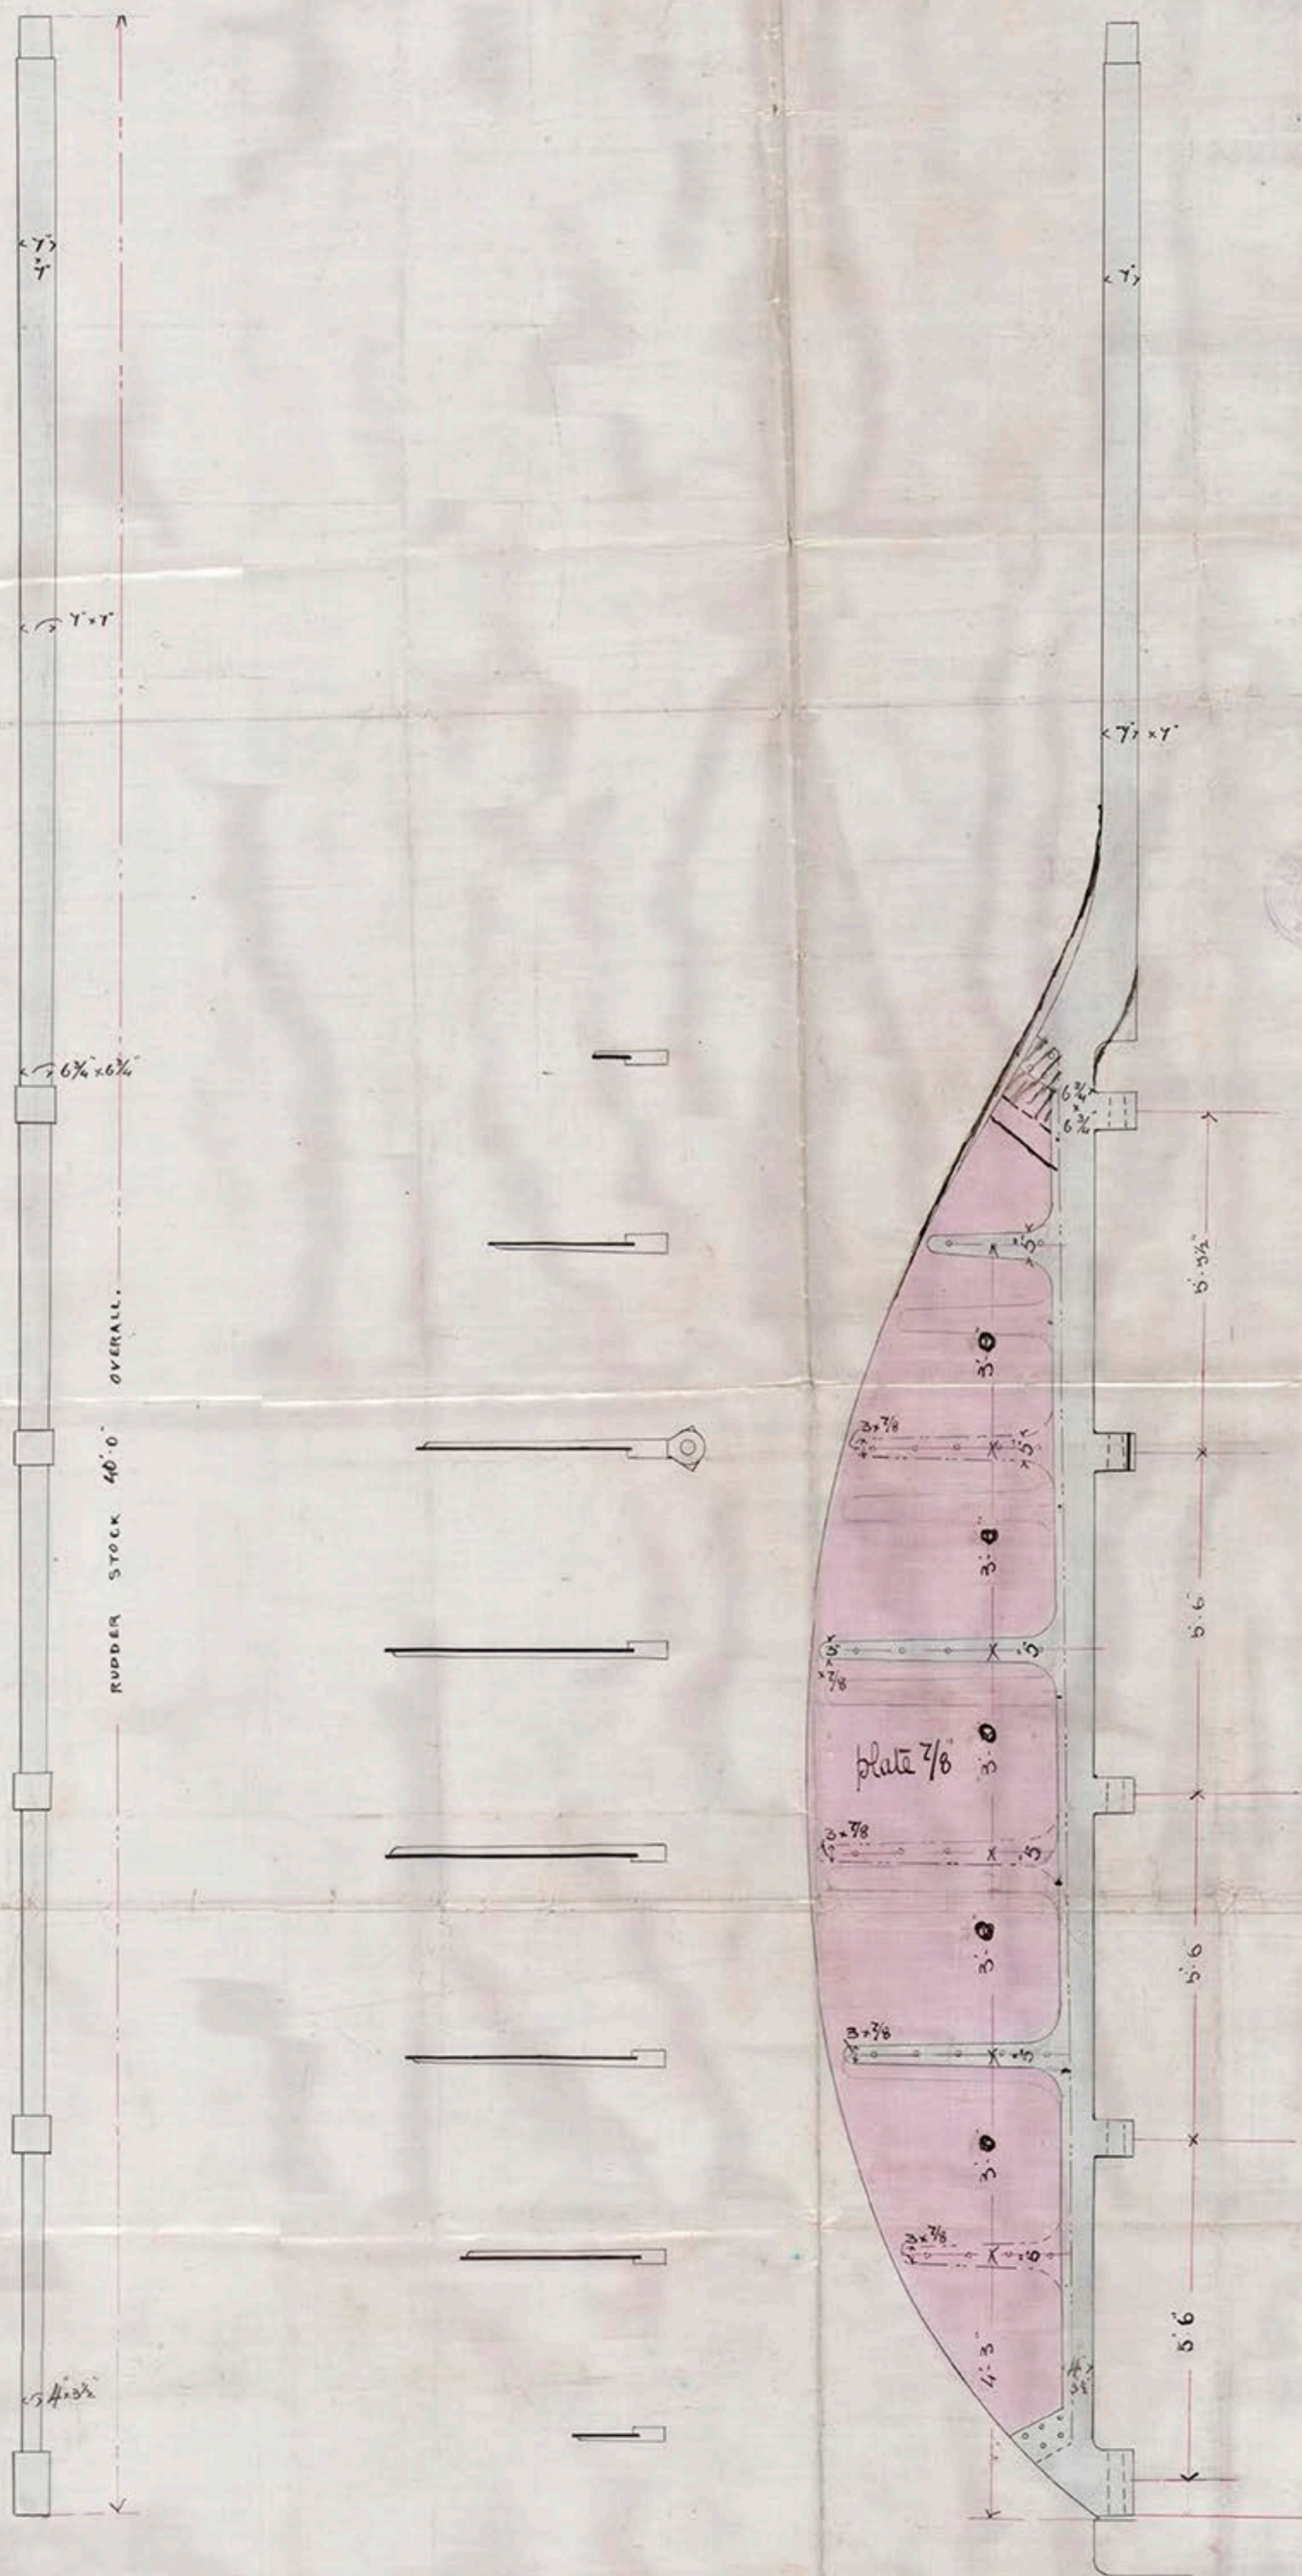


— RUDDER PLAN —
or
— SHIP N° 386 — 9384

SCALE 1" = ONE FOOT

Rivets 1 1/8 dia

J.L. 29.3.93

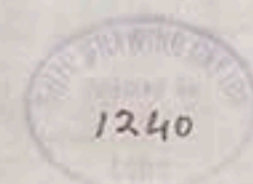

Ship "Ben-Lee" Glasgow Report No. 12532.

30.5.03

SHIP No 386
 Rudder Plan
 12.10.03
 12.10.03

