


Nº 540.
PLAN OF STERN FRAME.
SCALE - $\frac{1}{2}$ " = 1 FOOT.



NOTE: scantlings & arrangements of sternframe subject to modification if necessary, on approval of plan of ship's rudder

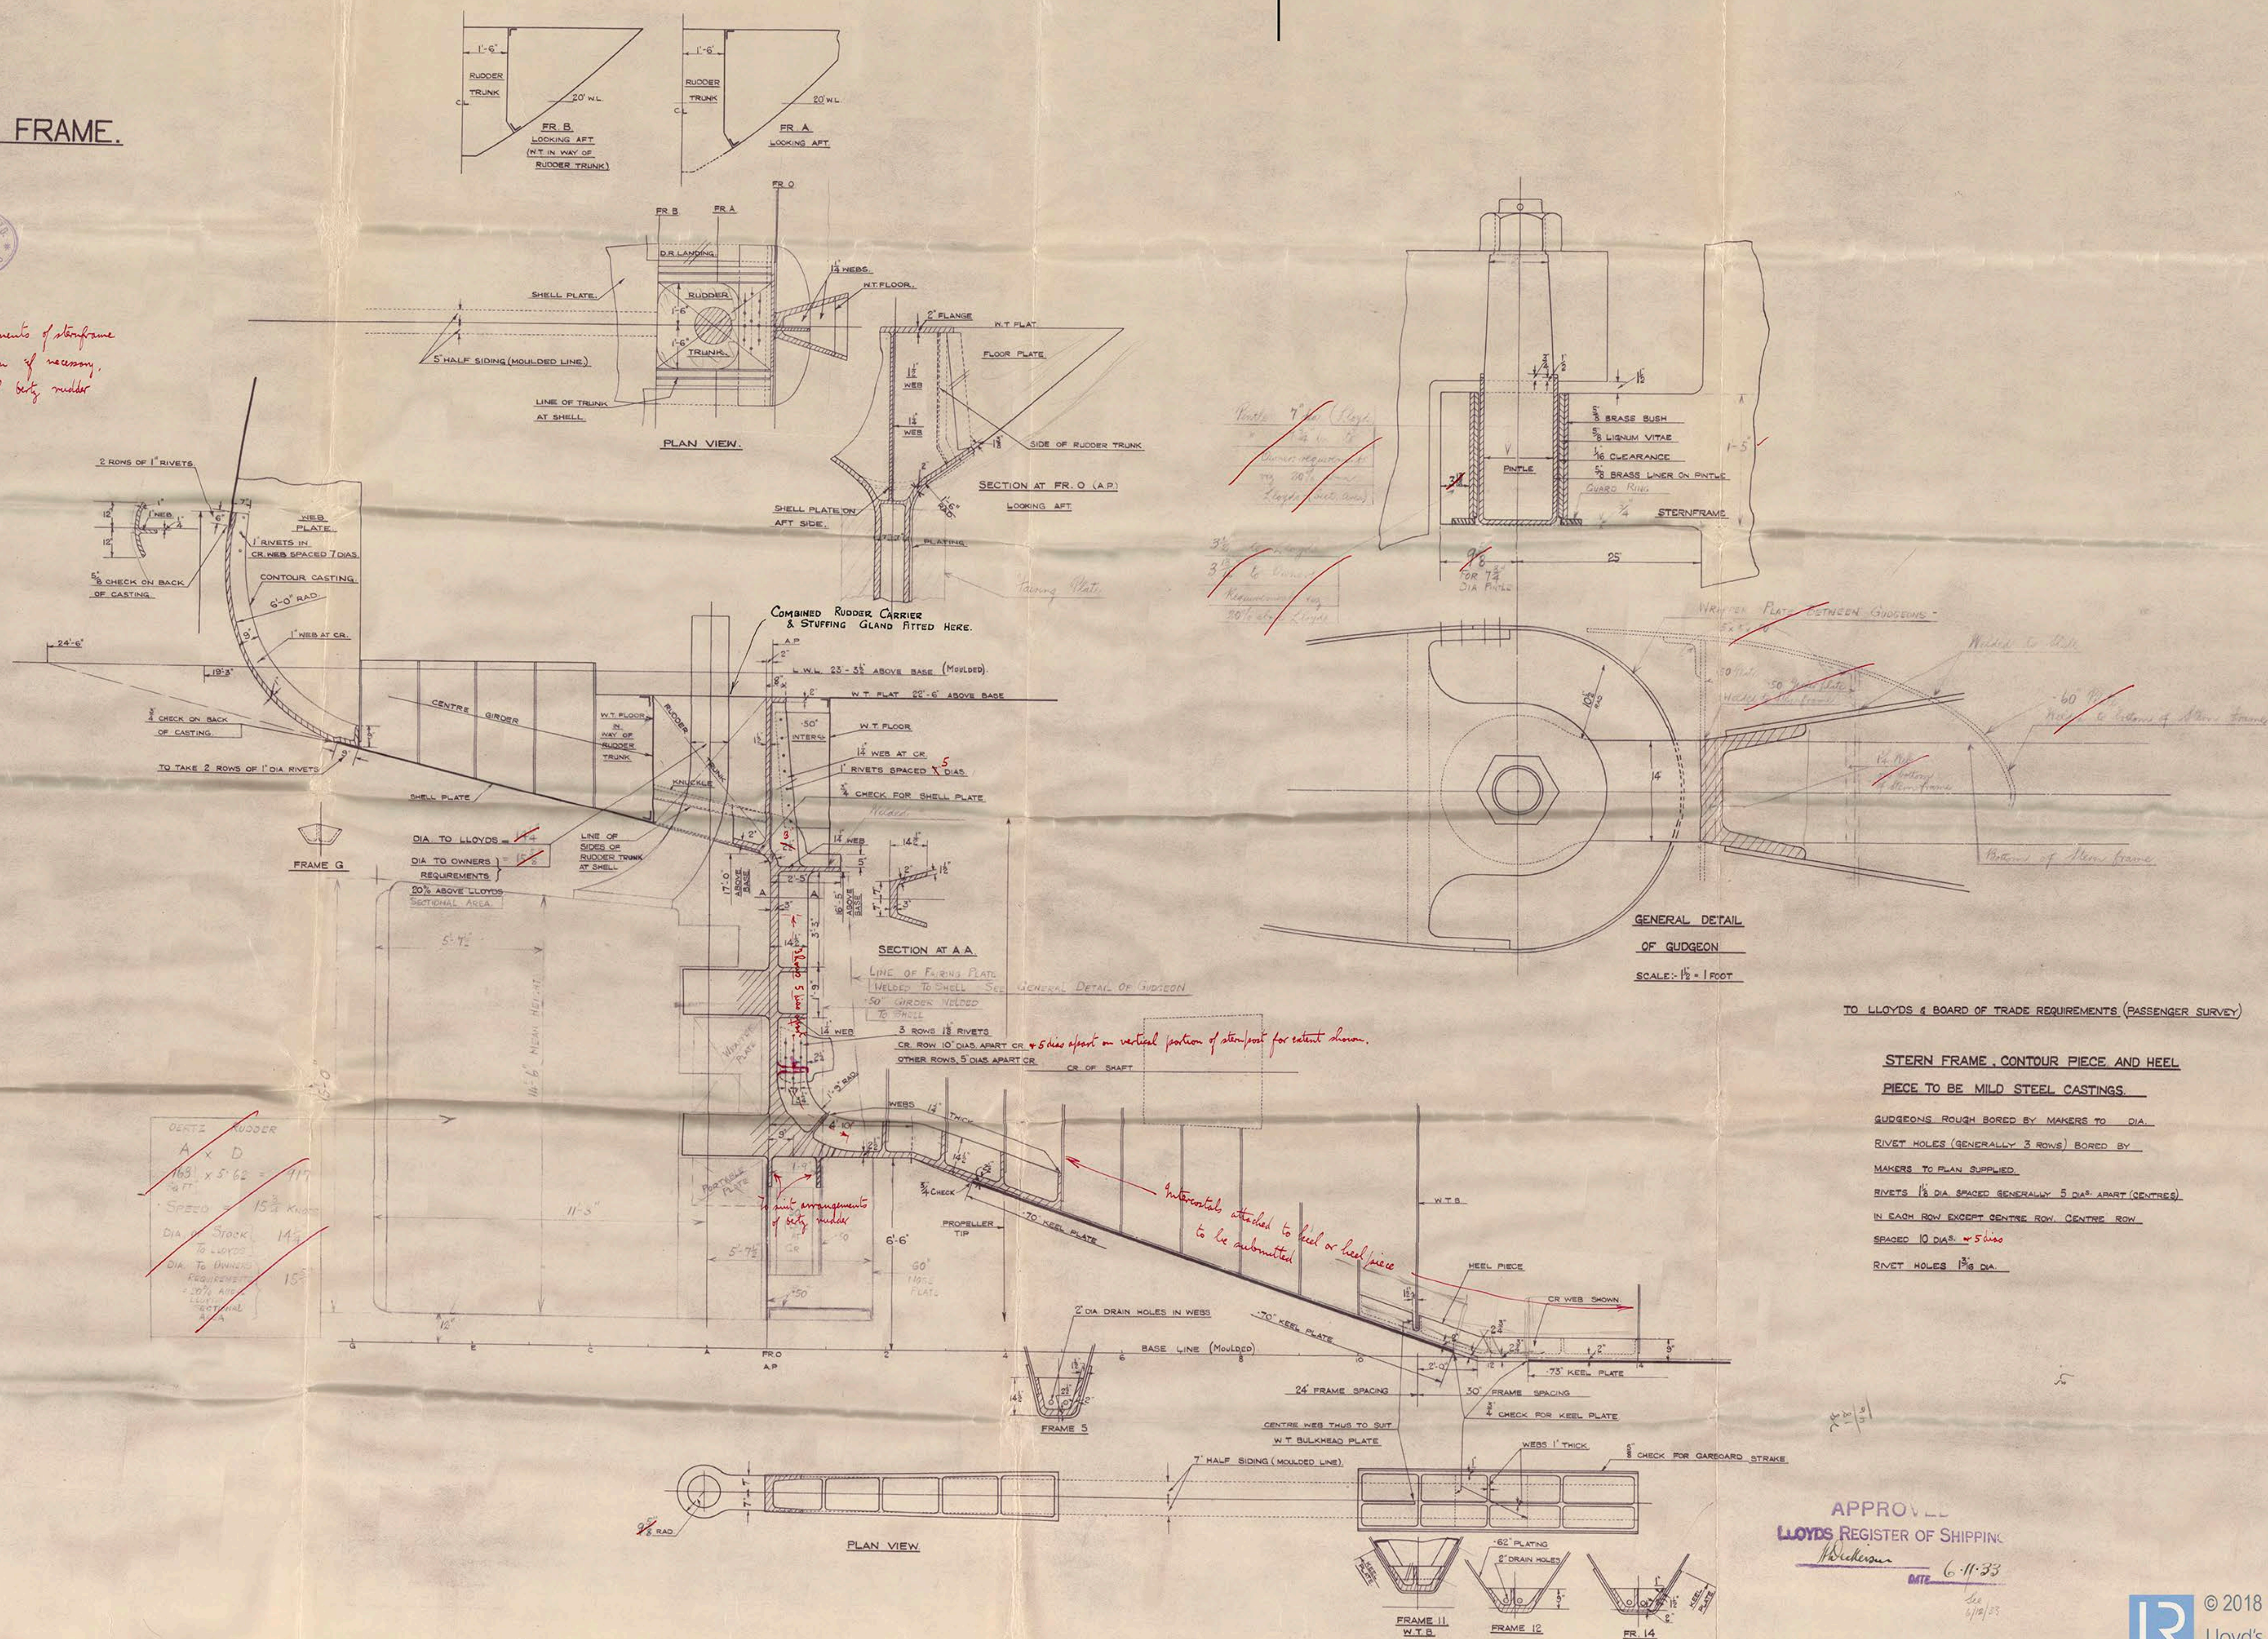

Glasgow

Messrs. Allen Stephen & Sons
Ld

Yard No 540

Plan of Sternframe

Manoora

GLASGOW REPORT No. 55412



© 2018

Lloyd's Register
Foundation