

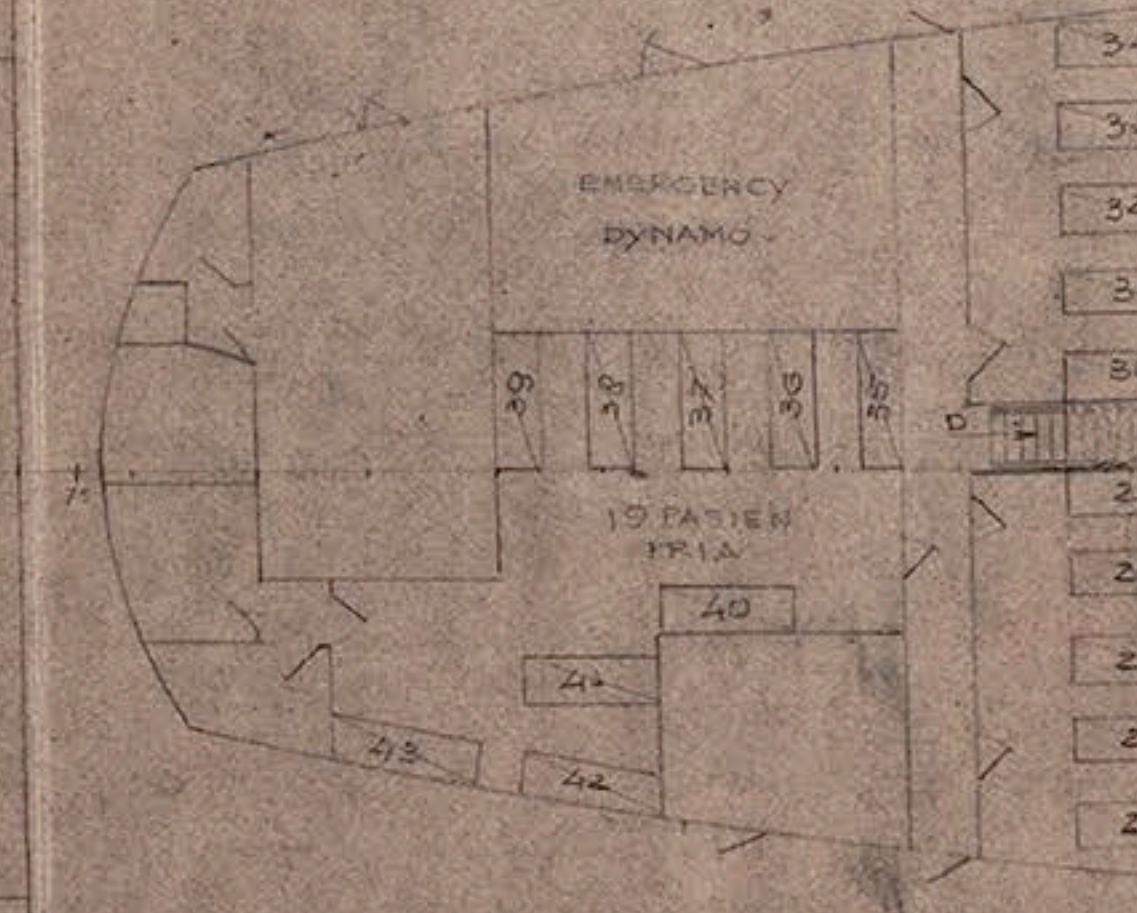



NO 176-426
250 PASS

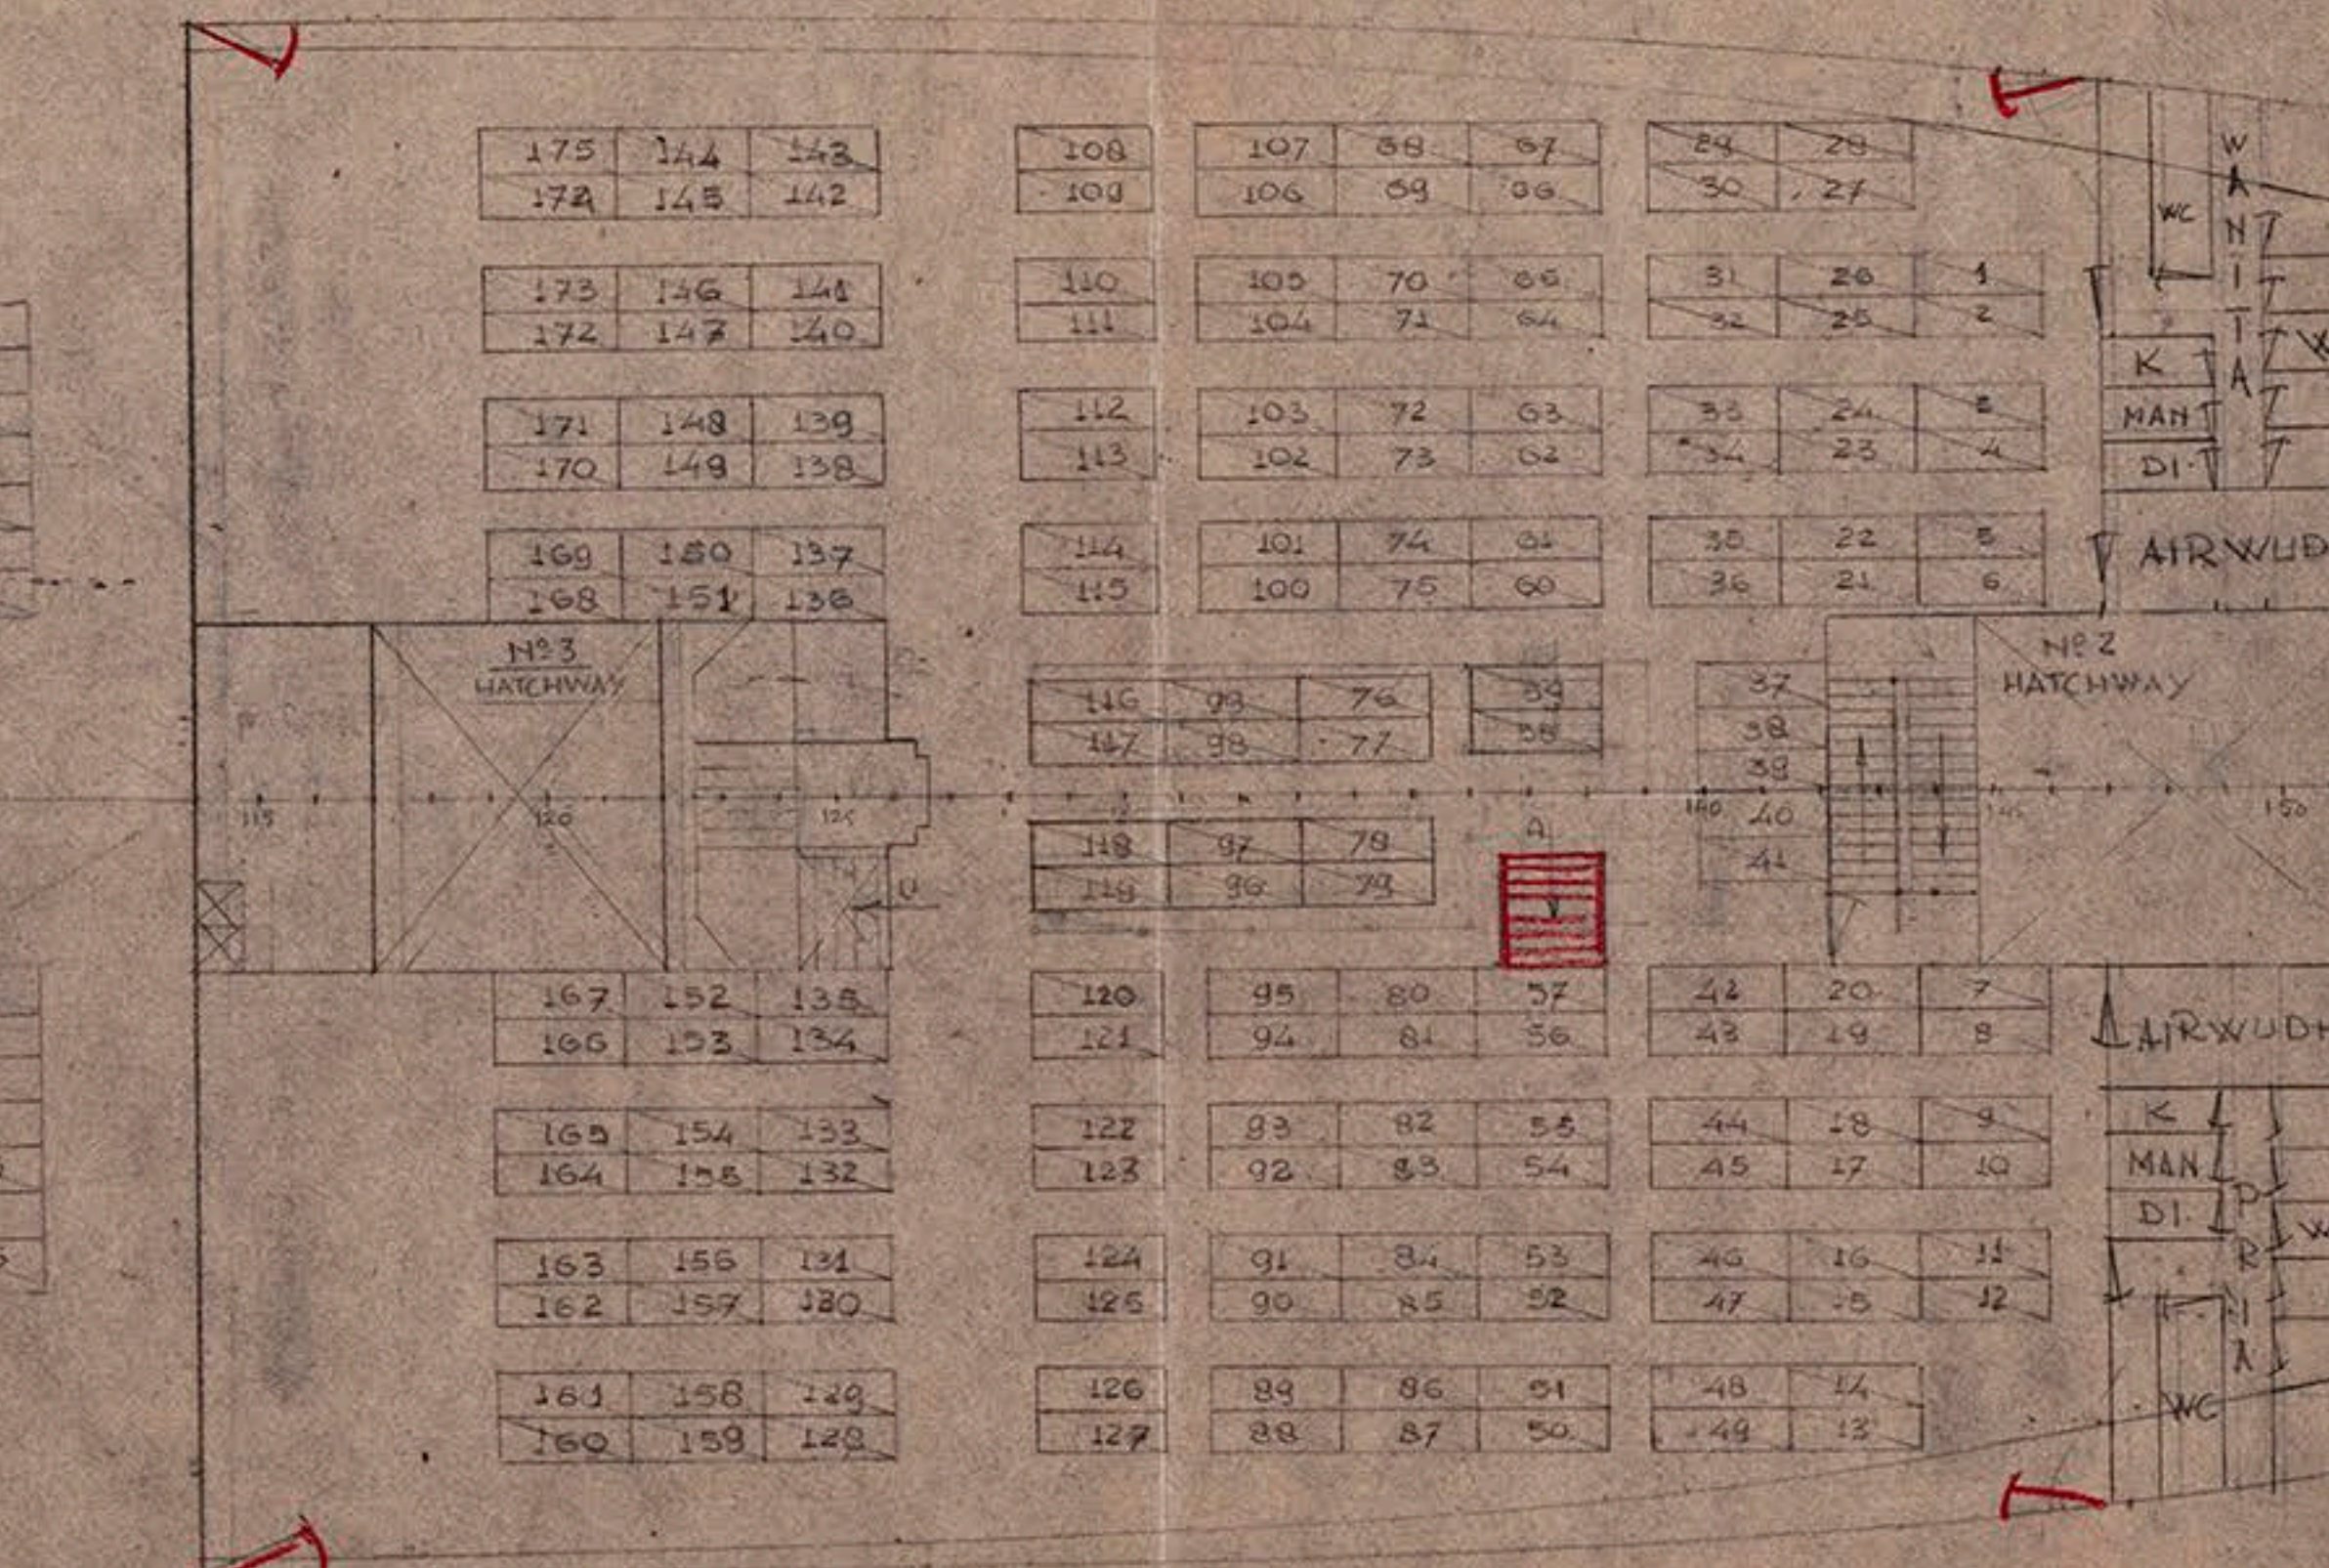

PERUBAHAN HOSPITAL + MASIK
& SMOKING DI BRIDGE DECK DI
HOSPITAL UNTUK 43 ORANG

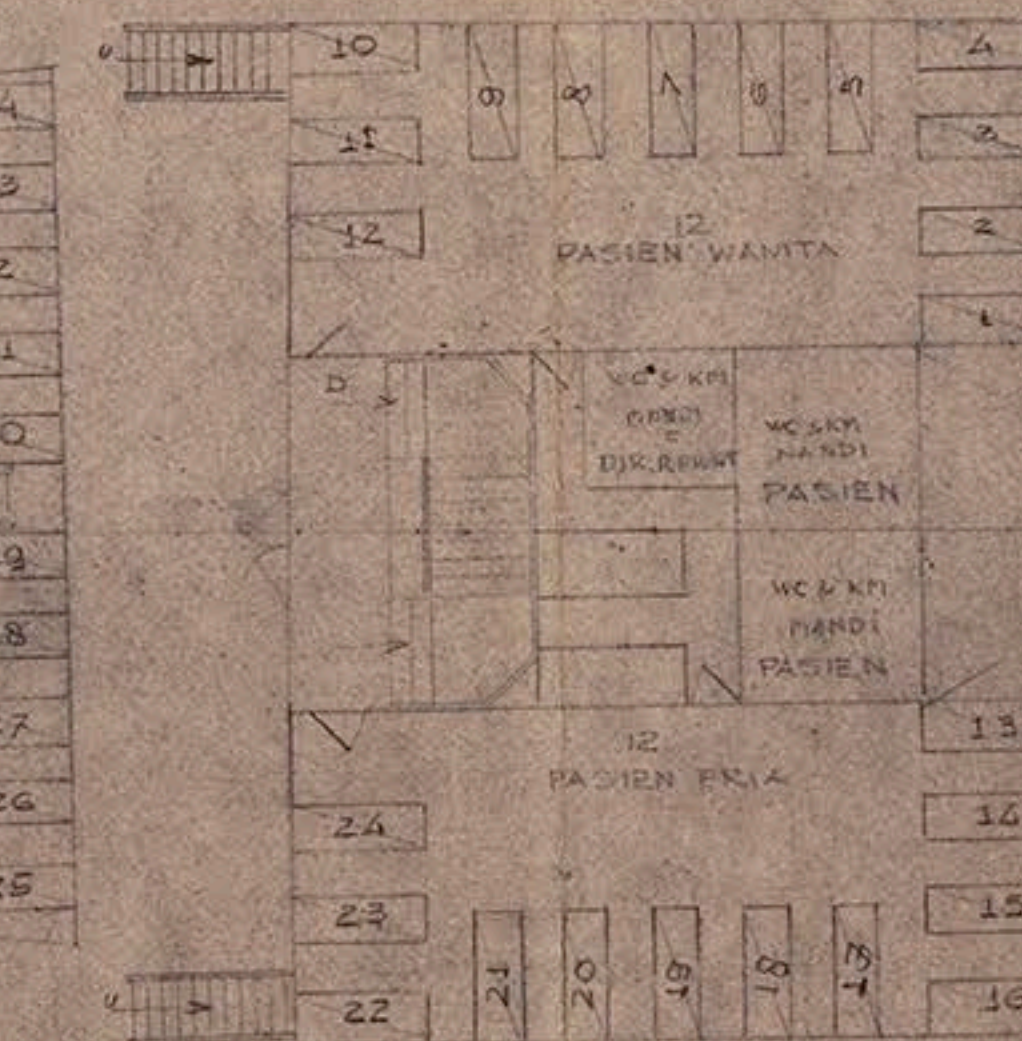

UPPER DECK: 175 PASS.
NO 1-175

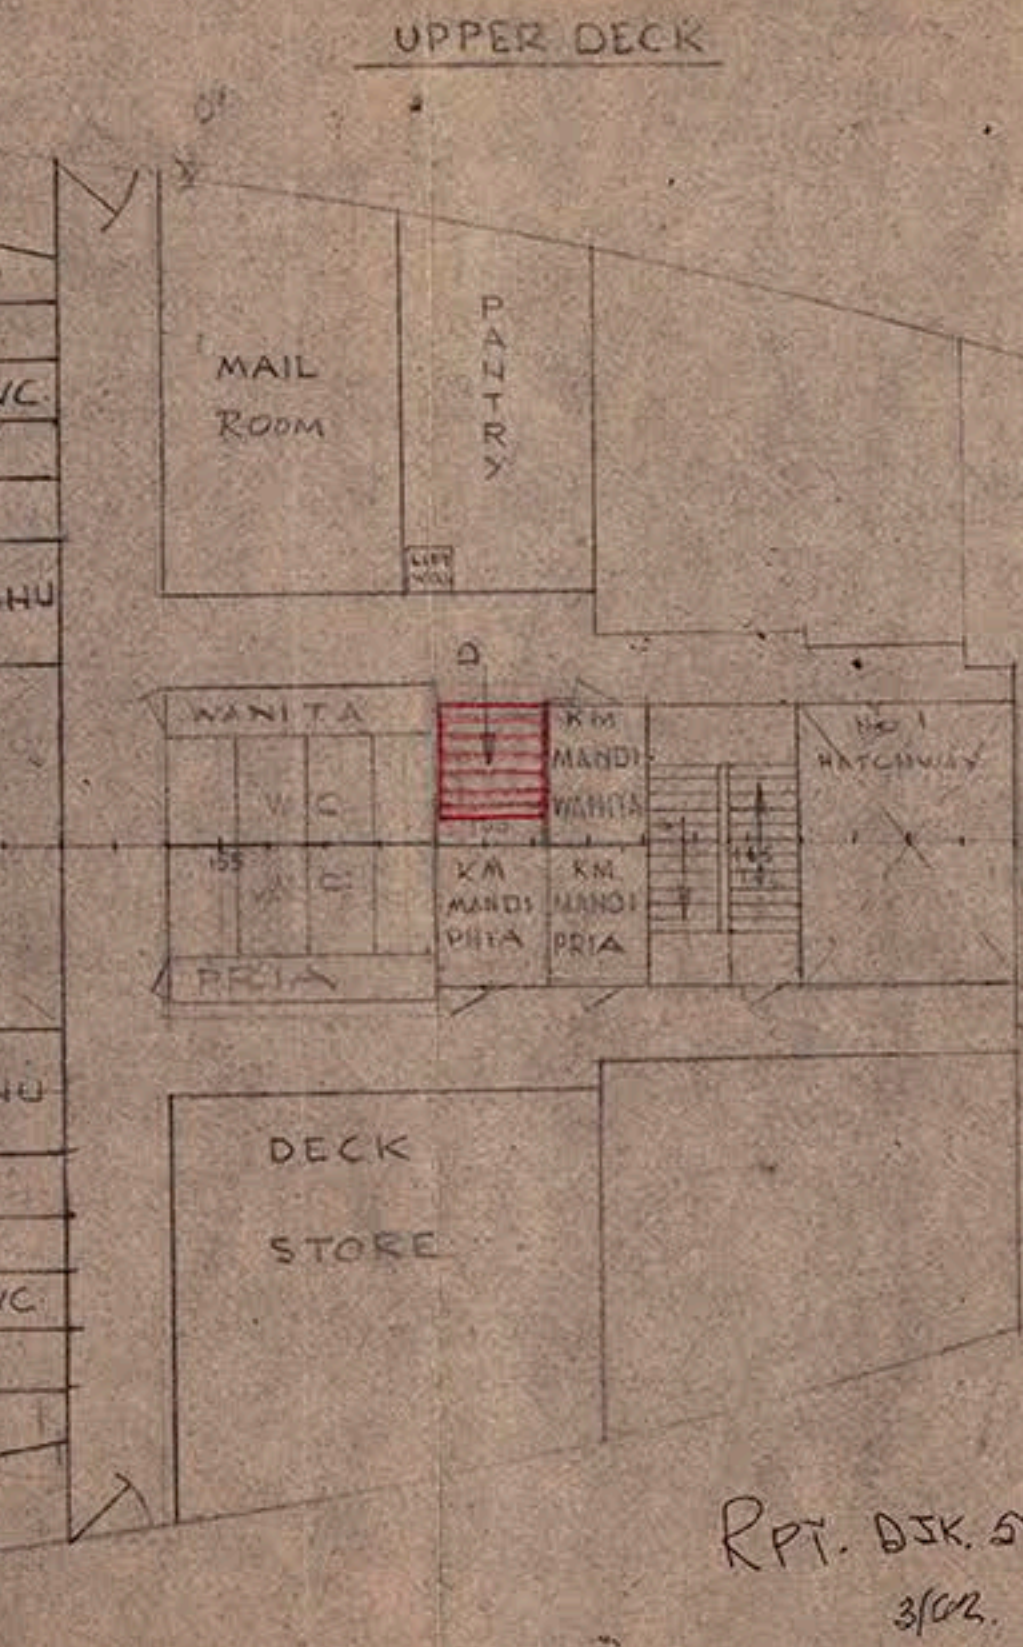

KM AMBULOMBO

RPT. DJK. 5971
3/02.

Noted
See letter
12/2/1966

