



X New tank to be
common with mid
tunnel tank under

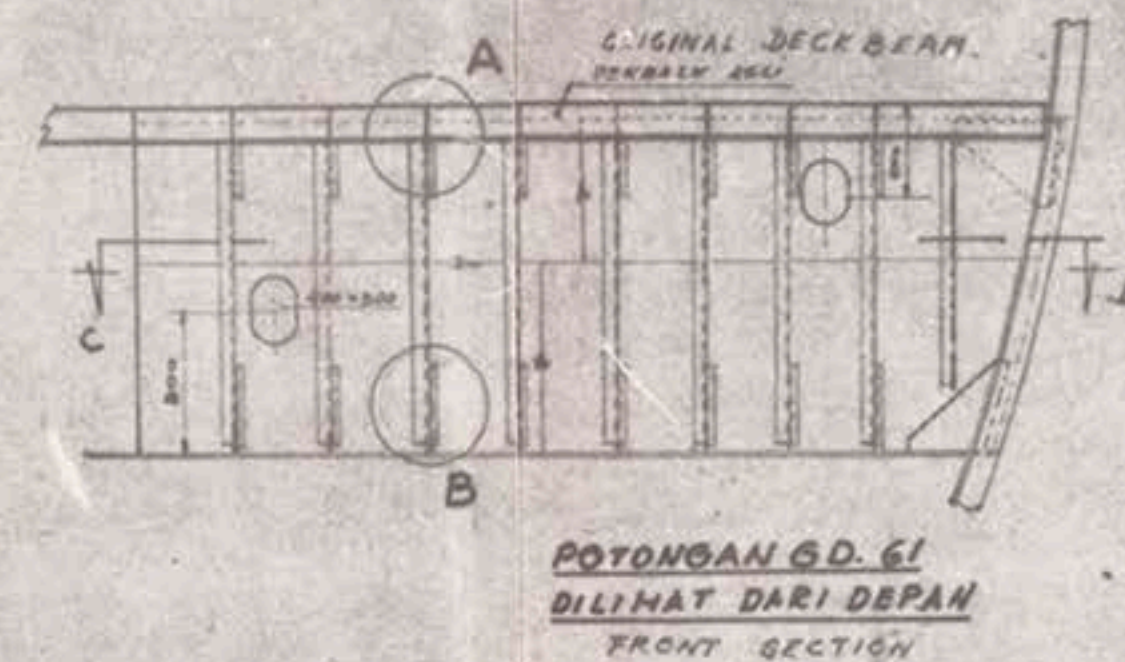



POTONGAN G.D. 61
DILIHAT DARI DEPAN
FRONT SECTION




SECTION
POTONGAN C-D

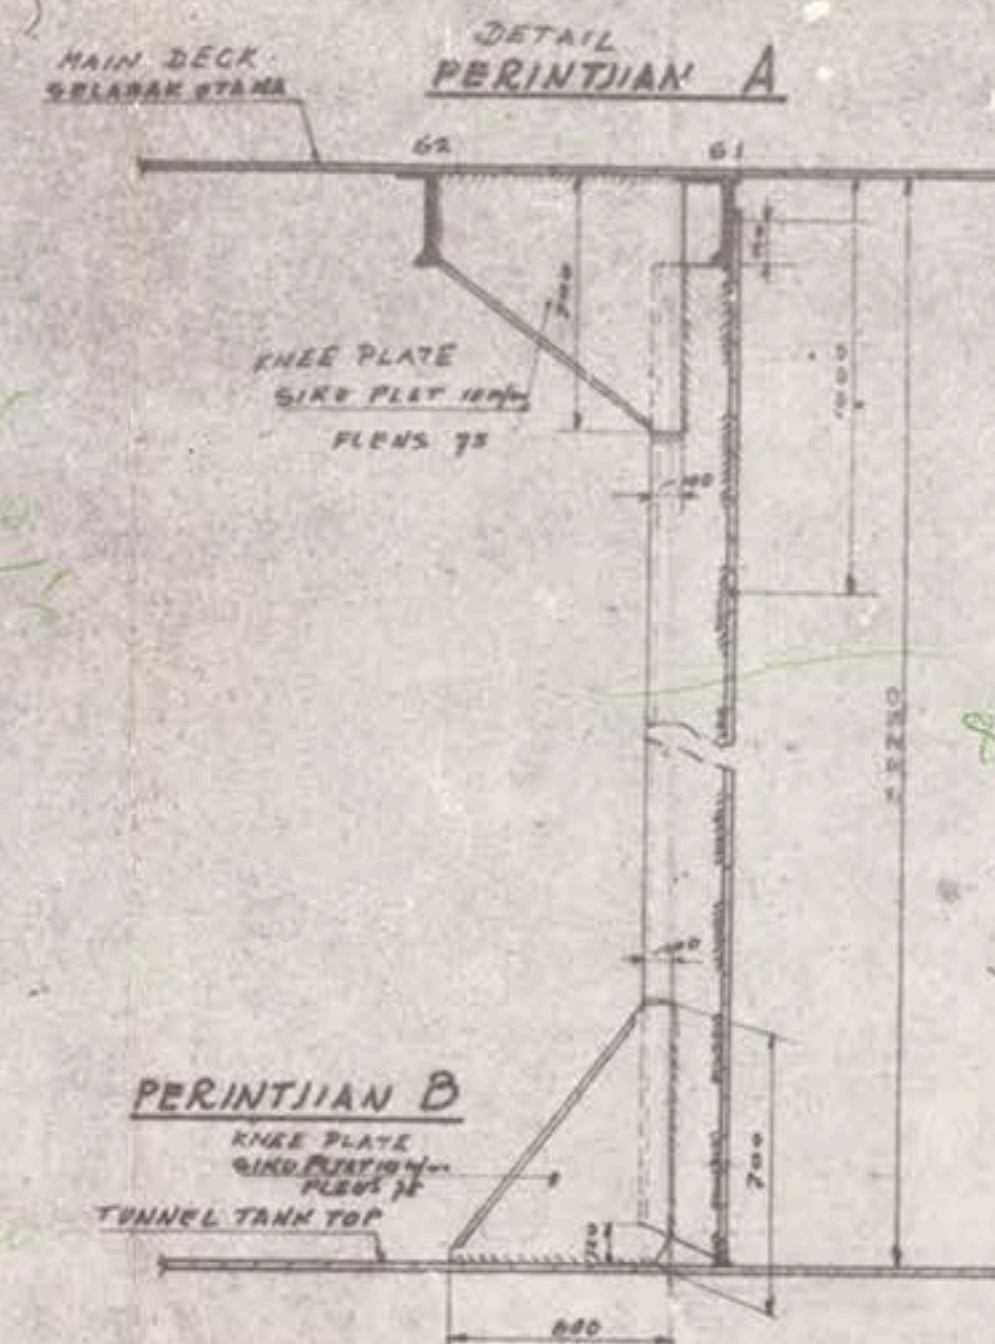

PERINTJIAN B

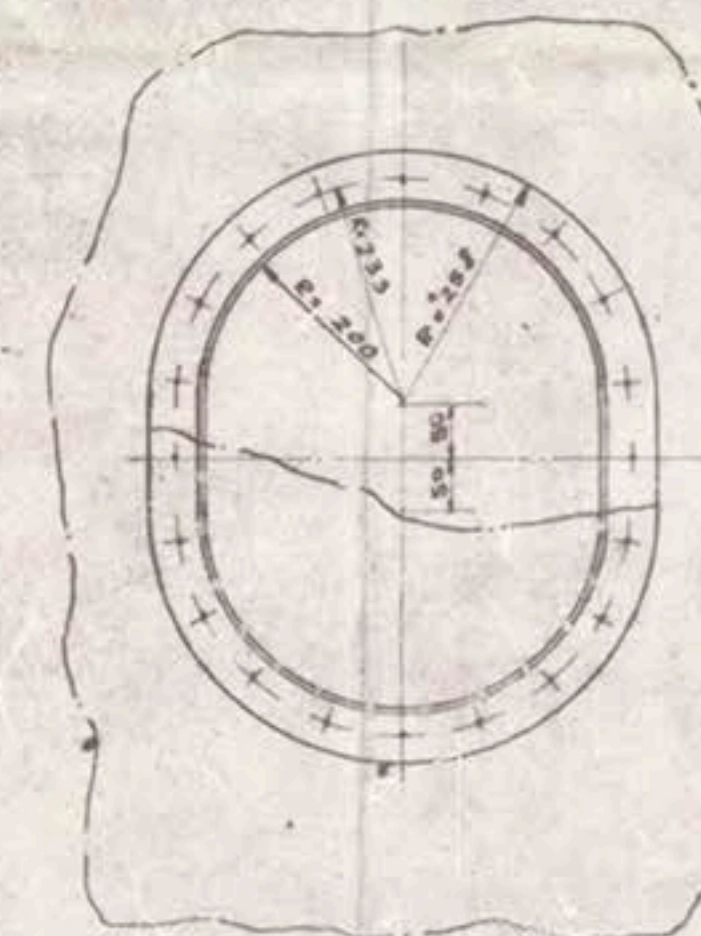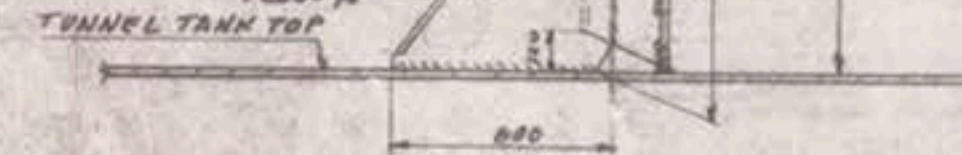

DETAIL "MAN HOLE"
PERINTJIAN LOBANG ORANG

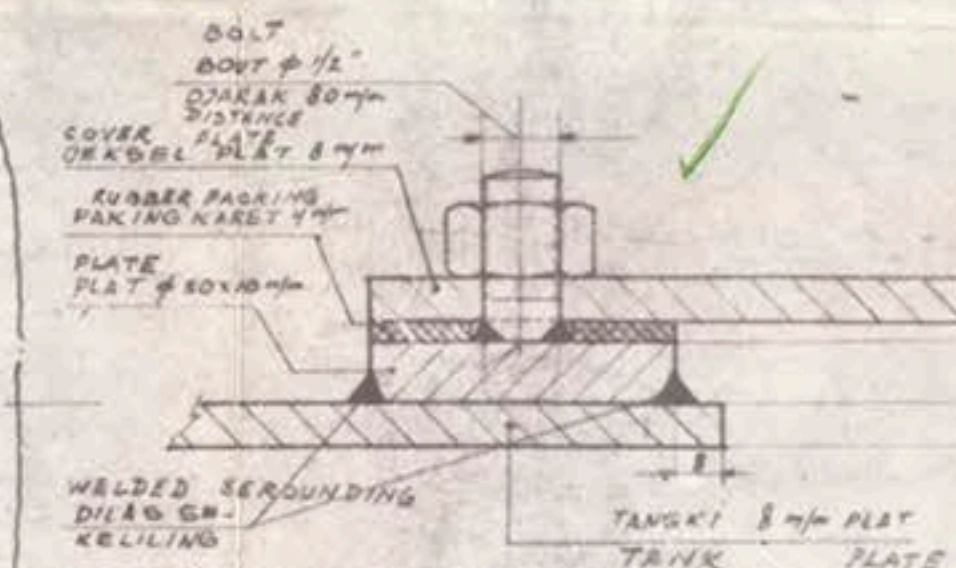

CAP. 117 M³ (EACH TANK)
ON TUNNEL TANK PLATE, TO MAKE
WATER HOLES 300x400.
BETWEEN EVERY 2 FRAMES 3 HOLES.

Office Copy

10-11-62

LOUIS REGISTER OF SHIPS
SINGAPORE

EAGLE ENGINEERING CO.
NO. 6, KUNG CHONG ROAD,
SINGAPORE-3.

SCALE	DATE	REMARKS
DIPOLA		
DIPERIKHA		
TANGKI AIR TAWAS		© 2018
FRESH W. TAN		AMBULOM-BO
PN. PELN		
TAND. PRIUK		

TANGKI AIR TAWAR © 2018

P.N. PELNI
TAND. PRIUKOMKATA

L Lloyd's Register
Foundation