


"EMPIRE CELTIC" / 601.

SHELL & DECK REPAIRS - JULY 1953.


1310 / 7286.

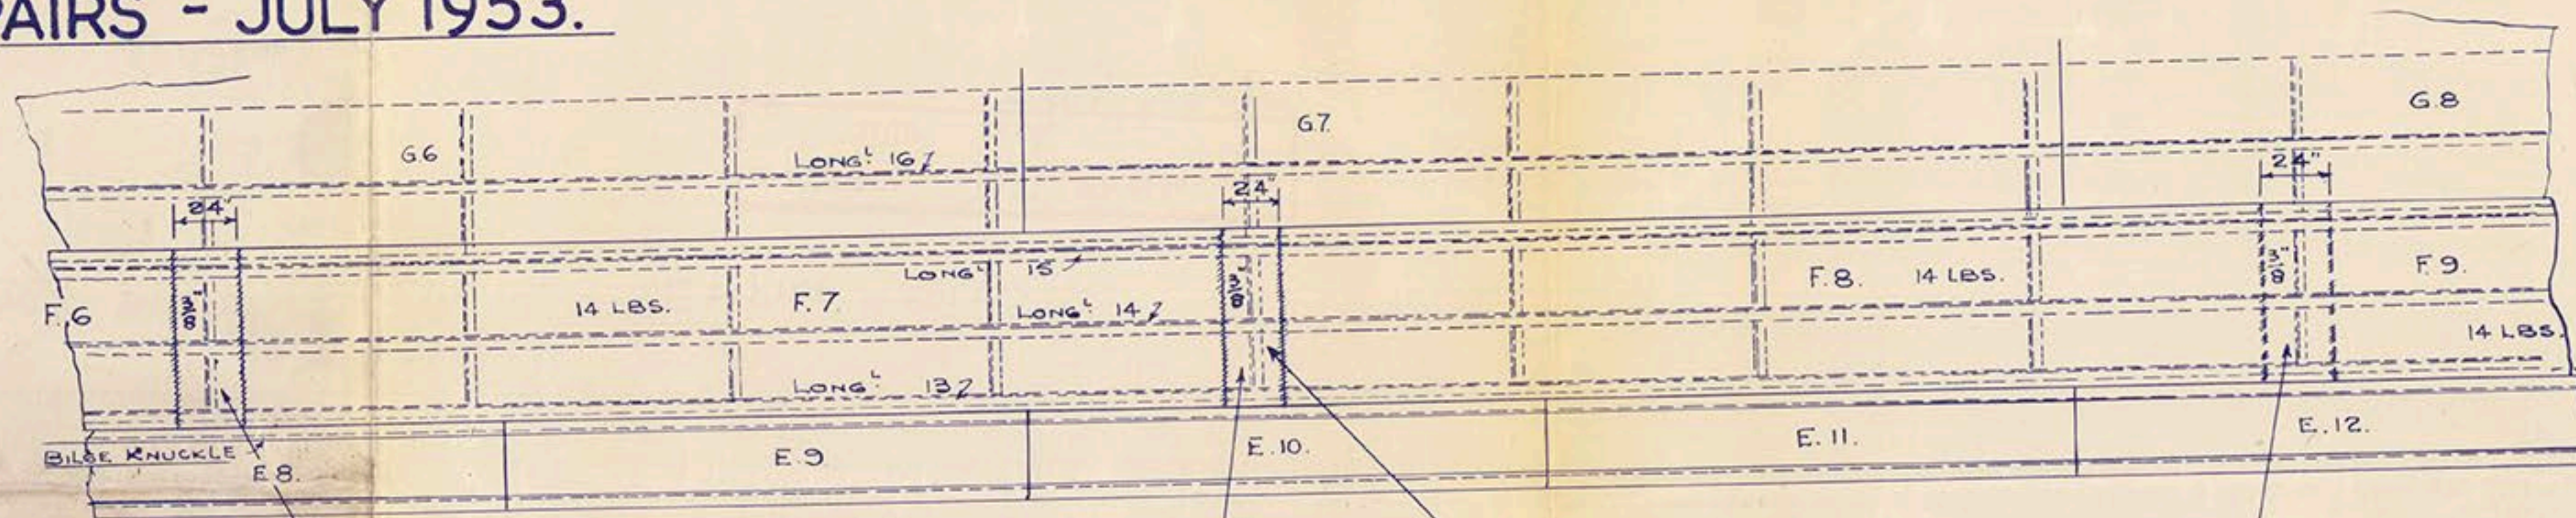

STARBOARD SIDE SHELL PLATES F.6 & F.7; F.7 & F.8 ENDS CROPPED AND PART RENEWED WITH 24" WIDE BY 3/8" INSERTION PL.

PORT SIDE SHELL PLATES F.7 & F.8; F.8 & F.9 ENDS CROPPED & PART RENEWED WITH 24" WIDE X 3/8" THICK INSERTION PL.

NOS 1 & 2 HATCHES AFT END CORNERS PORT & STARBOARD

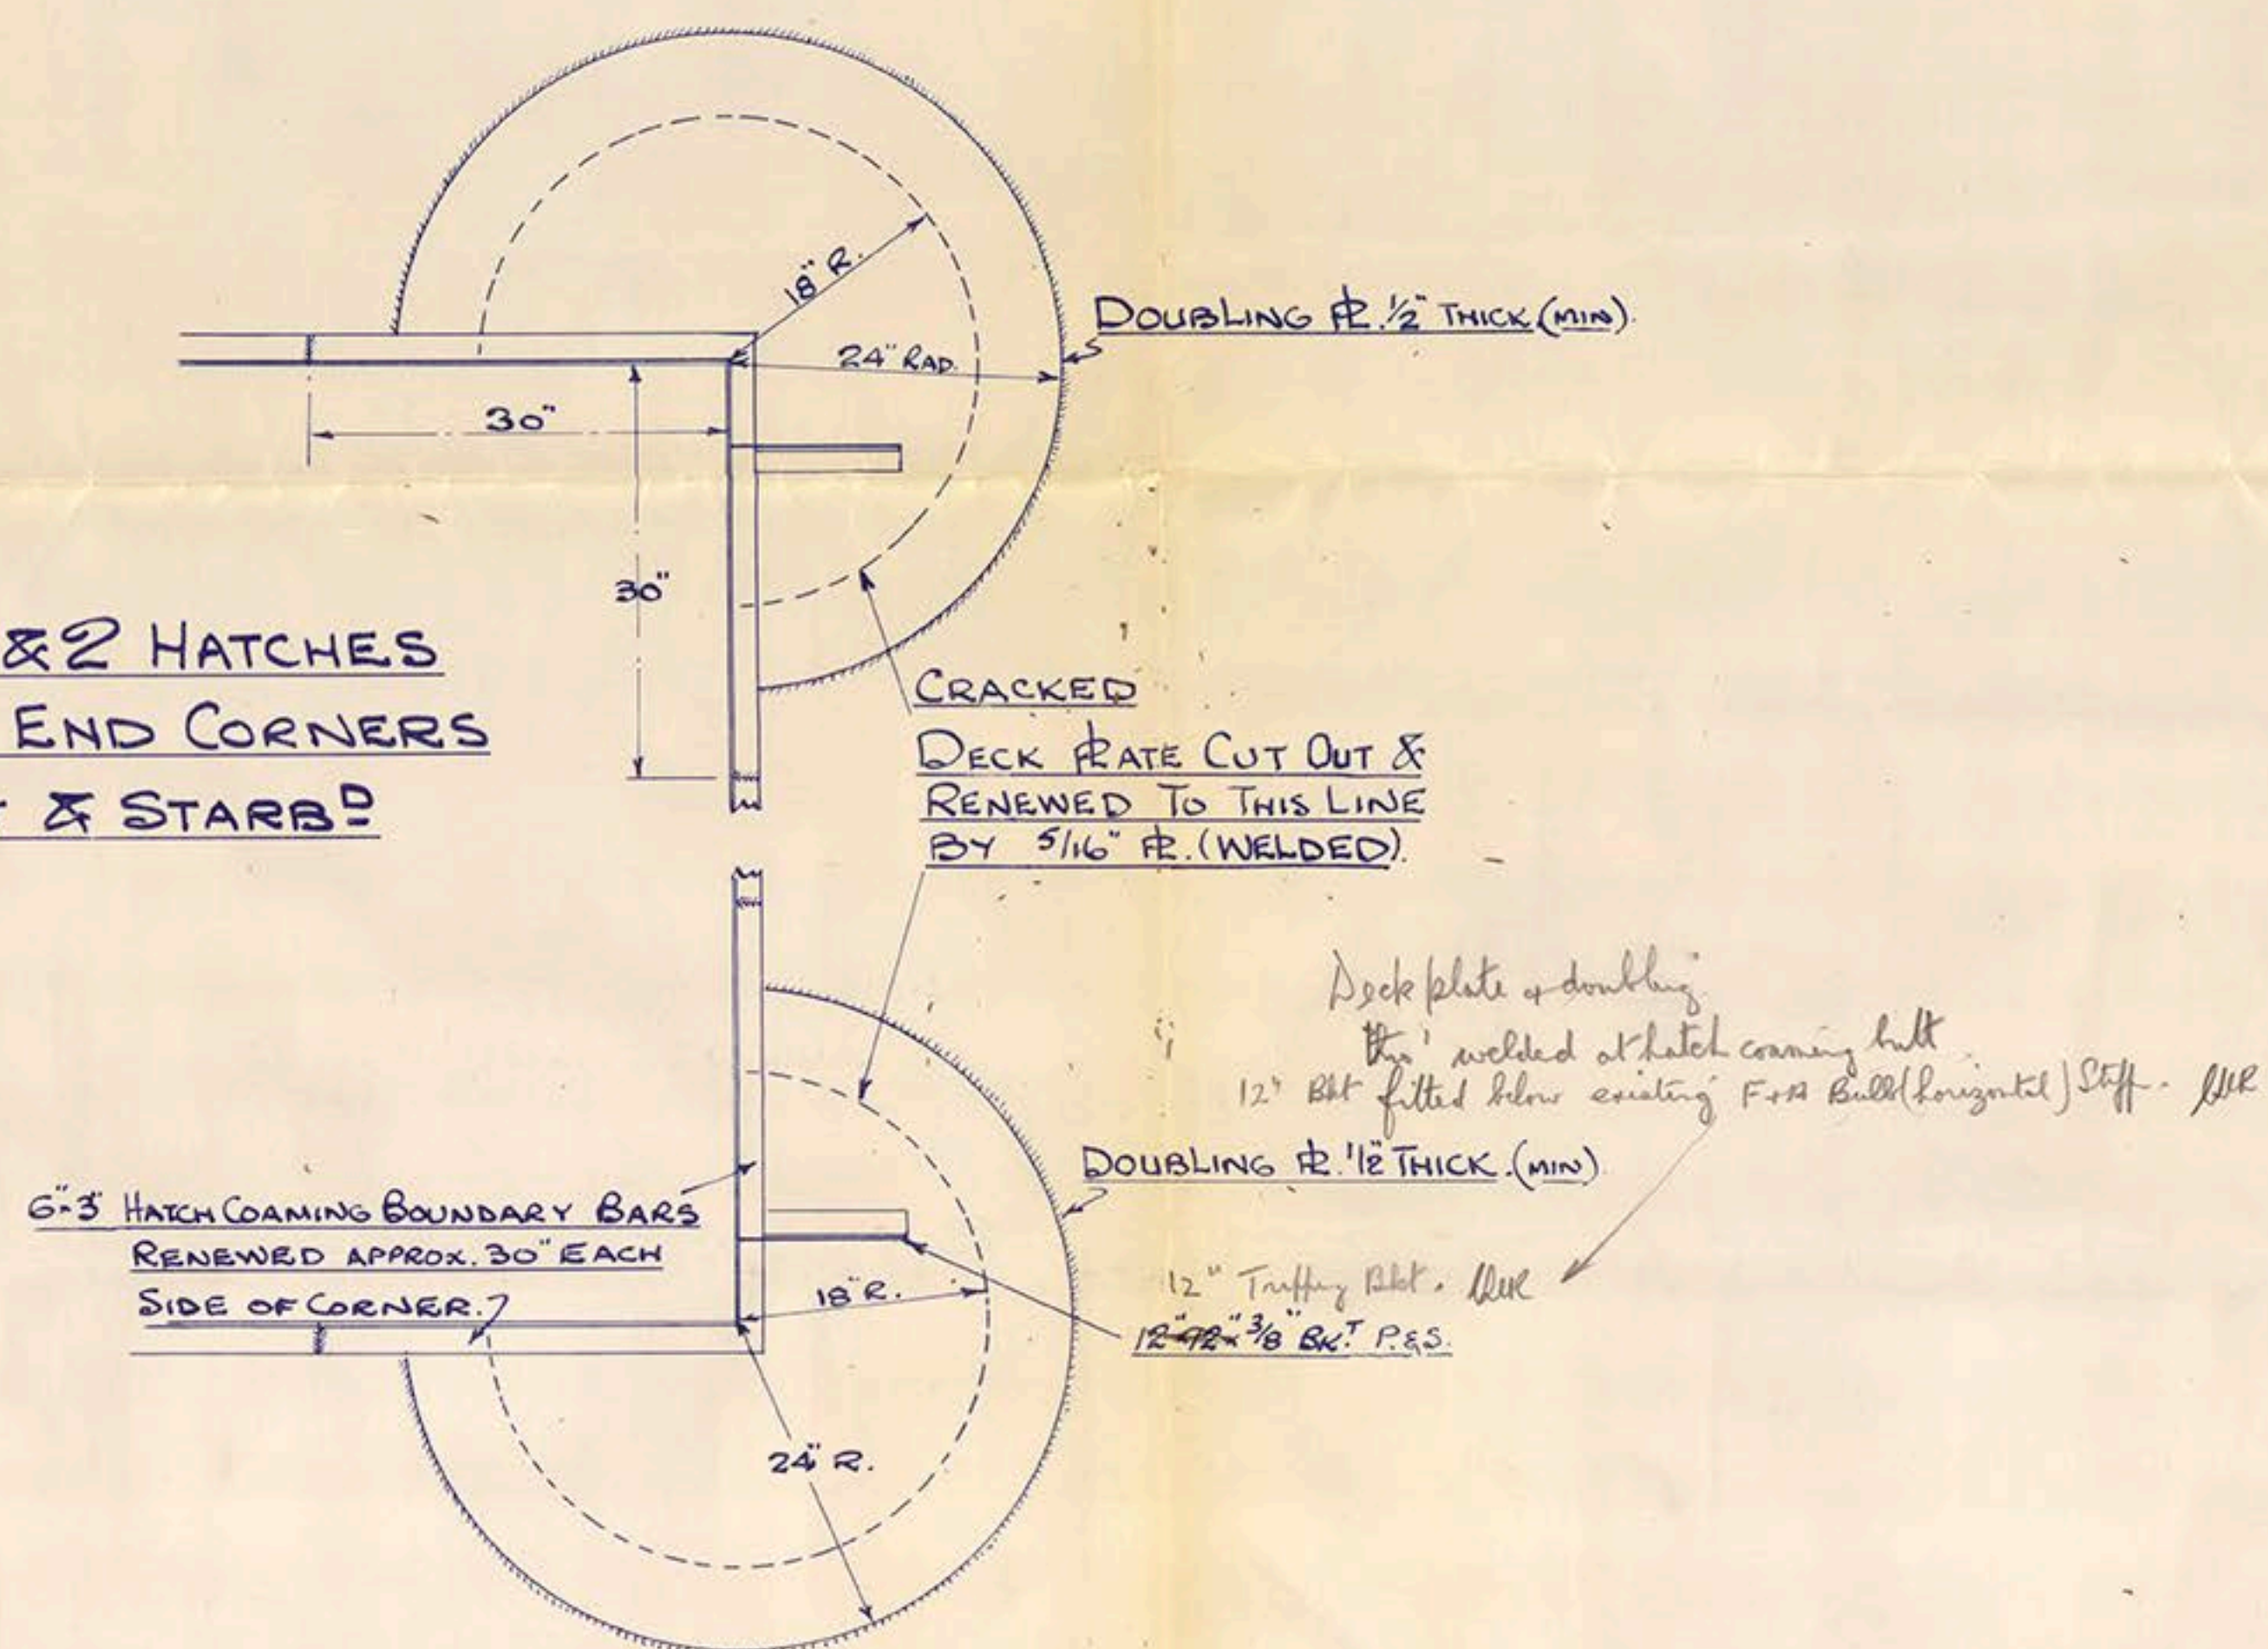

HARLAND & WOLFF LIMITED SHIP REPAIRING & ENGINEERING WORKS NORTH WOOLWICH LONDON	
DRAWN BY <i>A. Nicholas</i>	TRACED BY
CHECKED BY	CHECKED BY
DATE 15-7-53	AMENDED BY

ISSUED TO	DATE

2

Shell & clock repairs



EMPIRE CELTIC

TO ACCOMPANY 127521 REPORT No.
DATED Shell & clock firs.



© 2018

Lloyd's Register
Foundation