

10/11/35

T.S.S. "Arandora Star".

Games & Officers Deck.

Scale $\frac{1}{8}" = \text{one ft.}$

- Section -

Note:- all connections to existing work
may be welded to Surveyor's satisfaction

- Riveting -

Beams to Plating $\frac{5}{8}$ Rivs 7 Dins apart.
Waterway angle to Deck $\frac{5}{8}$ " 5 " "
St Boundary angle to Gunter Plate $\frac{5}{8}$ Rivs 5 Dins apart
" " " to Deck $\frac{5}{8}$ " 5 " "
Remainder of Riveting as shown on plan.
Beams punched for wood 8h $\frac{1}{2}$ Rivs 5 Pitch

Material Mark G.D.


Plates Folio P. 9.
Sections " A. 7.

CAMMELL LAIRD & CO LTD	
BIRKENHEAD.	
FOR ENCLOSURE TO	
Slogda Register	
DATE	10/11/35
SHIP DEPARTMENT.	

TN 31.

DRAWN BY H.B.B.
CHECKED BY

COPY TO	DATE
Plate	30/10/35
Left	
Right	
Repair Dept	
For Harvey	

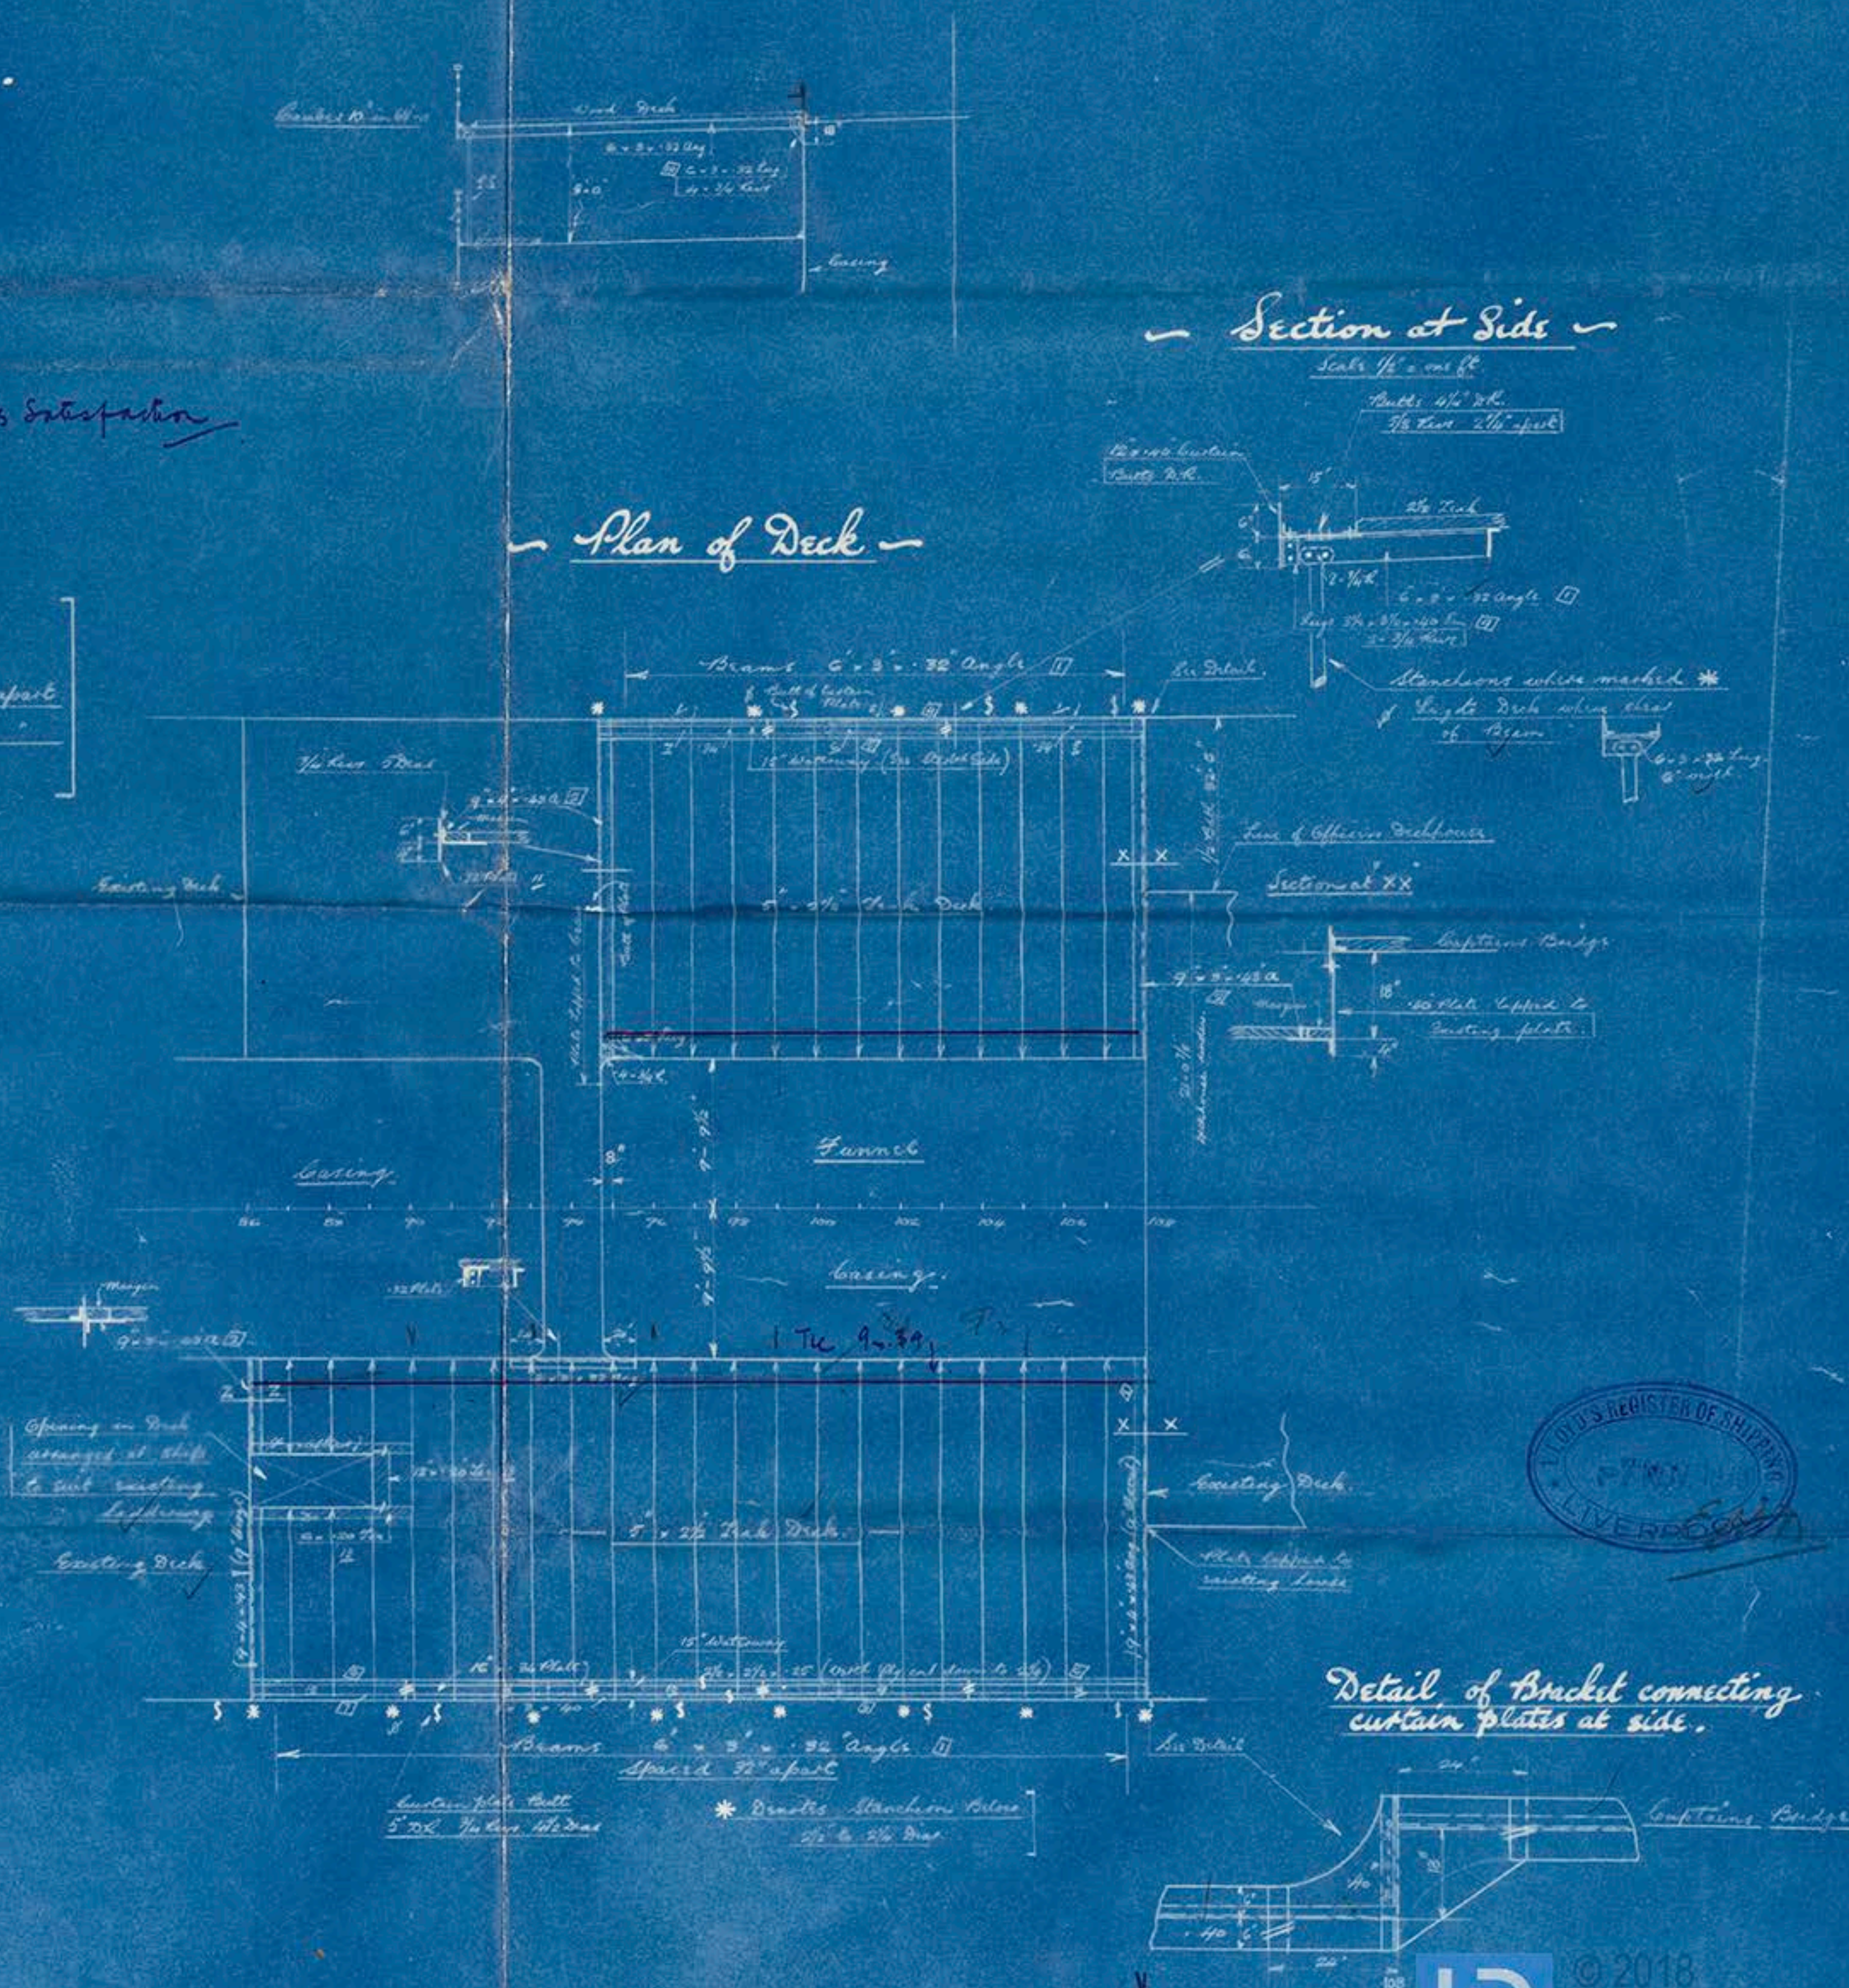

Detail of Bracket connecting
gunter plates at side.



© 2018
Lloyd's Register
Foundation

S. S. *Arandora Star*

LIVERPOOL,

Report No. *103120.*

*Games & Officer's
Deck*



© 2018

Lloyd's Register
Foundation

LR-FAF-TB31-P-31