
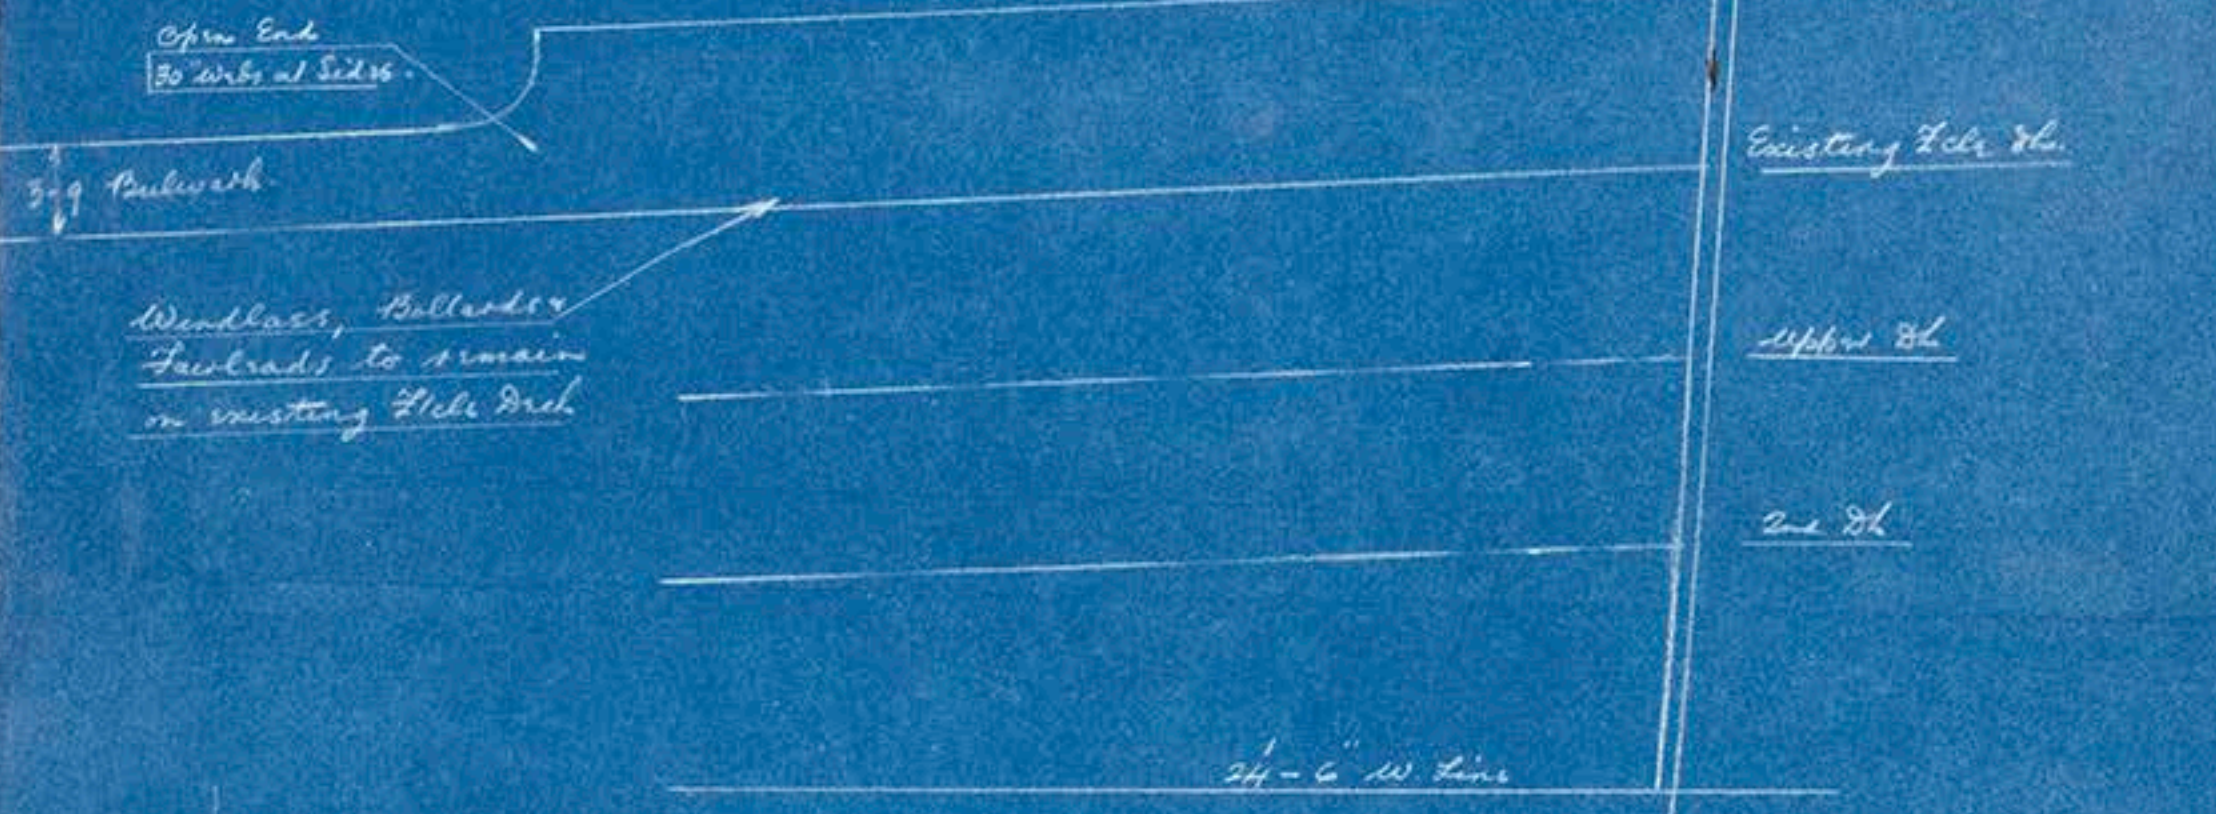
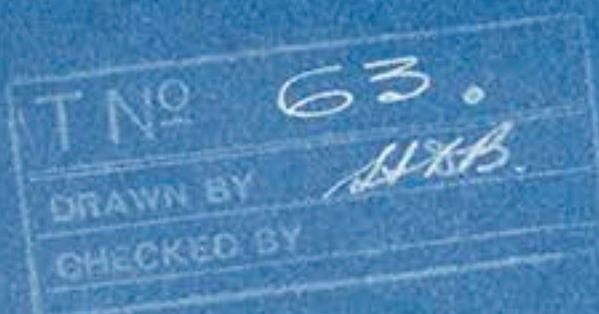


Liv Rpt 103/20

T.S.S. "Arandora Star"

Plan showing proposed scantlings
of Upper Forecastle.

Scale $\frac{1}{4}" = \text{one ft.}$

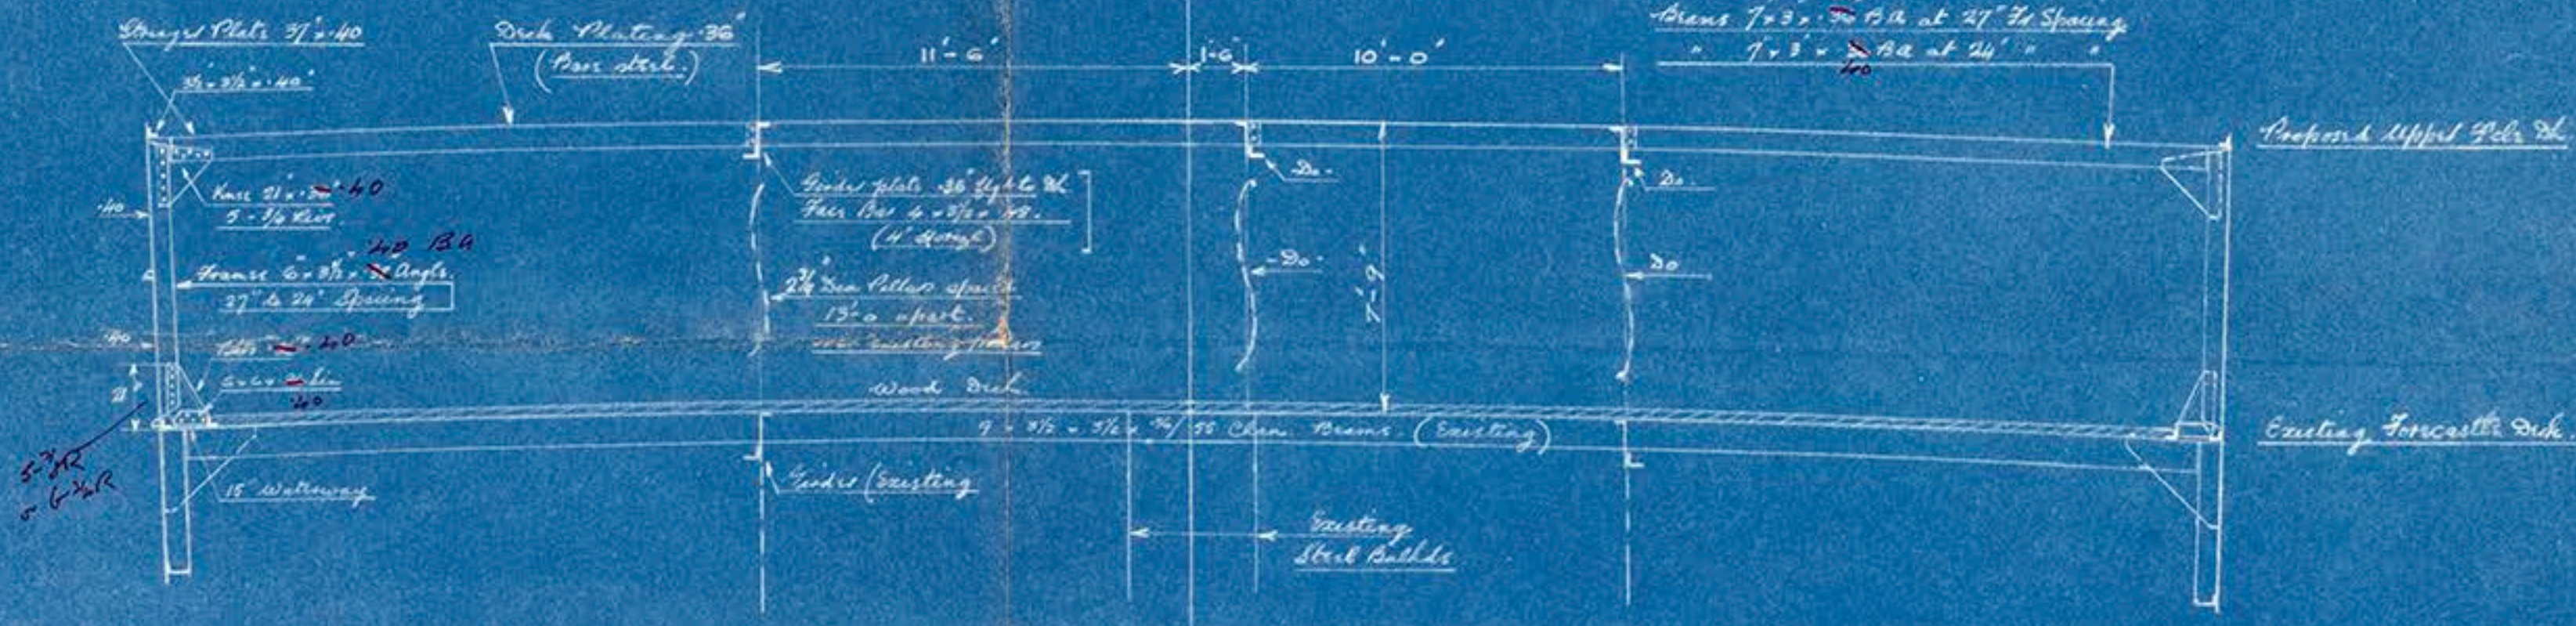

18-11



© 2018
Lloyd's Register
Foundation