
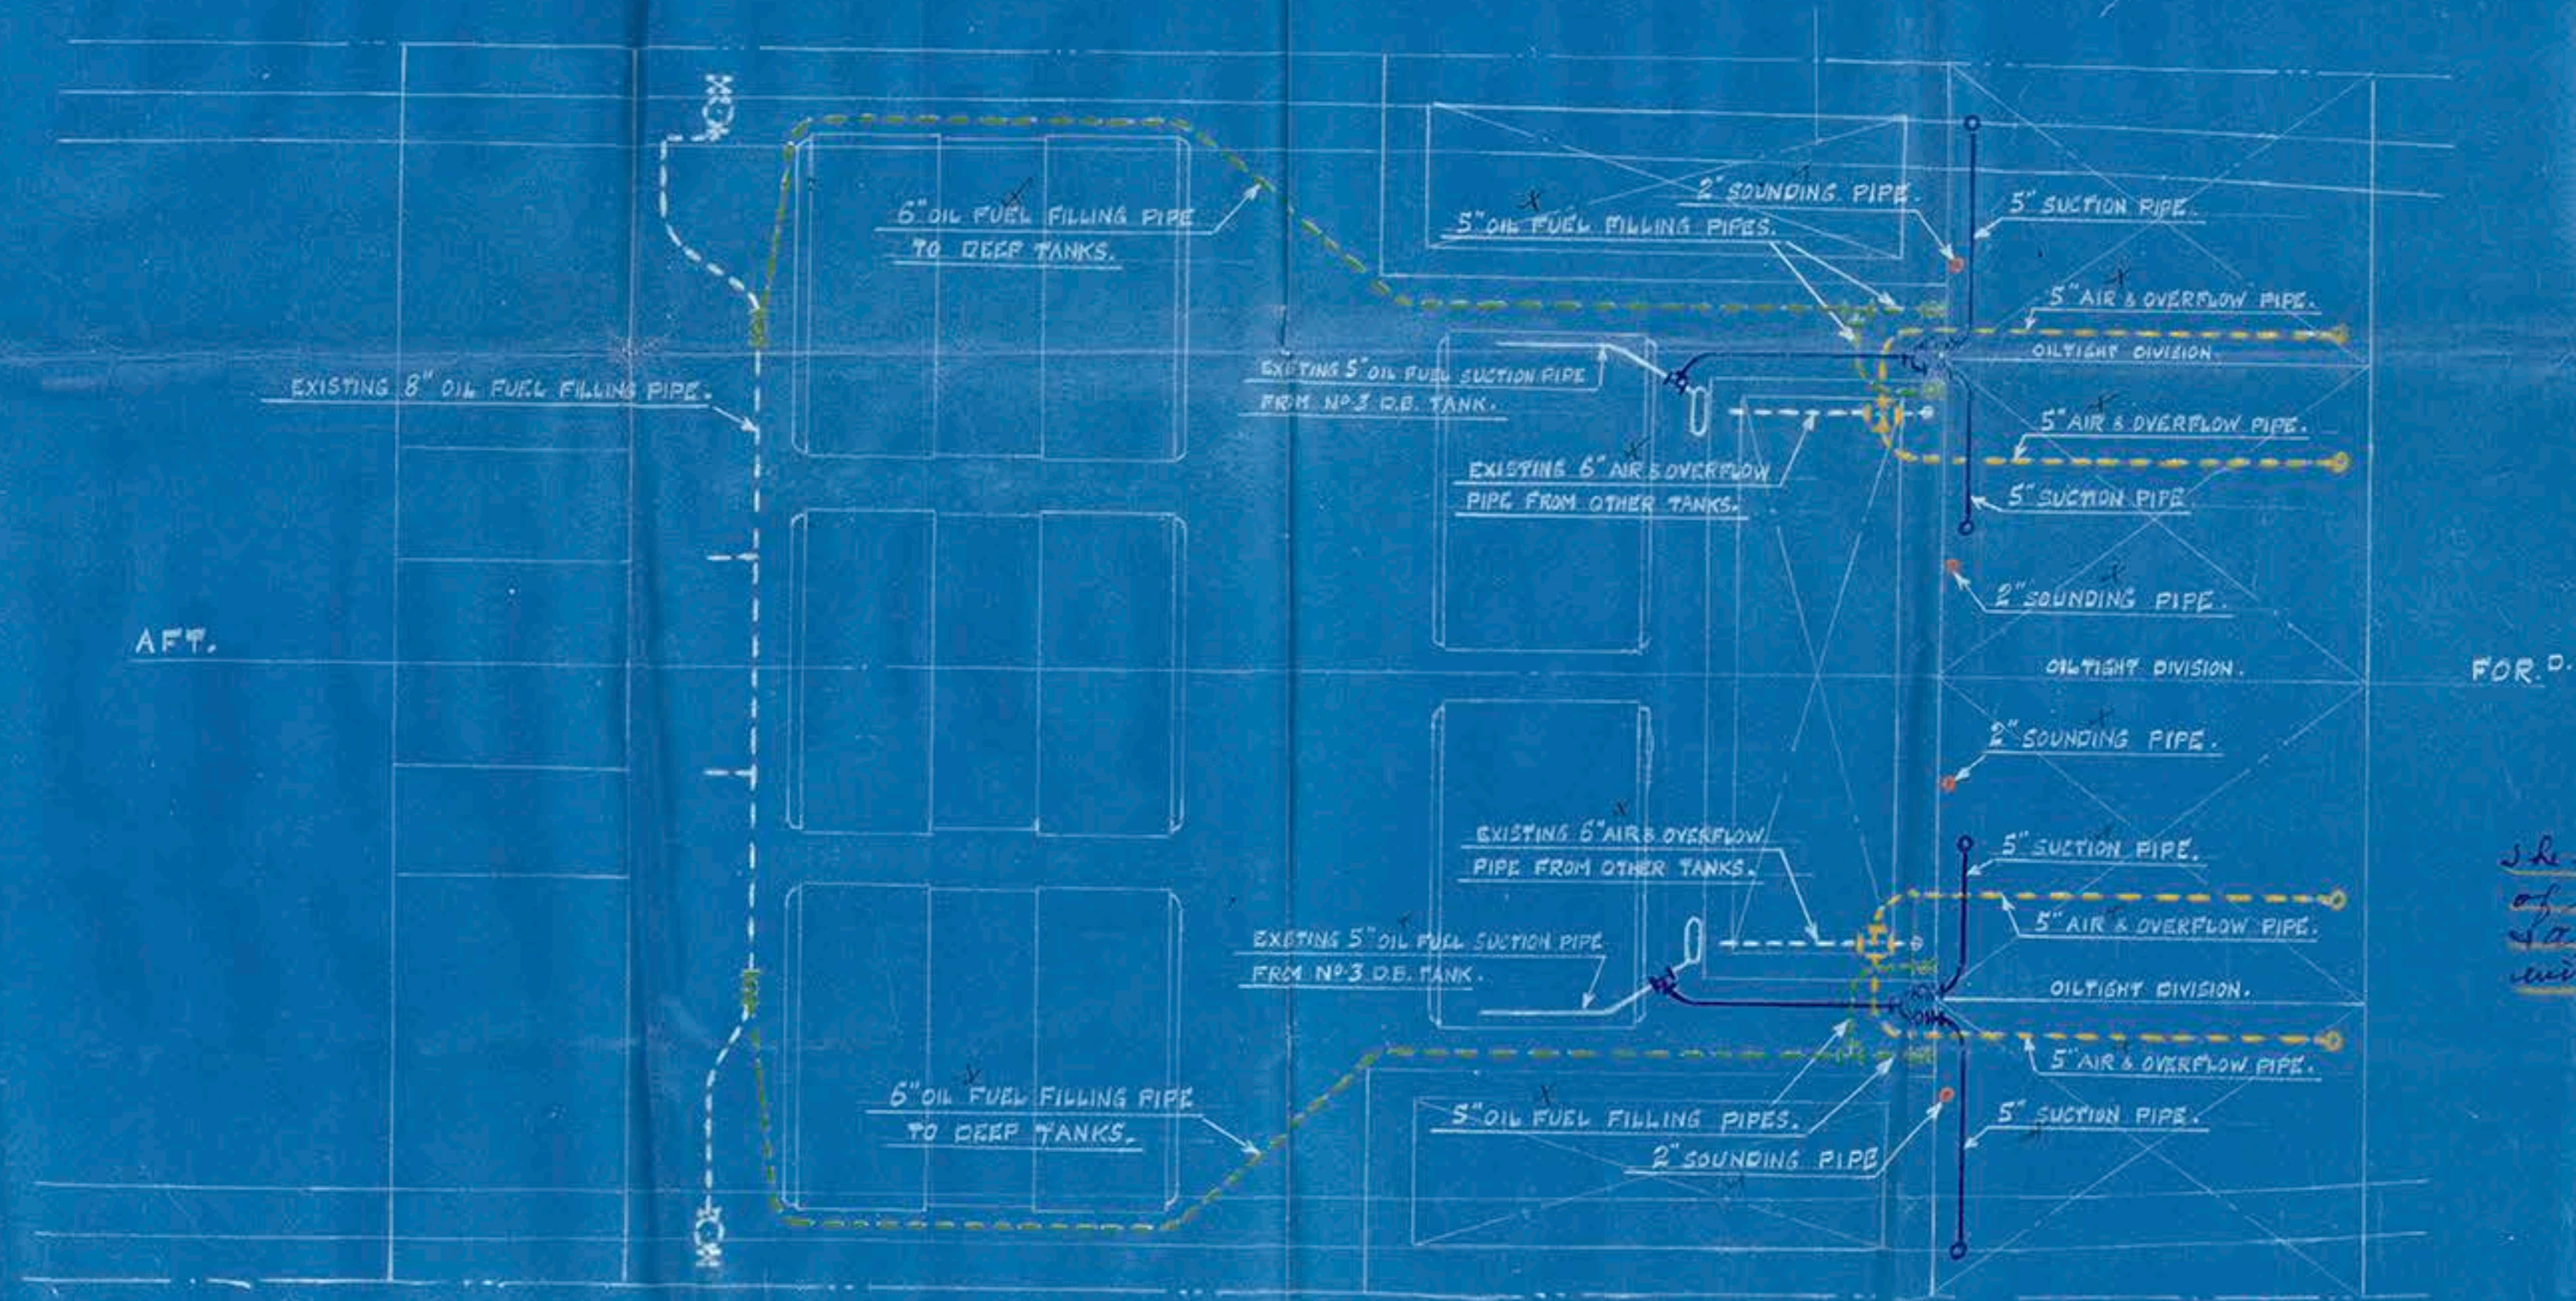


2-11/17/34

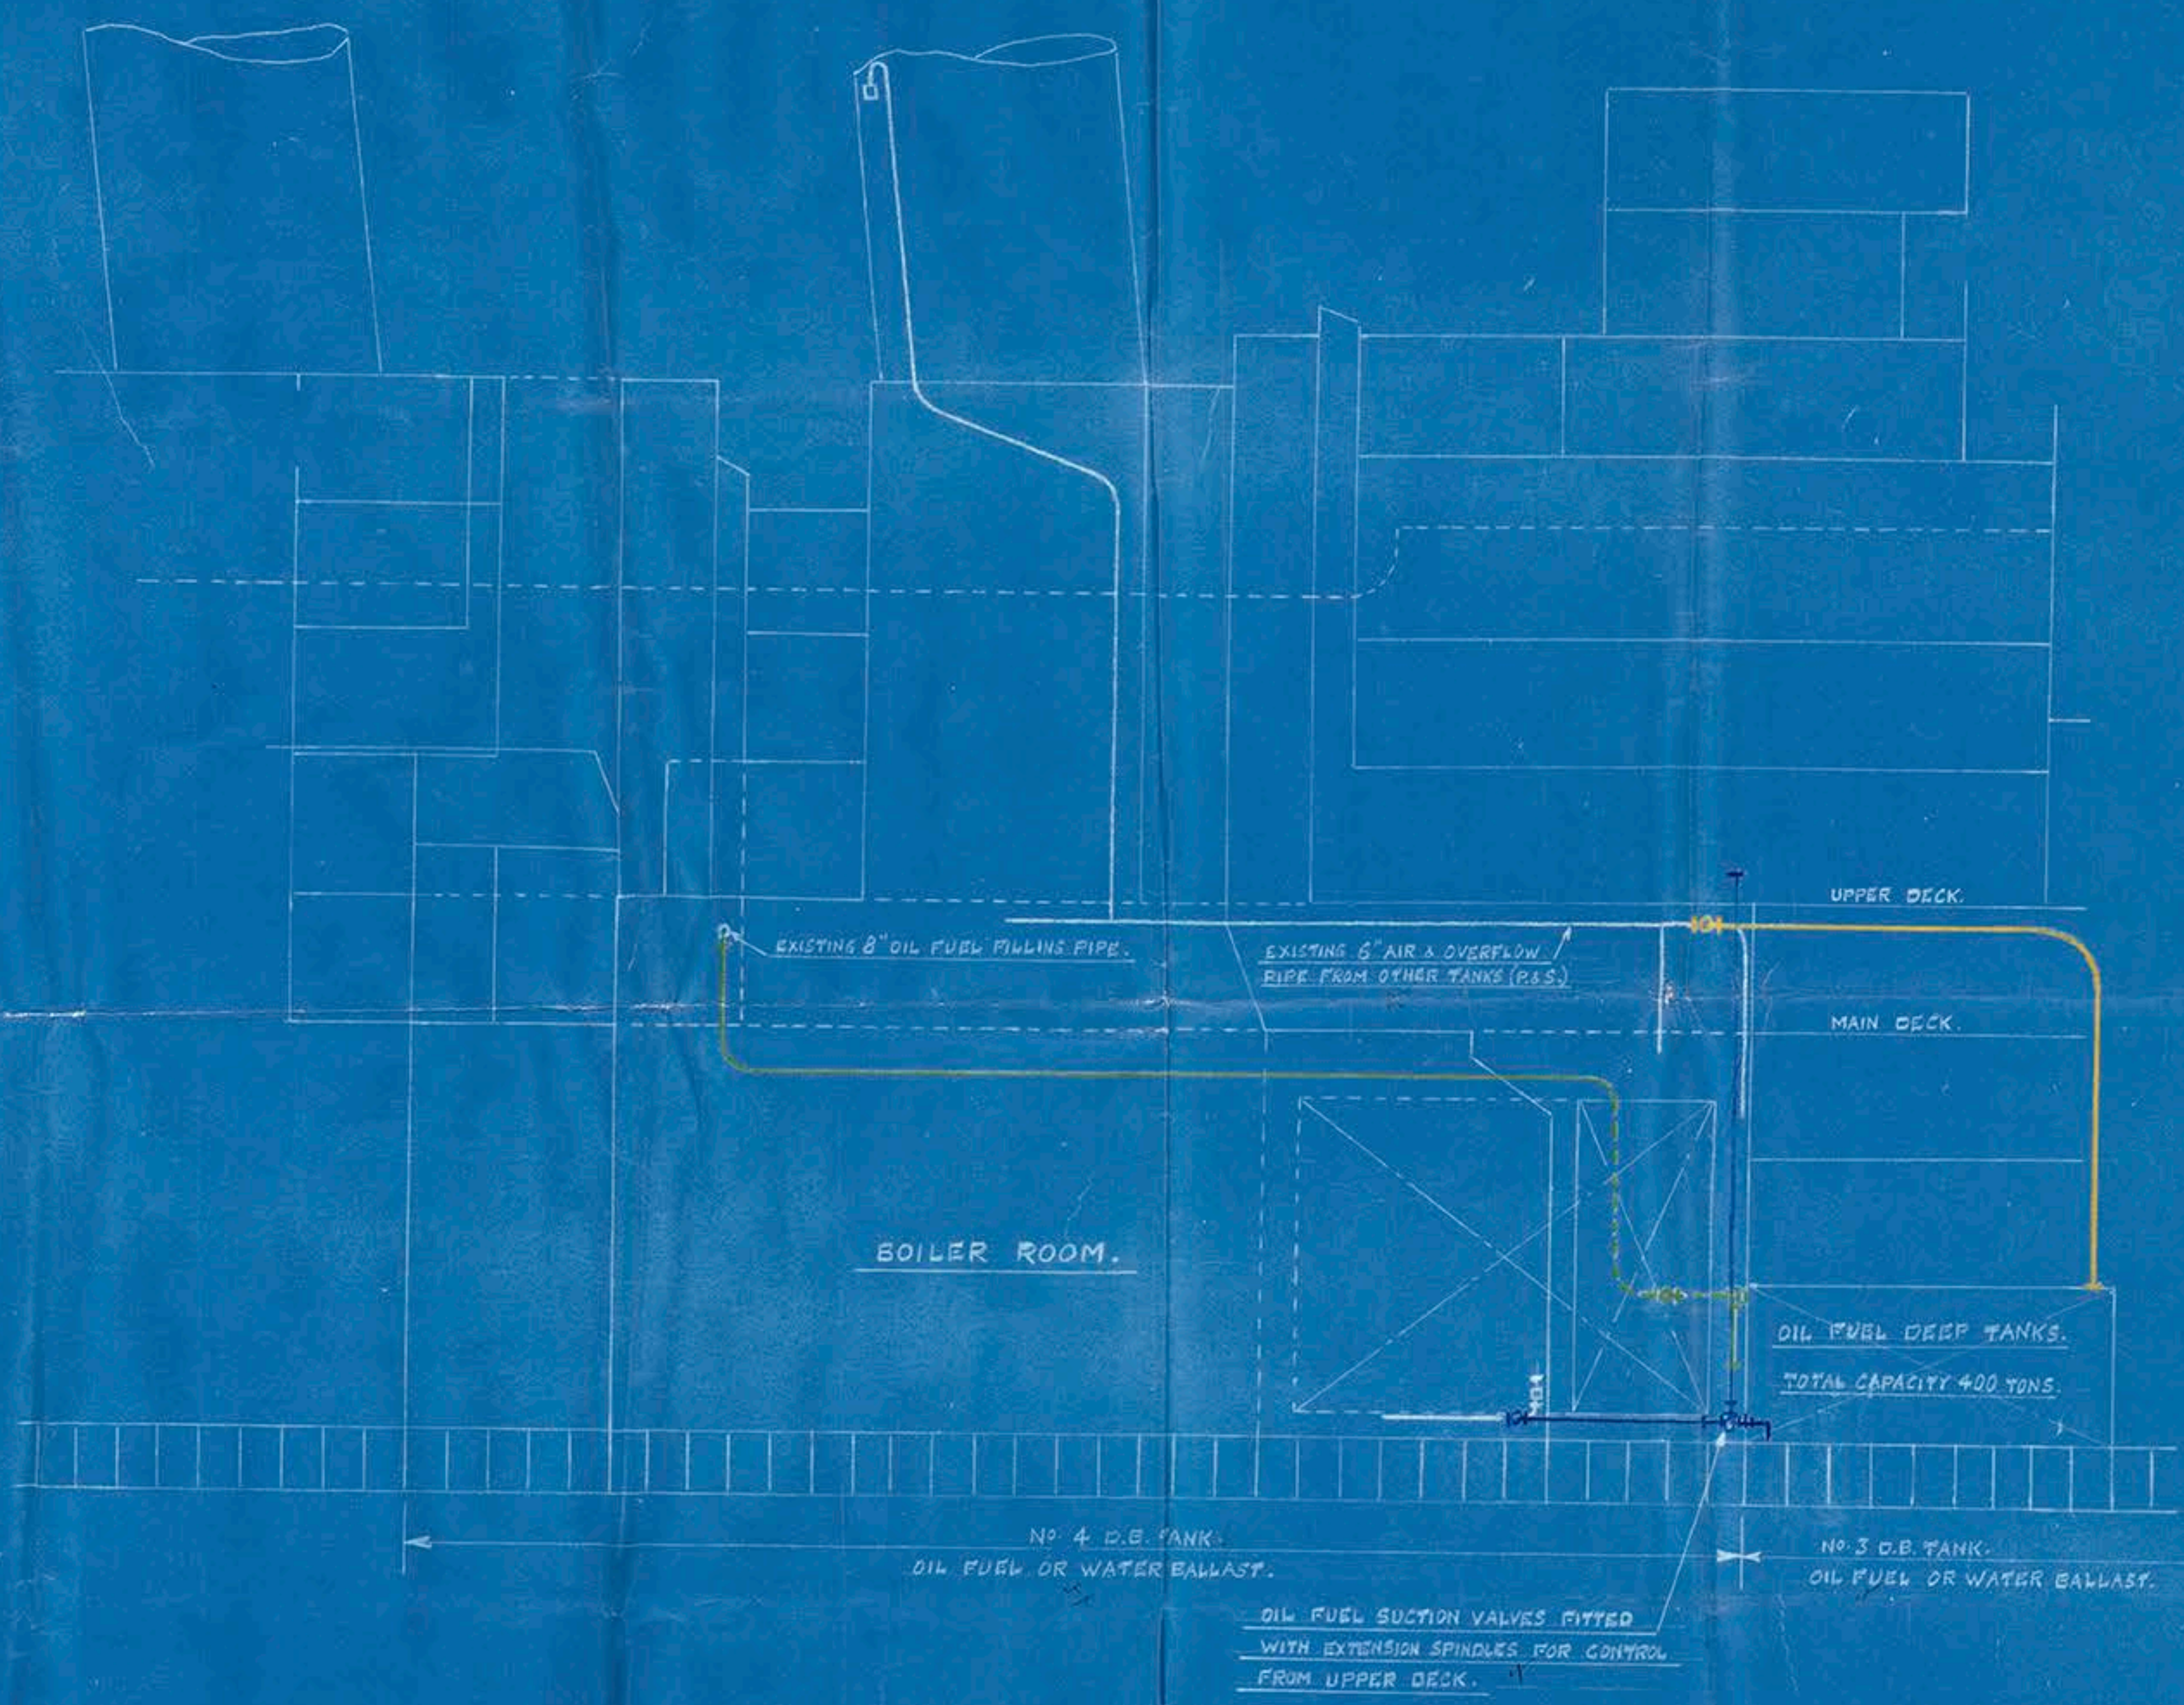

The requirements of Section 3, Sub 4, of the Rules for Refrigerating Machinery, to be complied with.

The requirements of Section 20 B, Sub 4, of the Rules (1934-5), to be complied with.

FOX'S PNEUMERCATOR GAUGES FITTED TO OIL FUEL DEEP TANKS.
(To be fitted after fitting on board.)

NEW OIL FUEL FILLING PIPES SHOWN THUS ———. NEW OIL FUEL SUCTION PIPES SHOWN THUS ———.
PIPES TO BE OF WROUGHT IRON, & TESTED TO 60 LBS/SQ. IN.; FLANGES TO BE SUITABLE FOR A WORKING PRESSURE OF 100 LBS/SQ. IN.; CAST IRON BULKHEAD PIECES.

NEW AIR & OVERFLOW PIPES SHOWN THUS ———.

Amended plan approved 4/11/35.
Amendments:
Sounding pipes as shown with steam cut connections fitted.

S.S. "ARANDORA STAR"

ARRANGEMENT OF OIL FUEL FILLING & SUCTION PIPES
& AIR & OVERFLOW PIPES FOR NEW DEEP TANKS.

SCALE: 1/8" = 1 FT.

The bulkhead of the oil fuel tank to be about 3/16" and the remaining requirements of Section 40 of the Rules (1934-5) to be complied with as far as they are applicable.

2-11/17/34

1884


DRG. NO. 9680 E.

10013
17/11/34

"ARANDORA STAR"

PUMPING PLAN

AMENDED.

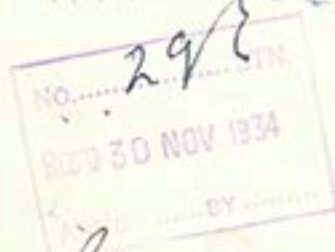

Don. rept. No. 15653.

LONDON COPY.

Amended plan approved
4/11/34

Amendments not shown on
this plan:—

Sounding pipes disapproved
with

steaming out connections
fitted



© 2018

Lloyd's Register
Foundation