


PLATE TO BE
LEFT SQUARE AND
SWEEP TO BE LINED
OFF AND APPROVED
BEFORE CUTTING

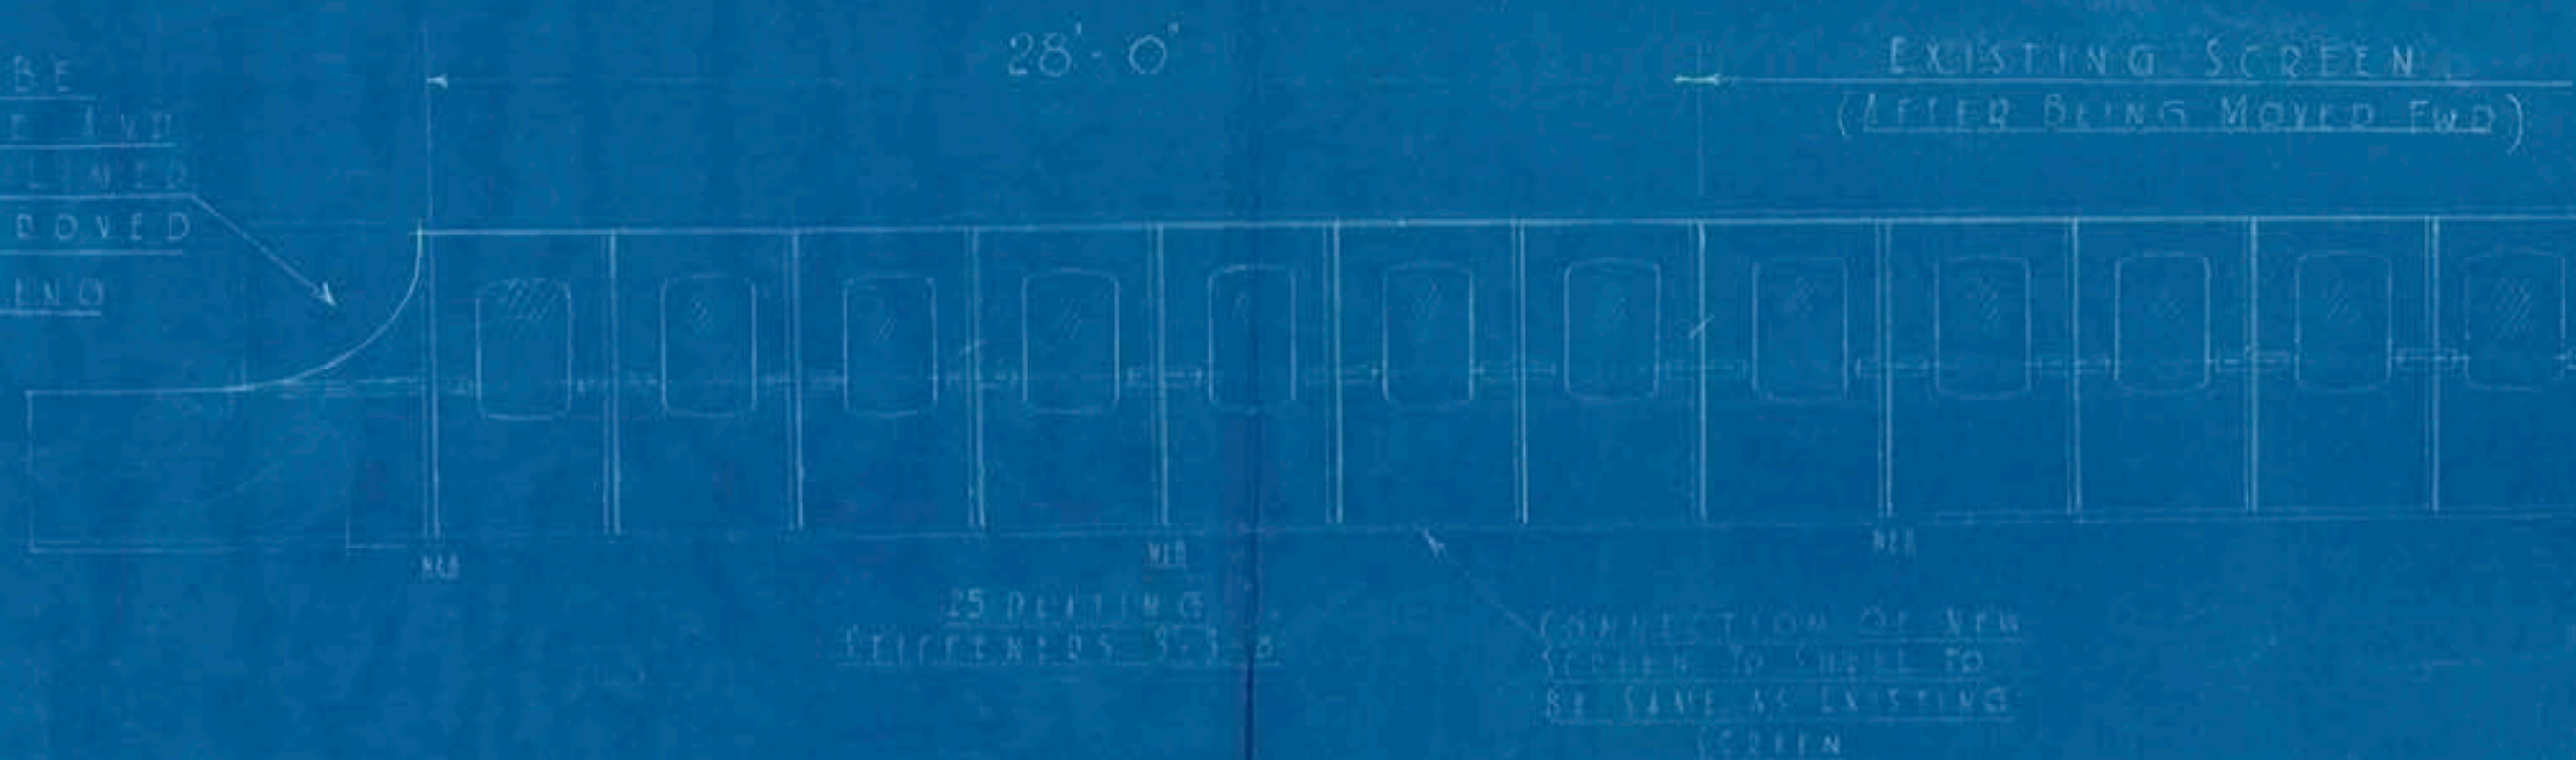


JOB NO 38/102
SIDE SCREENS ON
"E" DECK SCALE 1/4" = 1 FOOT

SECTION THRU SCREEN



SCANTLING &
CONSTRUCTION
OF NEW SIDE SCREENS
TO BE GENERALLY
SIMILAR TO EXISTING
SCREENS

KEY PLAN

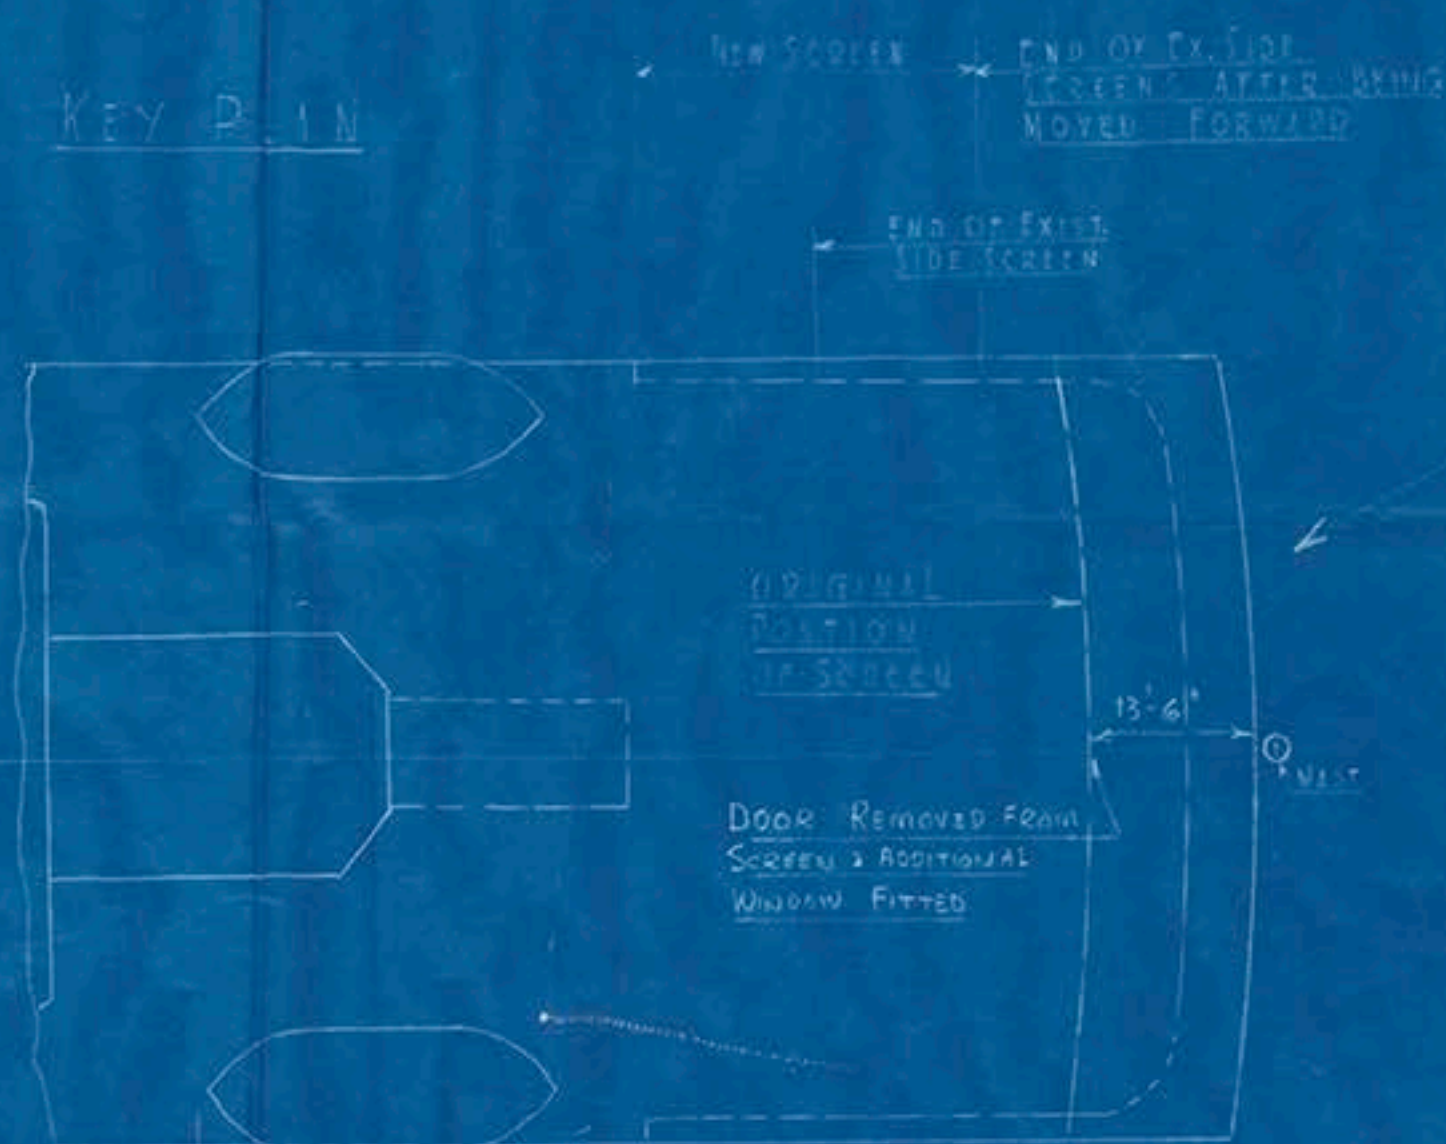

FRONT SCREEN & SIDES
TO BE MOVED BODILY
FORWARD CLOSE UP TO
MAST AND NEW SIDE
SCREENS AS SHOWN
ABOVE JOINED TO
EXISTING SIDE SCREENS

PALMERS HEBBURN CO. LTD.
DRAWING OFFICE
HEBBURN-ON-TYNE



© 2018
Lloyd's Register
Foundation

Job No 38/102

SIDE SCREENS ON
"E" DECK

"ARANDORA STAR"

NWC : 97008.

LR-FAF-TB31-P-46



© 2018

Lloyd's Register
Foundation