
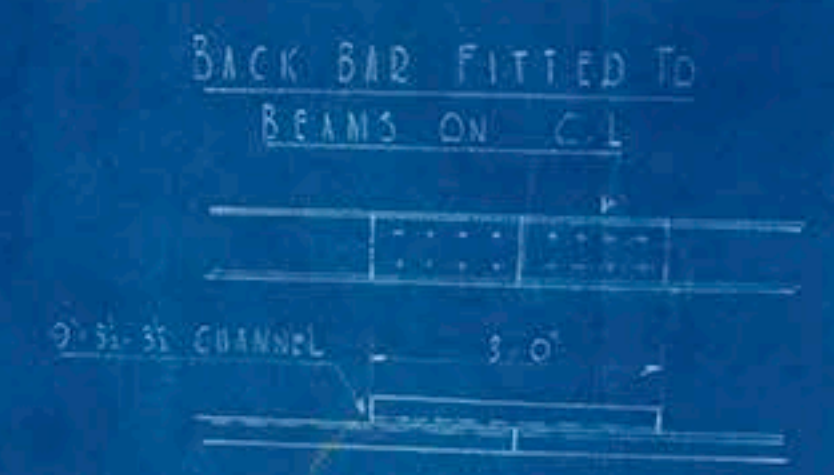
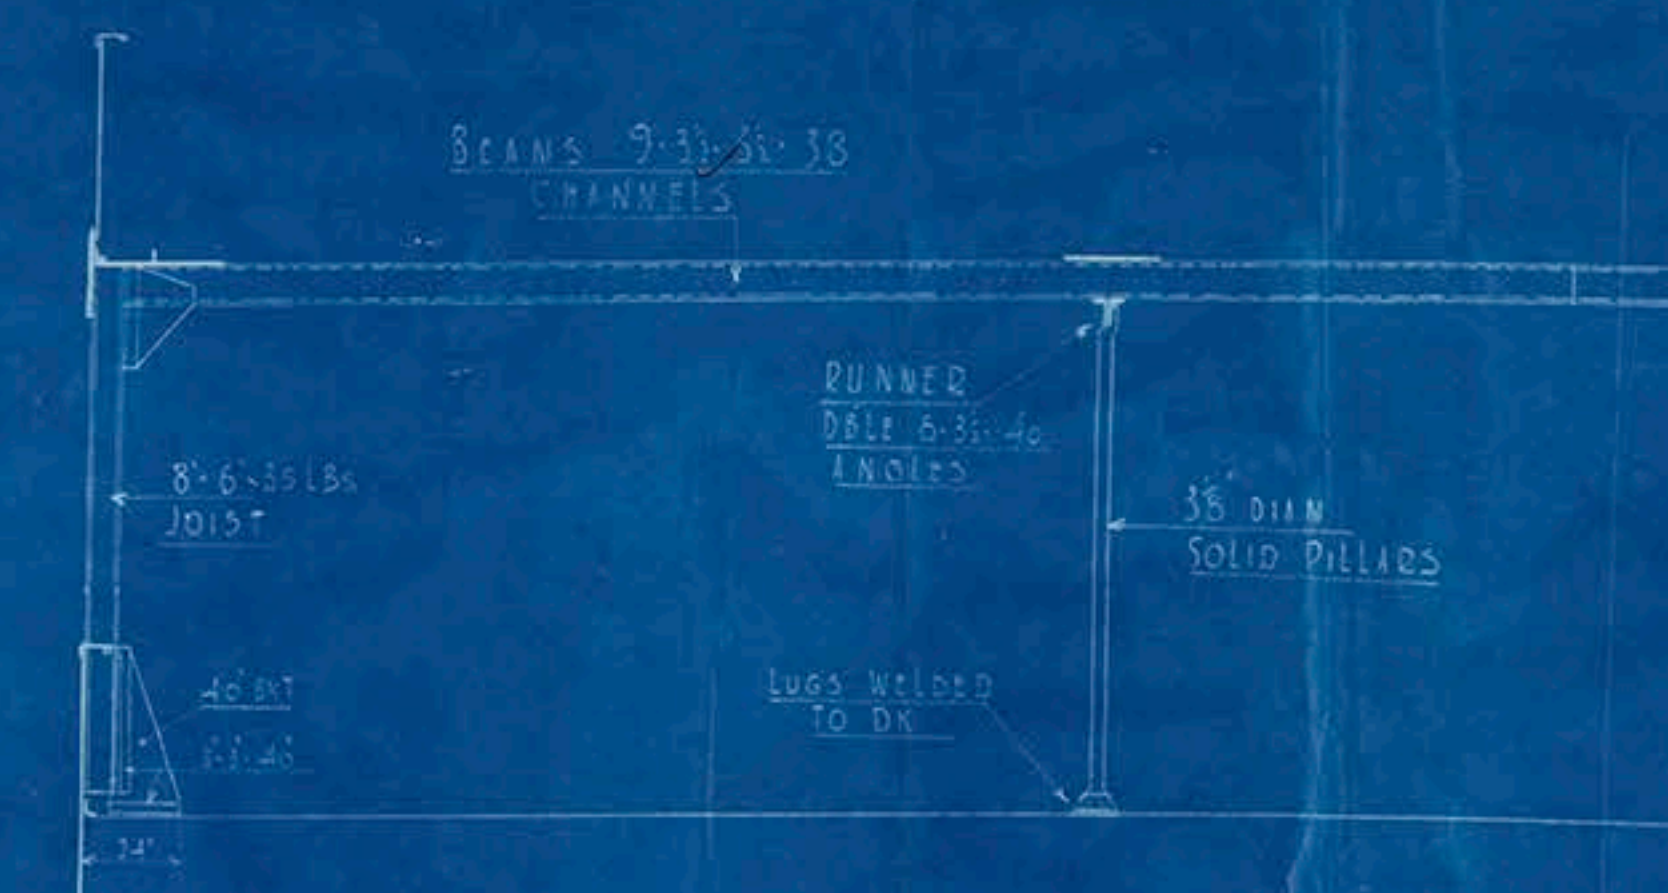
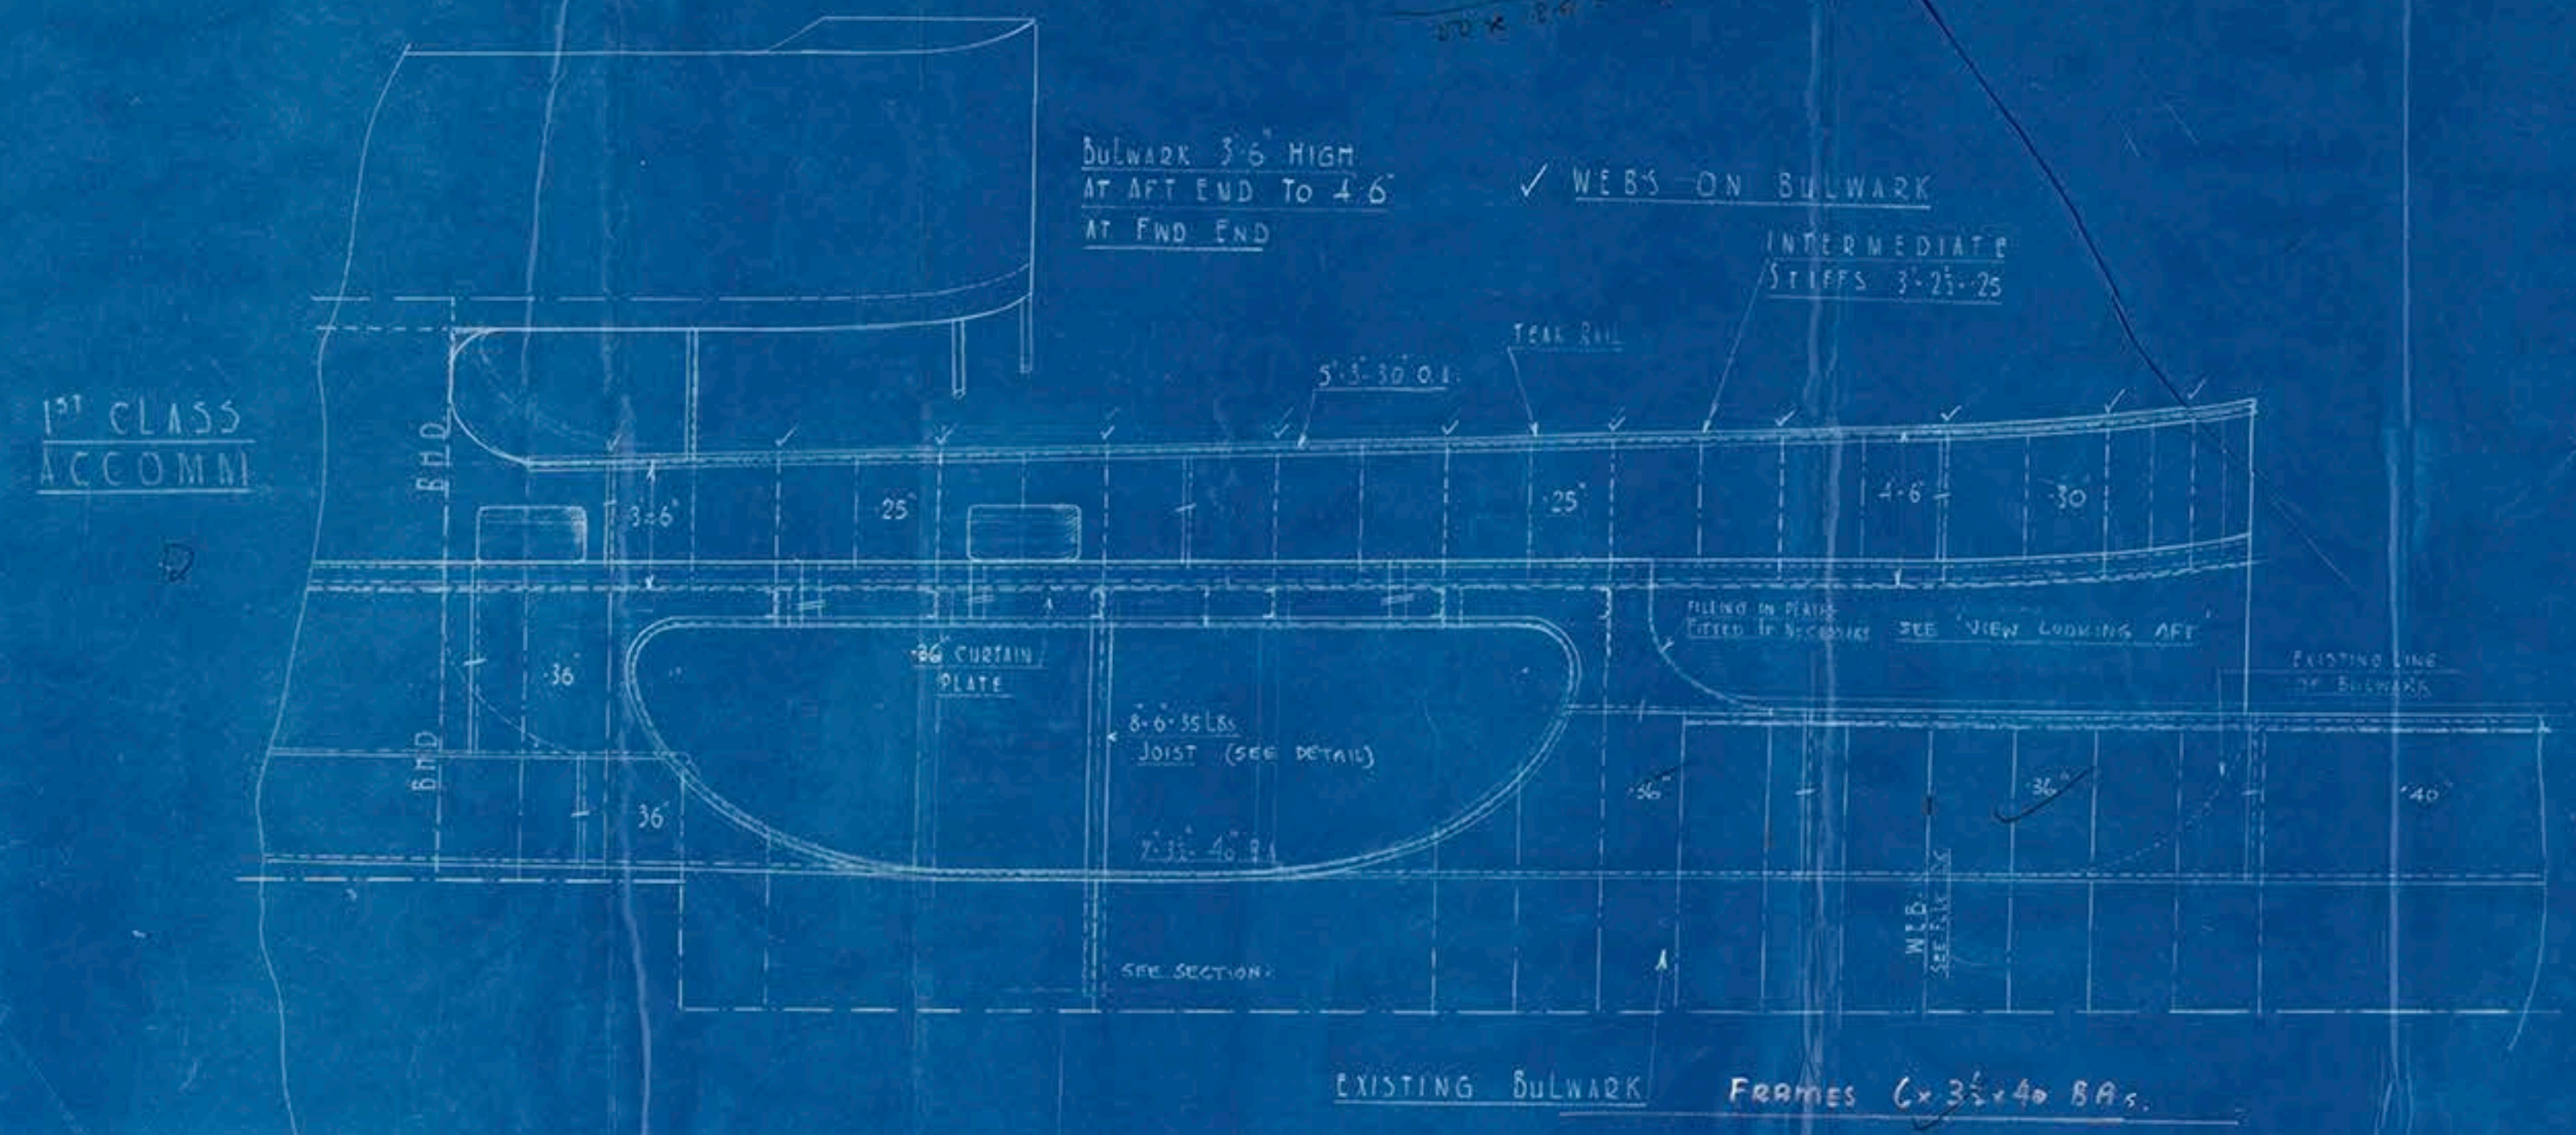
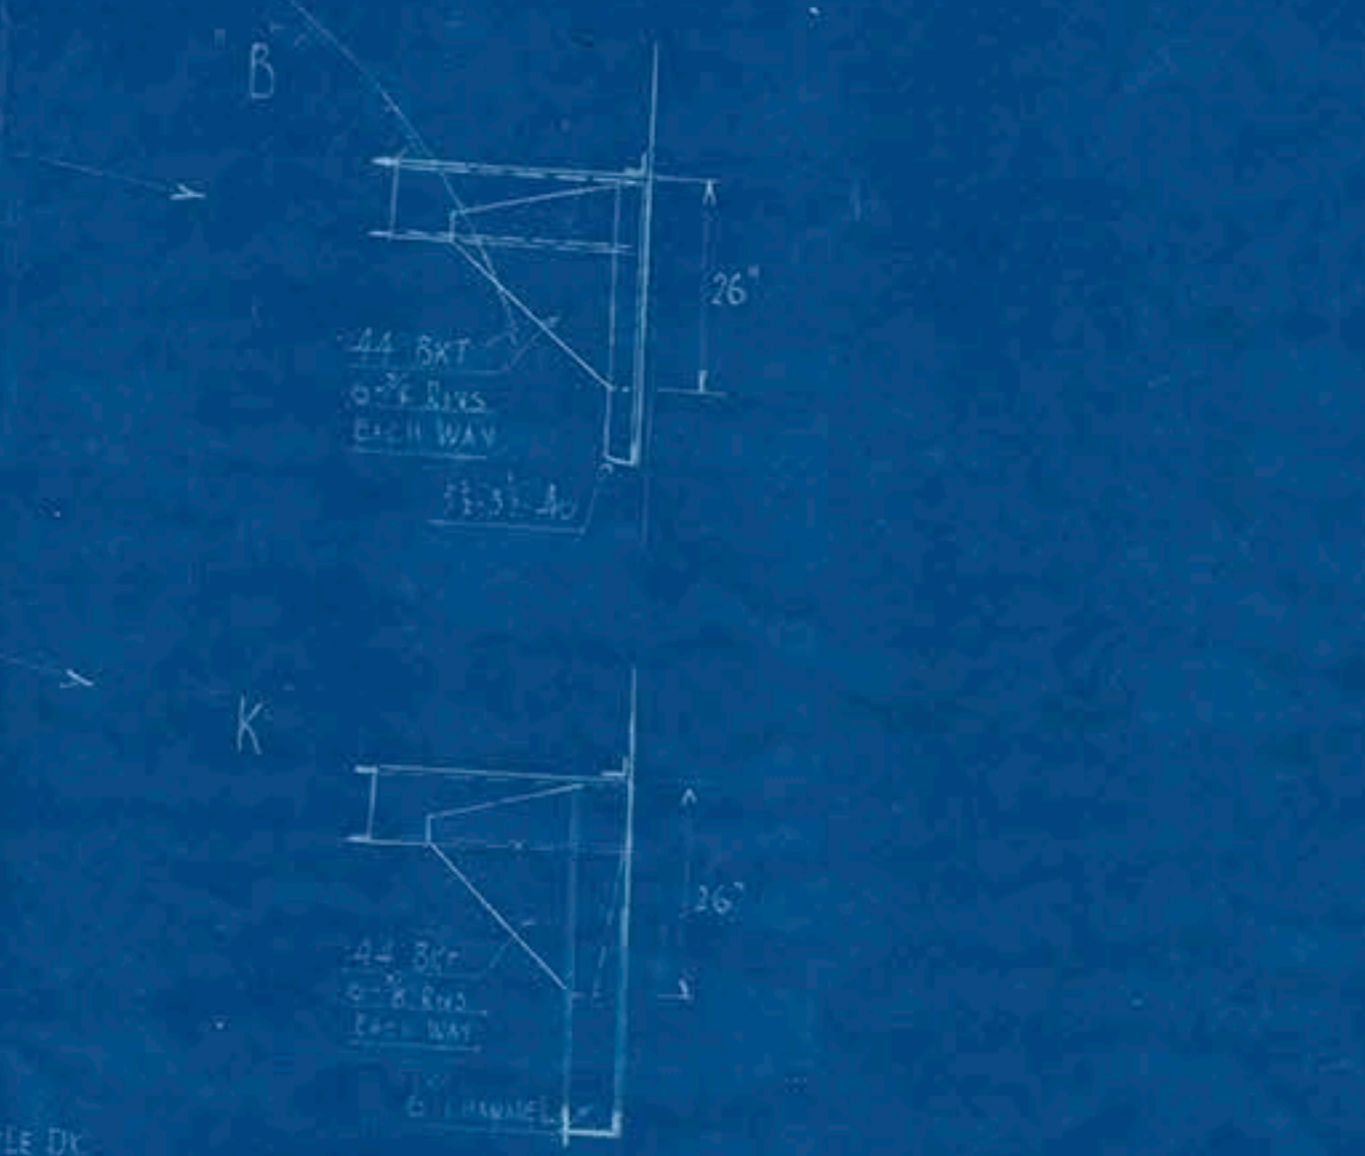
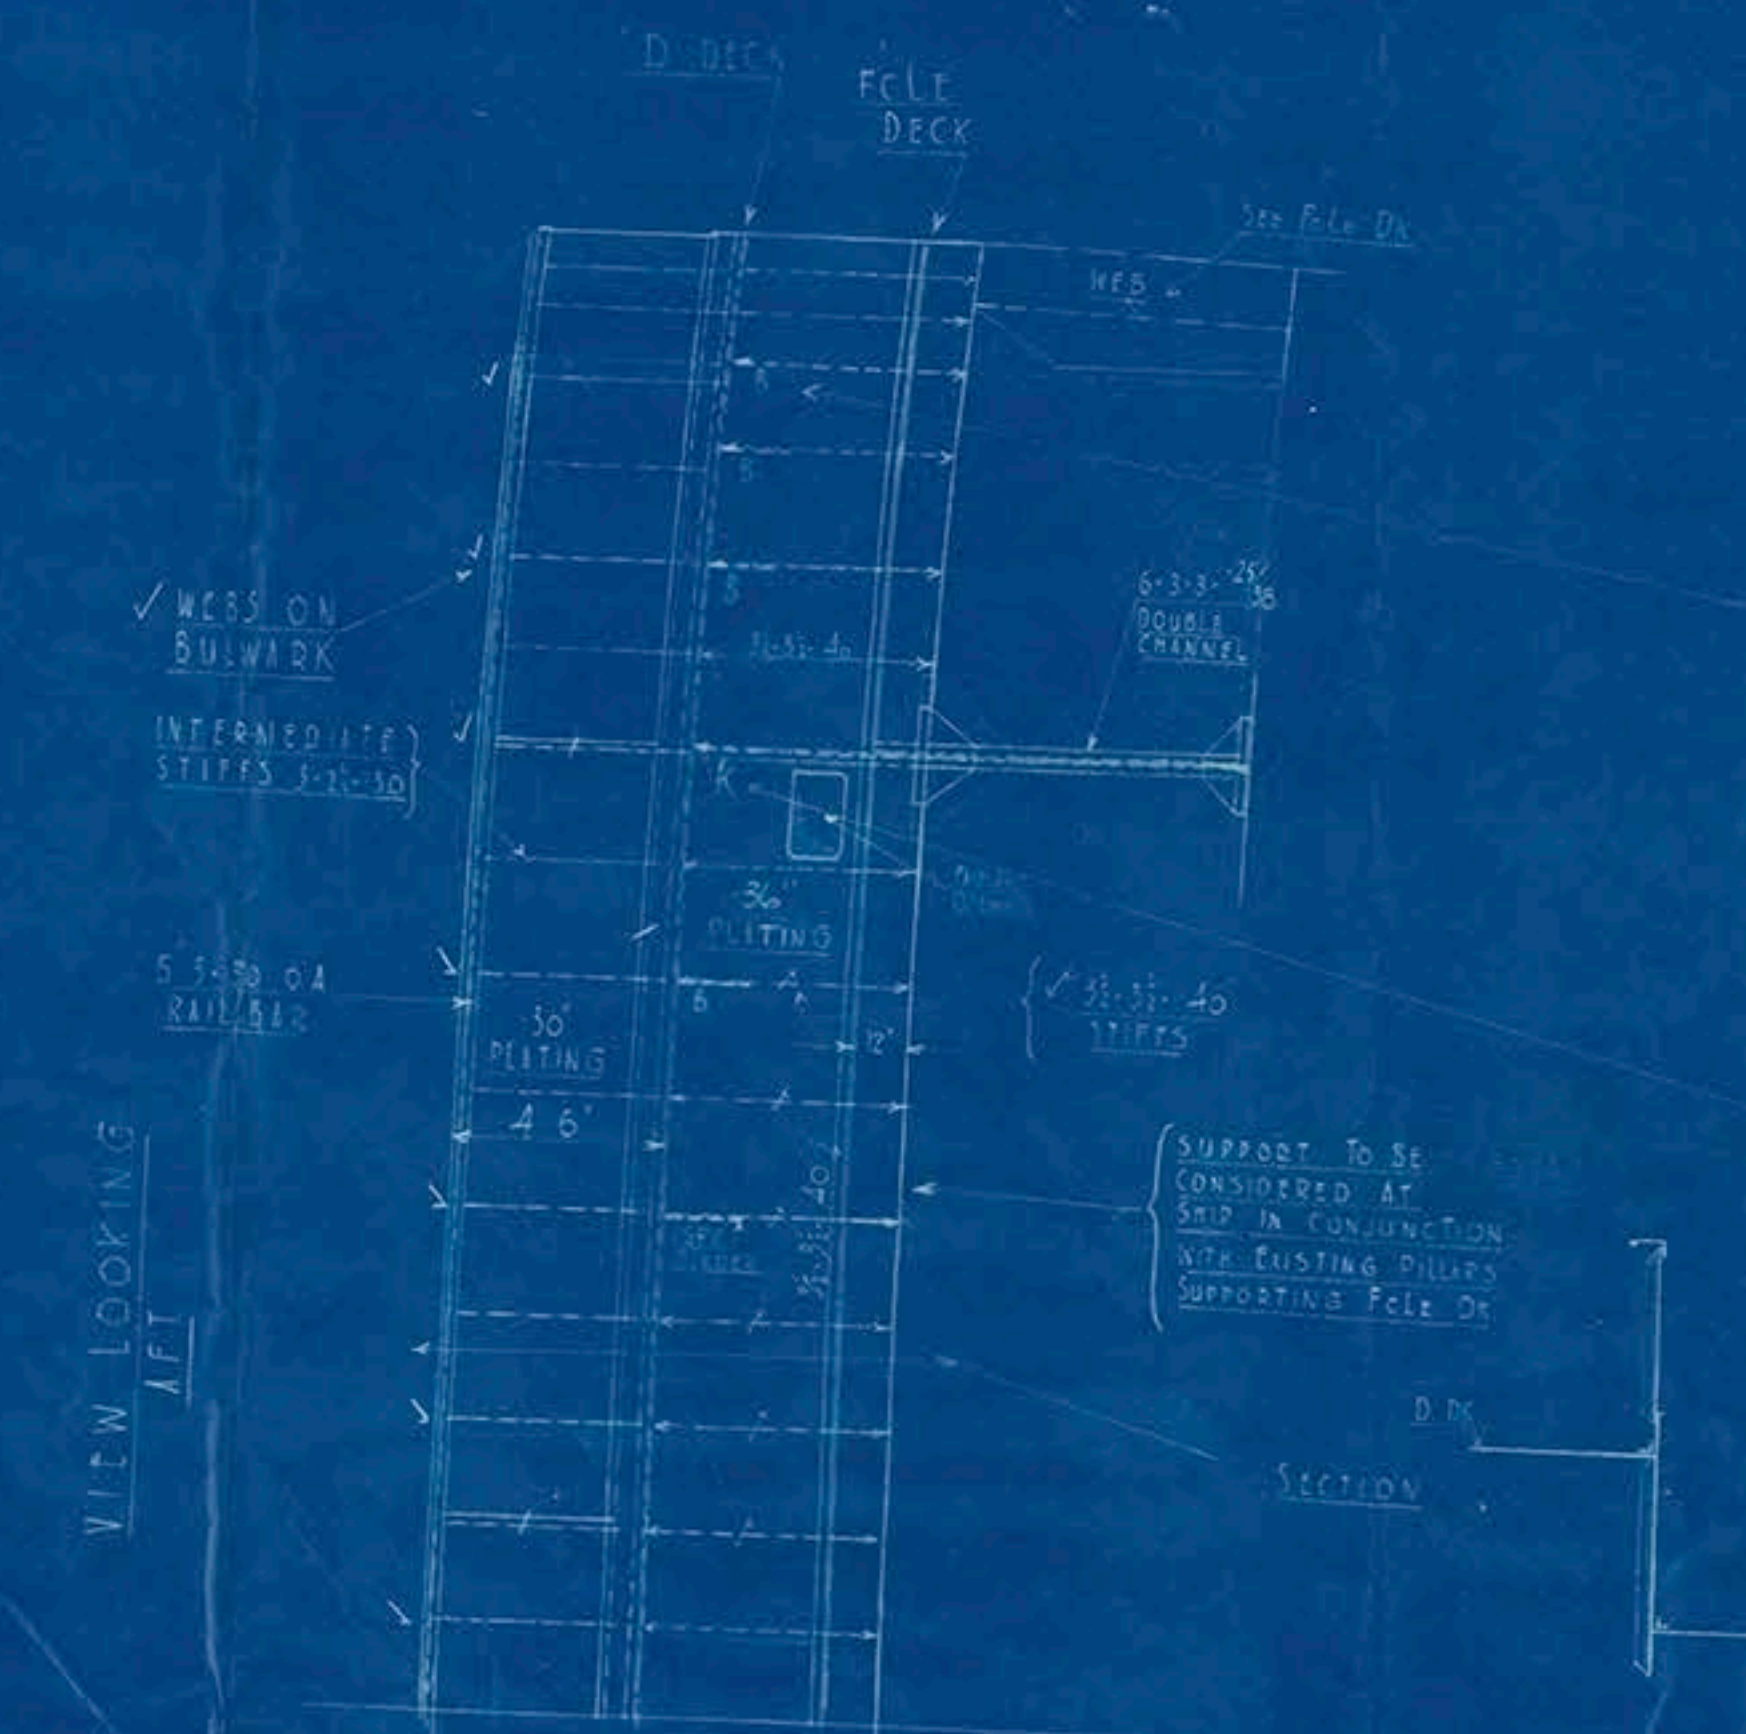
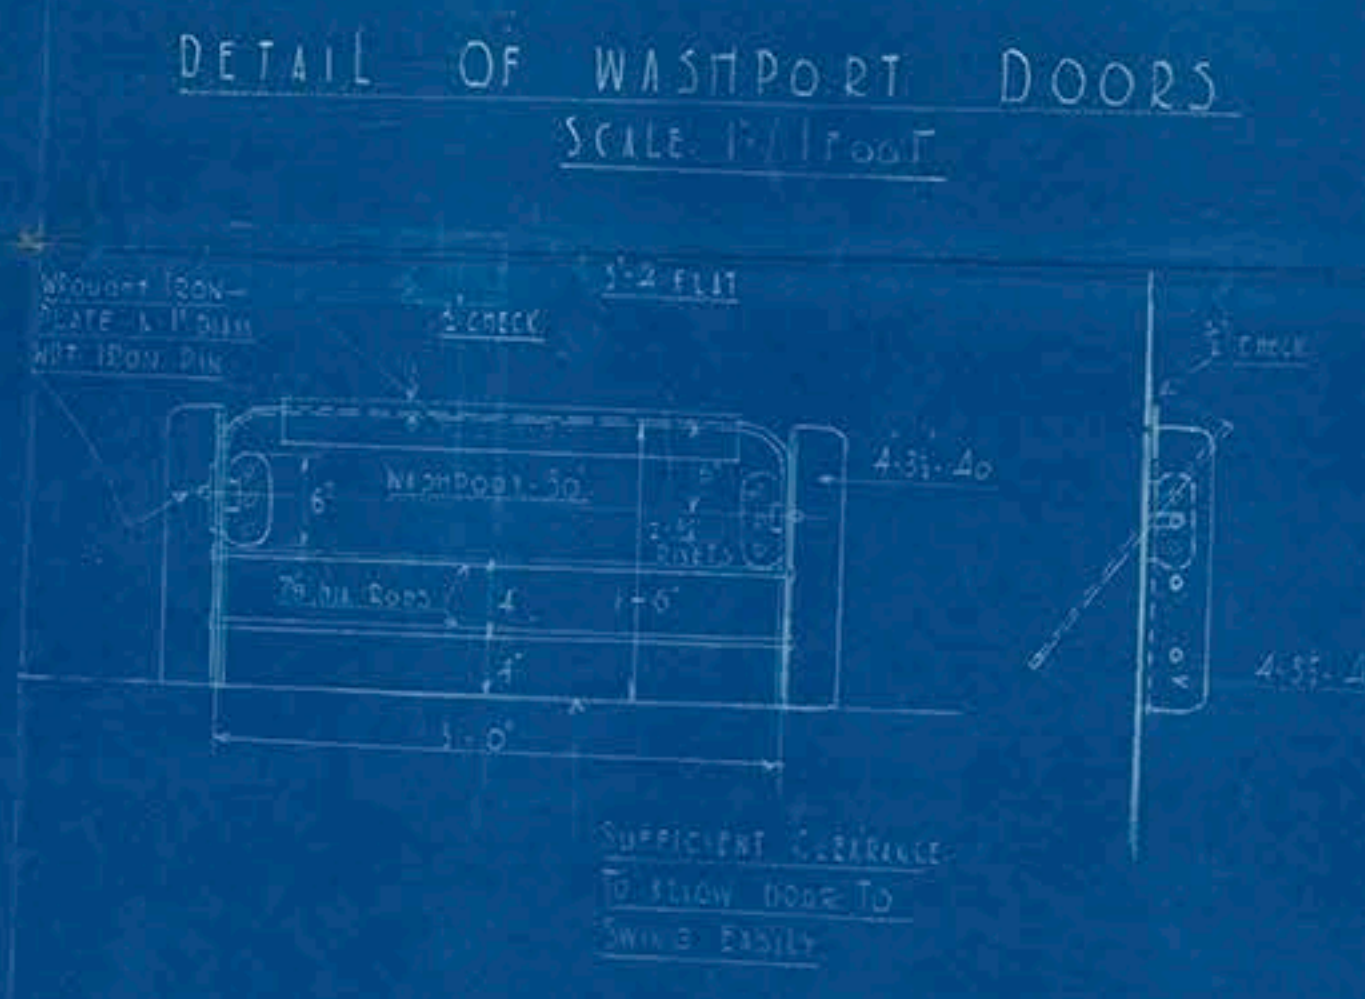
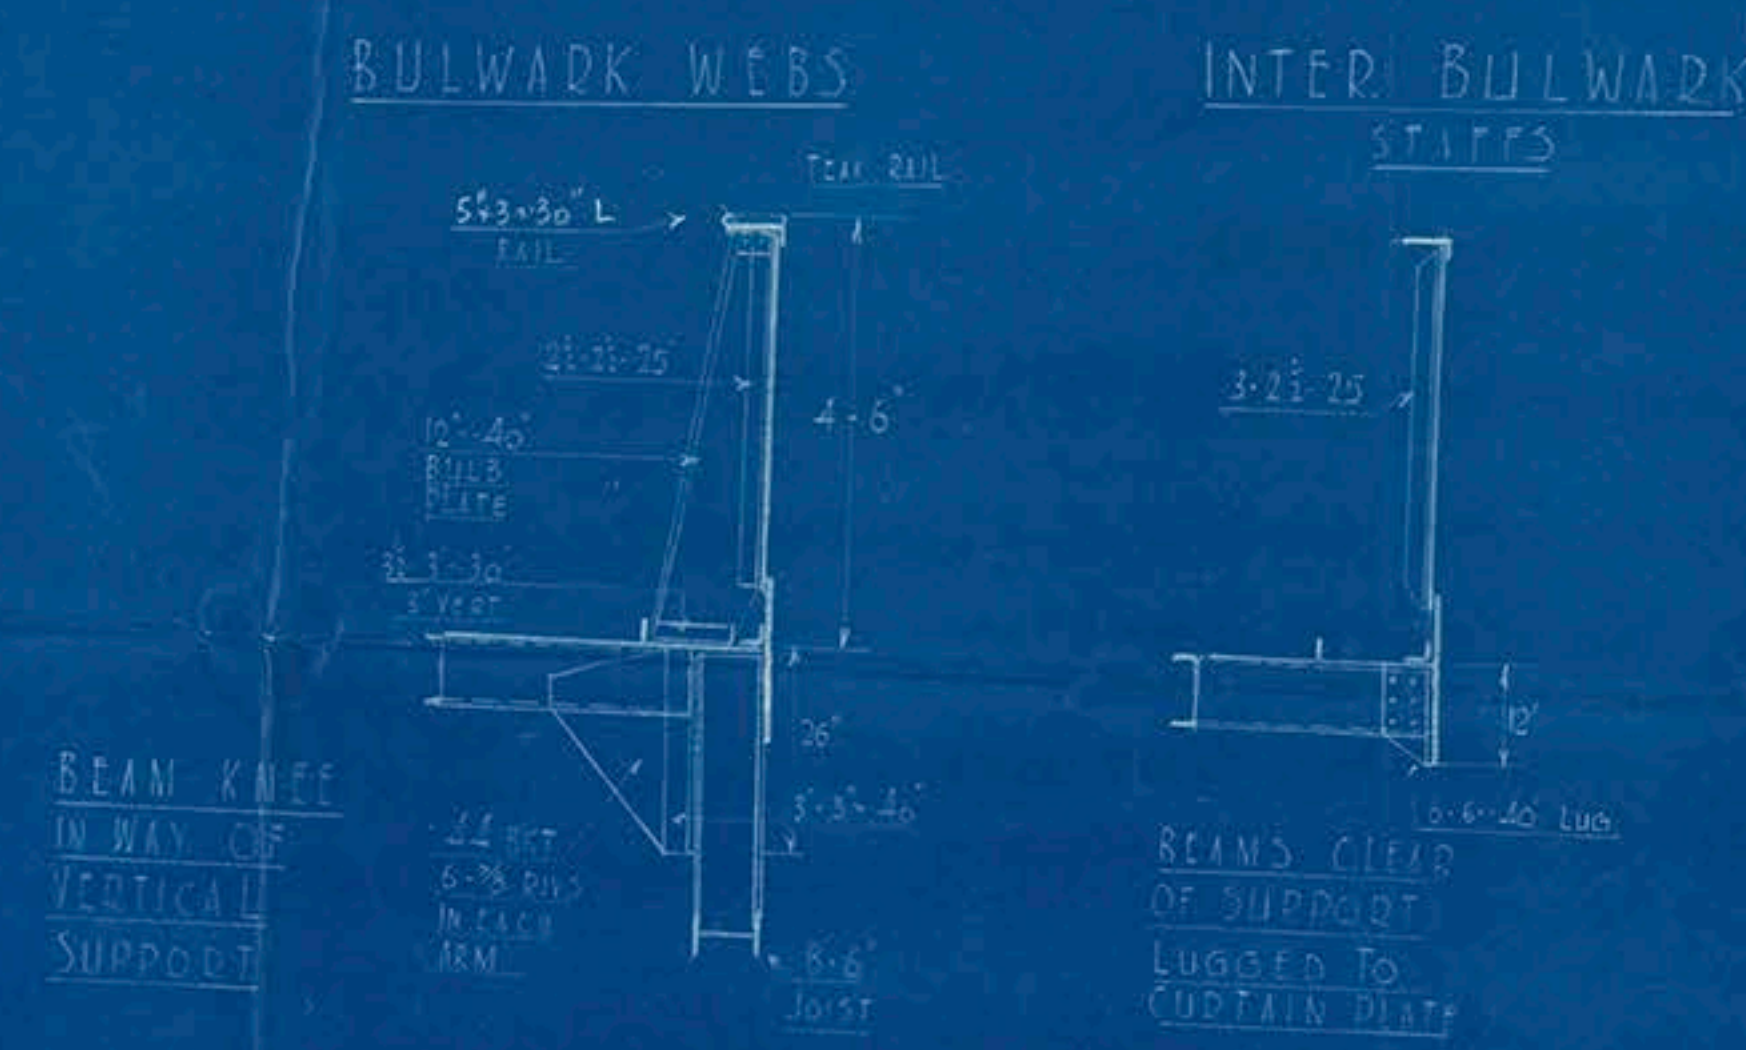


JOB NO 38/102
D DECK EXTENSION
SCALE 4" = 1 FOOT

*See letter
& measurements
re sample*

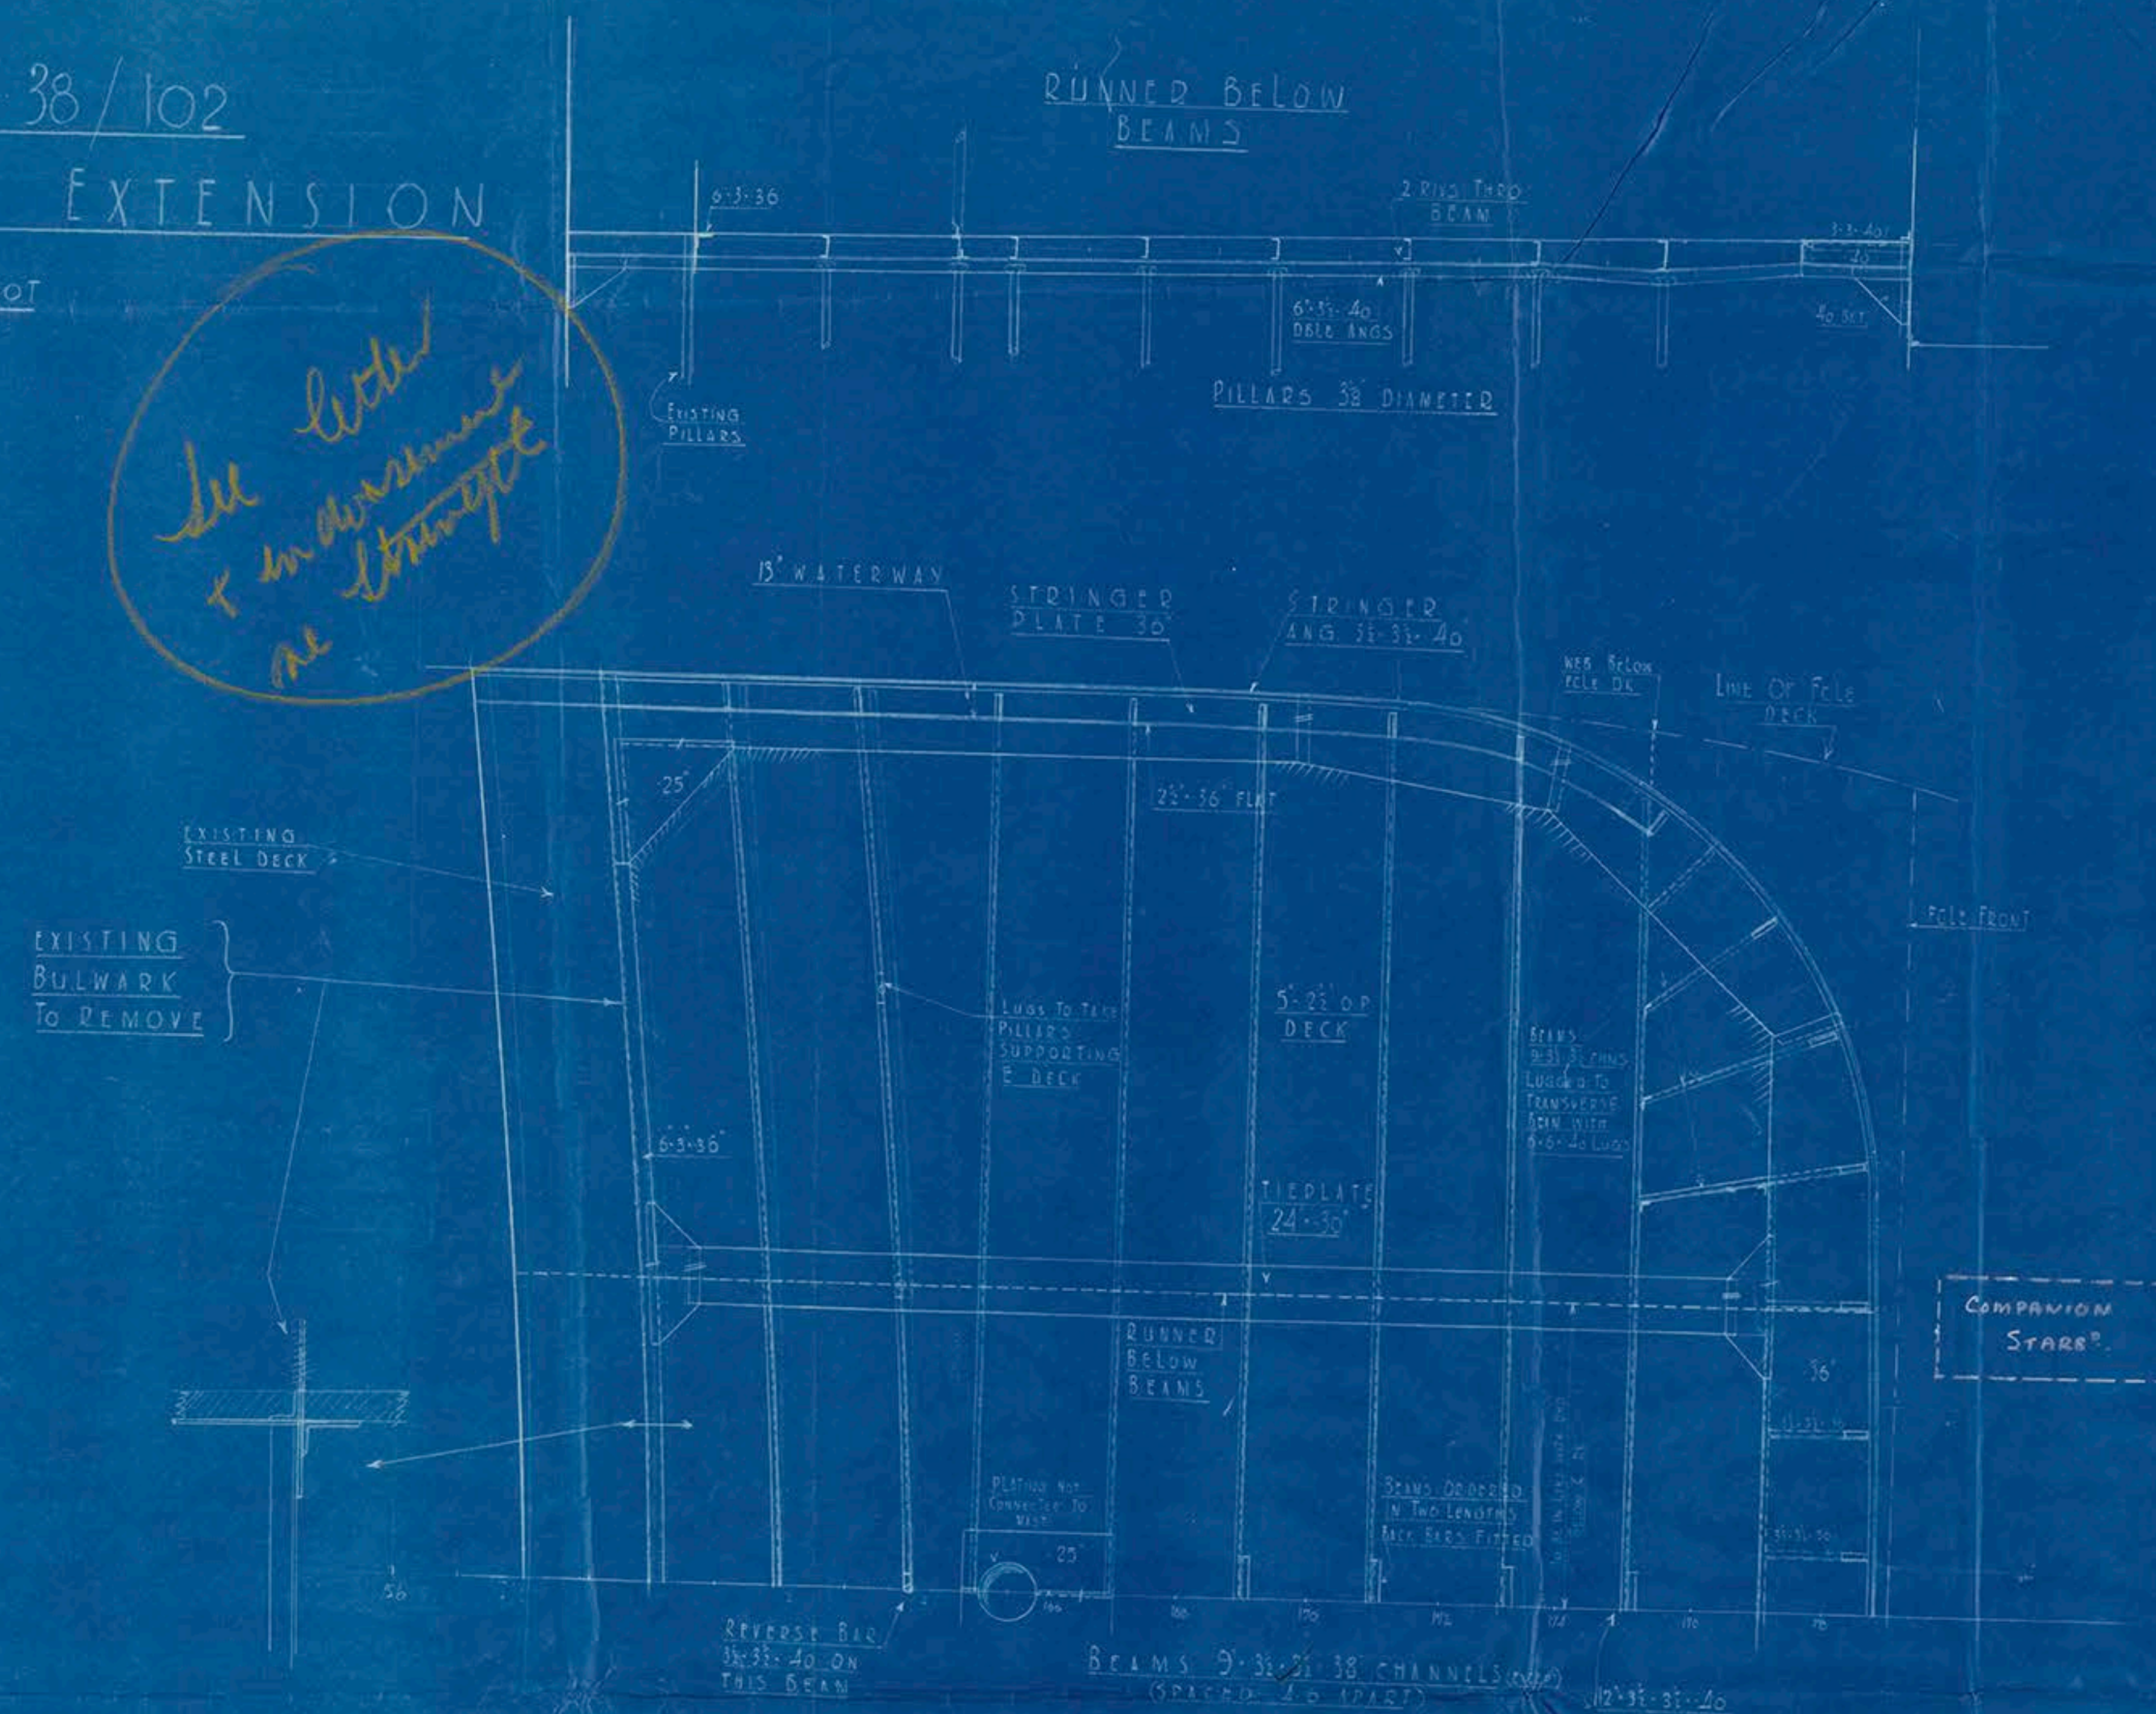

FALMER & SONS
DRAWING OFFICE
HENDON-ON-TYNE

Arandora Star.

'D' deck extension.

NWC: 97008.



© 2018

Lloyd's Register
Foundation

LR-FAF-TB31-P-32