

Lloyd's Register of Shipping

SURVEYS FOR FREEBOARD

Verification Report

FRI. JUN. 9 1922

PARTICULARS IN RESPECT OF STEAM SHIPS HAVING SPAR OR AWNING DECKS.

completely closed. Shell Deck

Port of Survey Manchester
Date of Survey Dec 1921
Name of Surveyor J.R. Dixon

REGIMENT	Port of Registry and Nationality	Official Number	Gross Tonnage	Date of Build	Particulars of Classification
<u>N^o 18 19390 Surv</u>	<u>Manchester British</u>	<u>146830</u>	<u>7895</u>	<u>1922</u>	<u>100A1, with Freeboard (contemplated)</u>

BREADTH	DEPTH	UNDER DECK Tonnage
<u>58.1</u>	<u>25.36 UD 38.35 SD</u>	<u>573.06 UD 7872.41 SD</u>
Frame Depth	Ceiling	Peak
Rule <u>7</u>	Sheer <u>-1.40</u>	Tanks <u>included</u>
<u>28.29 to T.T.</u>	<u>Level tank</u>	
<u>57.43</u>	<u>26.89</u>	<u>5183.06</u>

Moulded Depth as measured 31.0 Deck
41.0 Shell Deck
 Unsound. g. Keel below base line 2 1/2

NOTE:—If the depth is measured when vessel is afloat, the details of measurement should be reported.

CORRECTION FOR LENGTH:—

Length of Ship on Lead Line	<u>450.0</u>
Length in Table	<u>372.0</u>
Difference	<u>78.0</u>
Correction for 10ft.	<u>0.8</u>
x Difference ÷ 10 =	<u>6.24</u>
	<u>+6 1/4"</u>

cess of Lloyd's rules = 38"

4. Angle frame. Spaced 36
 mid. deck. Strengthened
 except due to Chamber
 Straight frames
 highest, with two deep tank
 four rapid peak tanks
 closed by being plated over
 in red from upper deck to
 in way of forward hold

Height of Tween Decks	<u>10.0</u>
(From top of beam to top of beam at side)	
Correction for Height of Tween Decks in Spar-decked Ships	
Freeboard Table B & C	<u>4'-8 1/4"</u>
Correction for Length	<u>+ 6 1/4</u>
Correction for Height of Tween Decks in Spar-decked Ships	<u>5-2 1/2</u>
	<u>10.0</u>
	<u>15-2 1/2</u>
Correction for Strength in excess of Lloyd's rules	<u>3-2</u>
Table A limit	<u>12-0 1/2</u>
Correction for Iron Deck if required	<u>-3 1/2</u>
Other Corrections (if any)	<u>11-9</u>
Winter Freeboard	<u>11-9</u>
Summer Freeboard	<u>7 1/2</u>
Indian Summer Freeboard	<u>10-6</u>
N.A. Winter Freeboard	<u>✓</u>

at 1/2 length from Stem 6 1/2
 " " Sternpost 1 1/2
 abaft amidships

Height State if open or closed at ends.
Closed

Correction necessary because clearside amidships measured in accordance with the Statute is not taken at intersection of the iron deck with side 1 3/4

Winter Freeboard from Deck Line	<u>11-10 3/4</u>
Summer	<u>11-3 1/4</u>
Indian Summer	<u>10-7 3/4</u>
N.A. Winter	<u>✓</u>
(Iron) Deck	<u>11-3</u>
	<u>8</u>
	<u>7 1/2</u>
	<u>7 1/2</u>

amidships from centre of Disc to top of Statutory Deck Line, Shelter
 Fresh Water Line above centre of Disc
 Indian Summer Line
 Winter Line below
 Winter-North Atlantic Line

* If the frames, skin plating, or ceiling are of unusual thickness the breadth of vessel to inside of ceiling should be reported if possible.



Do all the Frames extend to the top Height in the ^{Shell-plate} *Yes* ^{Wing deck} ^{Forecastle}

Do all the Frames extend to the top height in the Poop? Bridge House

To what height do the Reverse Frames extend? *Bull. angle. frames*

Has the Poop an efficient Iron Bulkhead at the fore end?

Give particulars of the means for closing the openings in Bulkhead

Is the Poop connected with the Bridge House? Has the Bridge House an efficient Bulkhead at the fore end?

Give particulars of the means for closing the openings in Bulkhead

What is the thickness of the Bridge Front plating? and Coaming plate?

Give scantlings and spacing of the Stiffeners

Are bracket plates fitted at each end of the Stiffeners? Are hor'l. brackets fitted connecting Bridge Bulkhead with Deckbeams?

Has the Bridge House an efficient Iron Bulkhead at the after end?

How are the openings closed?

Is the Forecastle at least as high as the main or top-gallant rail? *8-2 beam* Has the Forecastle an efficient ^{Steel} Iron or Wood Bulkhead at after end?

Are the Engine and Boiler openings covered by a Bridge, Poop, or enclosed by a Strong Iron or Steel Deckhouse? *Steel casing deck house*

If the openings are not so protected are the exposed parts of the Casings efficiently constructed?

Give thickness of plating; scantlings and spacing of Stiffeners


What is the height of the exposed Casings? Are suitable means provided for closing all openings in them in bad weather?

Are the Weather Deck Hatchways efficiently constructed and at least equal to the requirements of Section 28 of the Rules for 1904-5? Give particulars below:— *As per approved plans*

Position and Size	201.270 x 16.0		202.5 36.0 x 26.0		203.4 16.0 x 26.0		207.270 x 20.0		207.120 x 20.0	
Item	Ship	Rule	Ship	Rule	Ship	Rule	Ship	Rule	Ship	Rule
COAMING	Height above top of DECK	2.7	2.7	2.7	2.7	2.7	2.7	2.7	2.7	2.7
	Thickness	.50	.50	.50	.50	.50	.50	.50	.50	.50
SHIFTING BEAMS OR WEB PLATES	Number	5	5	7	7	2	2	5	5	5
	Section and Scantlings	13.02	13.02	16.06	16.06	18.06	18.06	16.06	16.06	16.06
	Material									
FORE AND AFTERS	Number									
	Section and Scantlings									
	Material									
HATCHES Thickness	3"	3"	3"	3"	3"	3"	3"	3"	3"	3"
Remarks	Bull. angle. fitted to side, need coaming. stayed.									

* When the Fore and Afters are of wood the depth should be stated from the underside of the hatches.
 (If the sill of the lowest side scuttle will be less than 6 inches above the Indian Summer Load Line if assigned under the tables, state vertical distance from top of deck at side amidships to lower edge of lowest side scuttle.)

6-2 pipe scupper led from upper Deck to bilge
 no steel except due to Camber
 Lond. Displacement = 166572, Dwt per mt. = 51.2

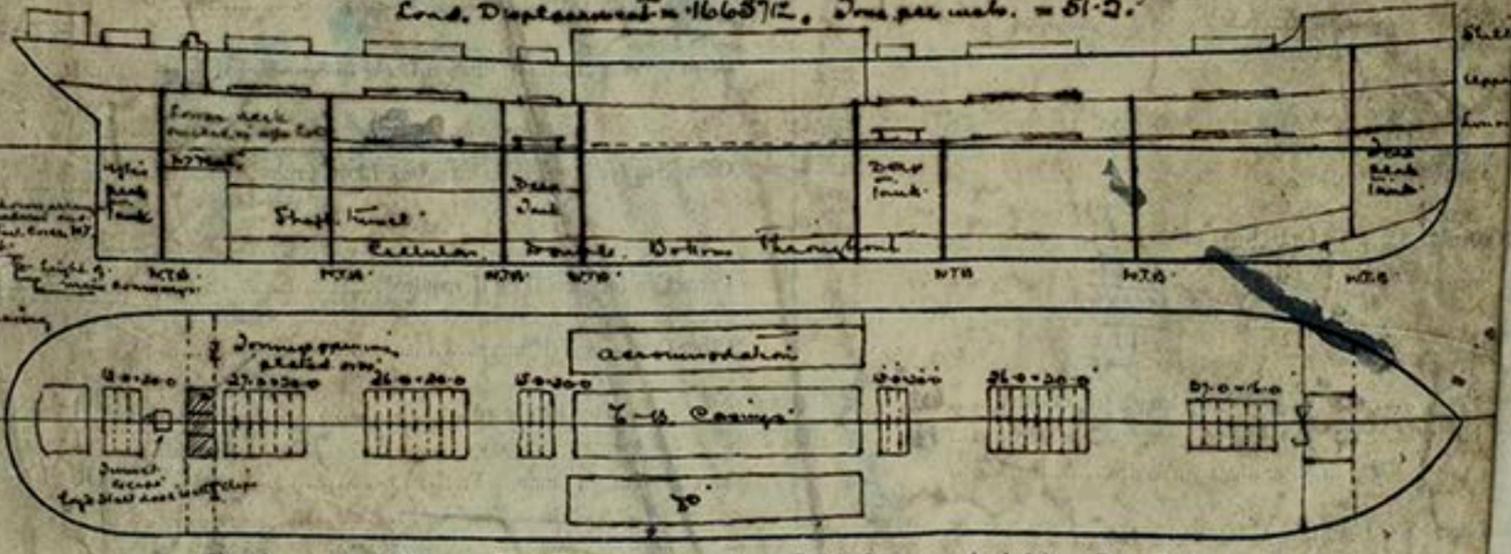

Show hereon line of Floors or Tank Top with position of any Breaks in same; also height of Peak Tank tops, &c., &c.

State any special features in the construction of the Vessel *This vessel has been built in accordance with the approved plans, copies of which are retained in your office.*

Completely closed Shell-Deck; no steel except due to Camber. Straight frames no tumble home; Bull. angle. frames. Thin deck laid, but lower deck omitted in Ceiling and in inner bottom. Through. Spar ceiling fitted except in Shell-Deck. Sides vessel to S.S. 'Delicious' Yard 2019. Ind. Reg. No. 11809.

Copies of the approved plans are retained in Lond. office.

Builder Messrs. Dumas S. 150 & Co. No. 18

Address *Lee F. G. Report*

Fee £ 13. : 0 : 0

Received by me *Lee F. G. Report*

MANCHESTER
 Number in R
 Registered Dimensions from Ship's Register.
 Length on LOADLINE
 CORRECTED DIMENSIONS.
 Co-efficient of Any modification [Para. 4 (a)]
 Co-efficient as o
 Allowance for st
 State particulars
 Sheer at Stem
 Sternpost...
 Drop
 Round of Spar-deck Beam
 " " Main-deck "
 Forecastle Length 42'
 Bridge.....
 Poop.....
 FREEBOARD recommended
 SUMMER FREEBO
 Tropic
 Fresh
 Tropic
 Winter
 Winter
 JUN 1937