

Lloyd's Register of Shipping.

Ship's Name **"BRIARFIELD"**

Official No. **143669.**

Memorandum of alterations reported since ship was surveyed for assignment of Load Lines in **/**

ALTERATION FOR NEW ACCOMMODATION OF CREW.

Accommodation has now been made in the Forecastle Space for the crew.


A steel bulkhead has been erected at the Forecastle front of strong construction and is fitted with 2 hinges each side with brass locks operated both sides.

Size of openings **5'0" x 2'0"** with **2"** sill.

The Forecastle deck has been removed in steel.

The companionway to the previous accommodation has been removed and the deck opening patched over.

An access hatch to the above space has been fitted on the starboard side **22" x 22" x 15"** coaming fitted with hinged steel W.T. covers secured by toggle screw fastenings.

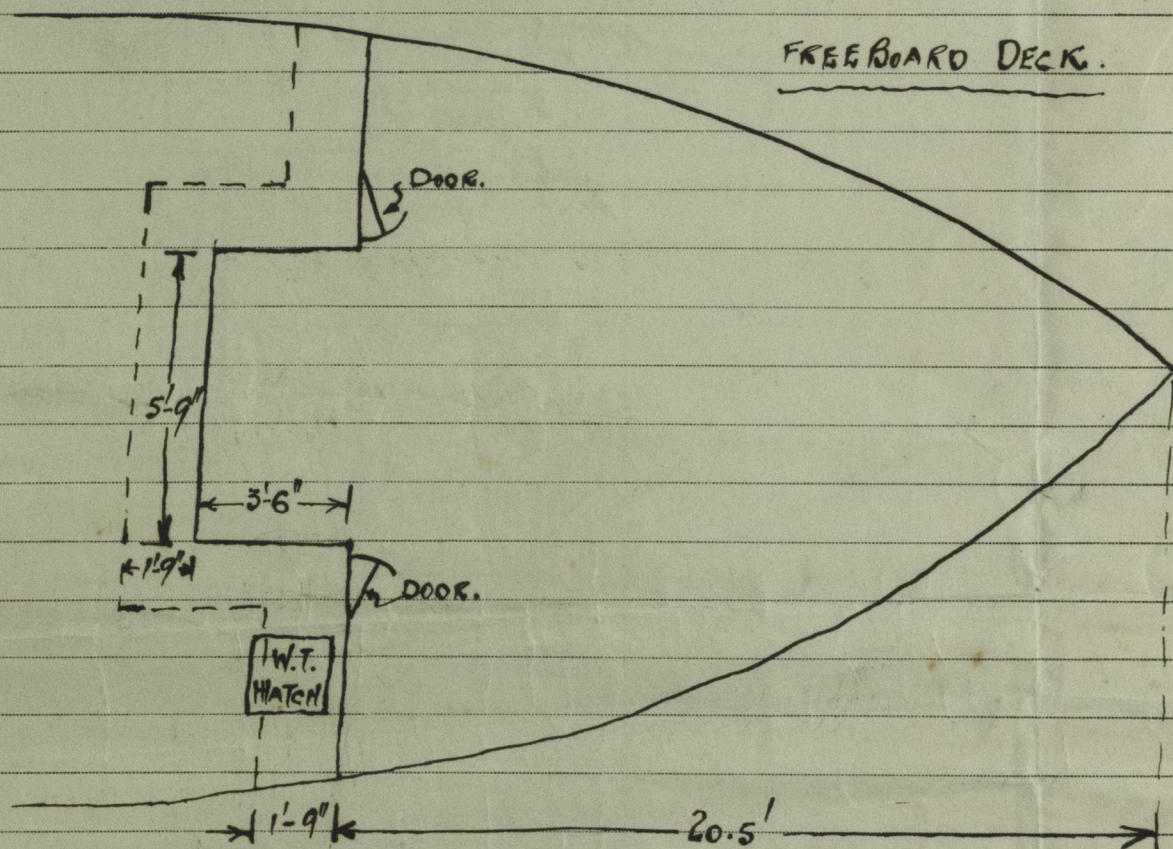

Ships' Copy.