


No 105.

PROFILE & DECK PLAN

SCALE 1/8" = ONE FOOT.

28/5/19

LENGTH S.P. 200'0" BREADTH M.P. 30'6" DEPTH M.P. 15'3" M.P.

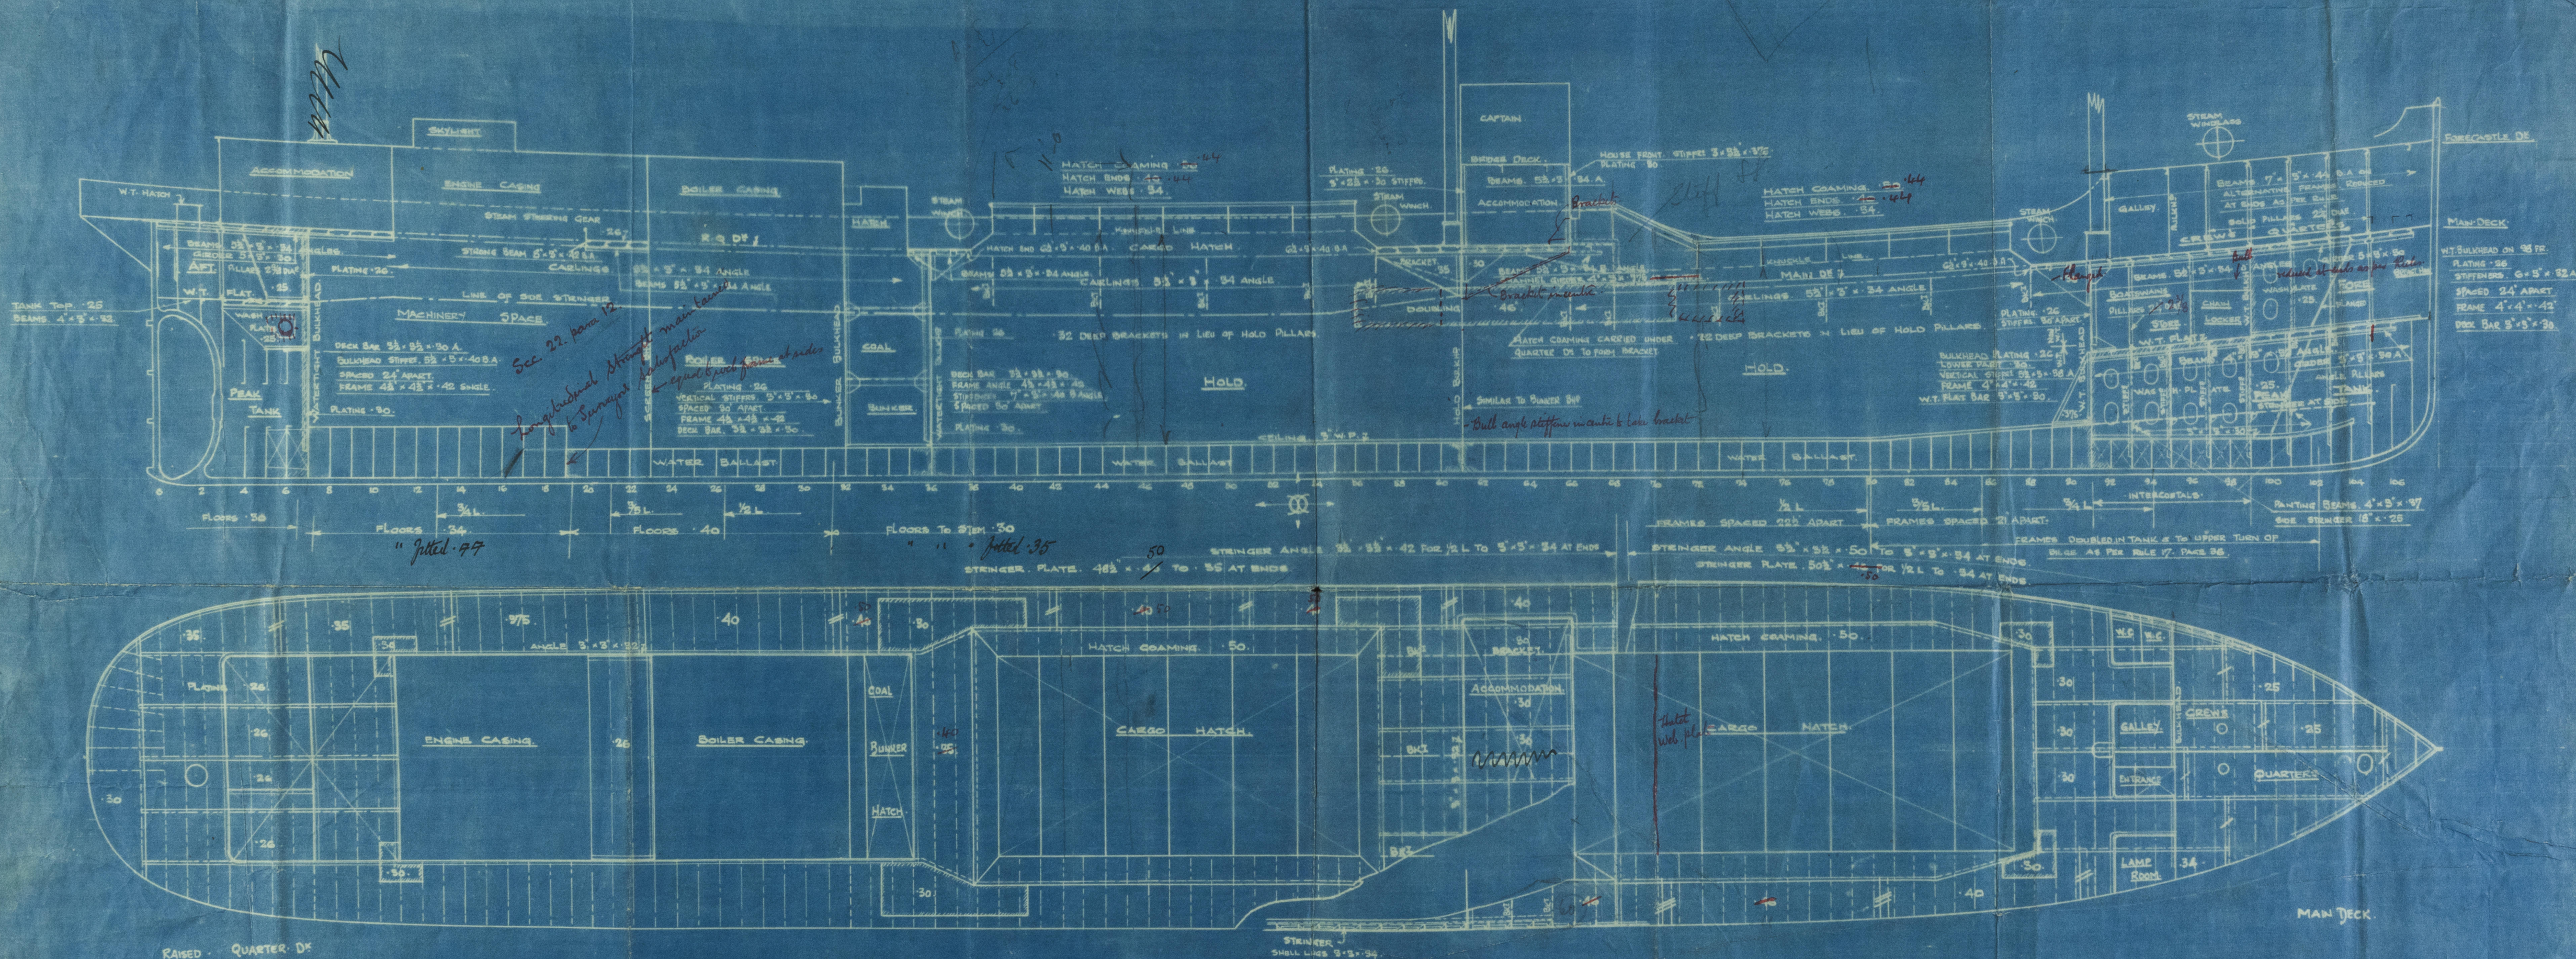

APPROX. PARTICULARS FOR FREEBOARD.  
REGISTERED DIMENSIONS. 200'0" x 30'6" x 15'3"  
UNDER DECK TONNAGE APPROX. 650 TONS.  
SHEER AT STEM 5'0 1/2" 1/8" FROM STEM 3'3 1/2"  
SHEER AT STERN 3'6 1/4" 1/8" STERN 1'11"  
FORECASTLE CLOSED.  
BRIDGE HOUSE CLOSED.

B.M.M.  
H.6.19



Messrs. The Dublin Dockyard Co.

O.D. N<sup>o</sup> 106

Profile & Deck Plan.

"Finola"

Dub. 4055.

"Short Queen"

RETAIN