





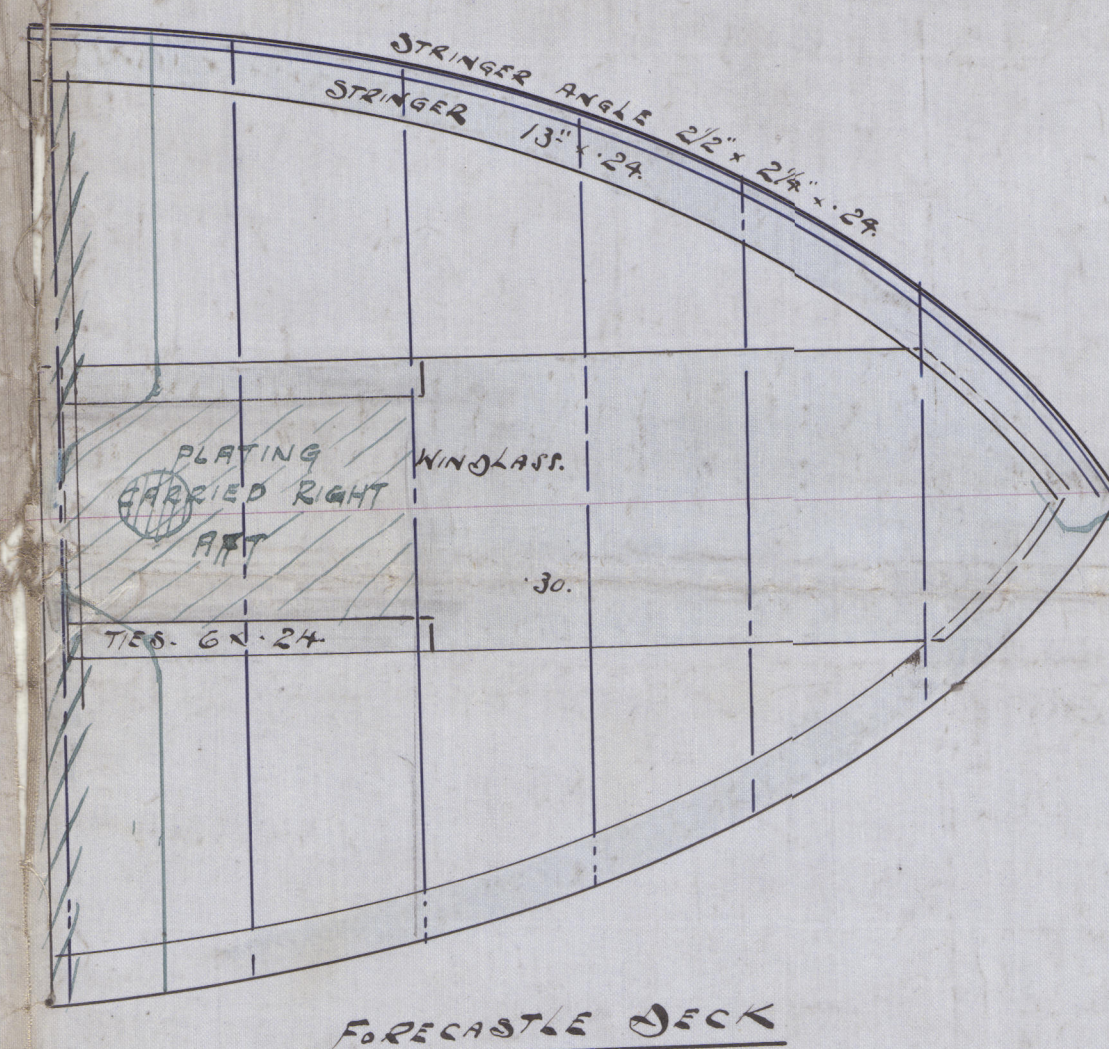

S. N^o 222

SCALE $\frac{1}{4}'' = \text{ONE FOOT.}$

76. 49 55 100 A. 1.

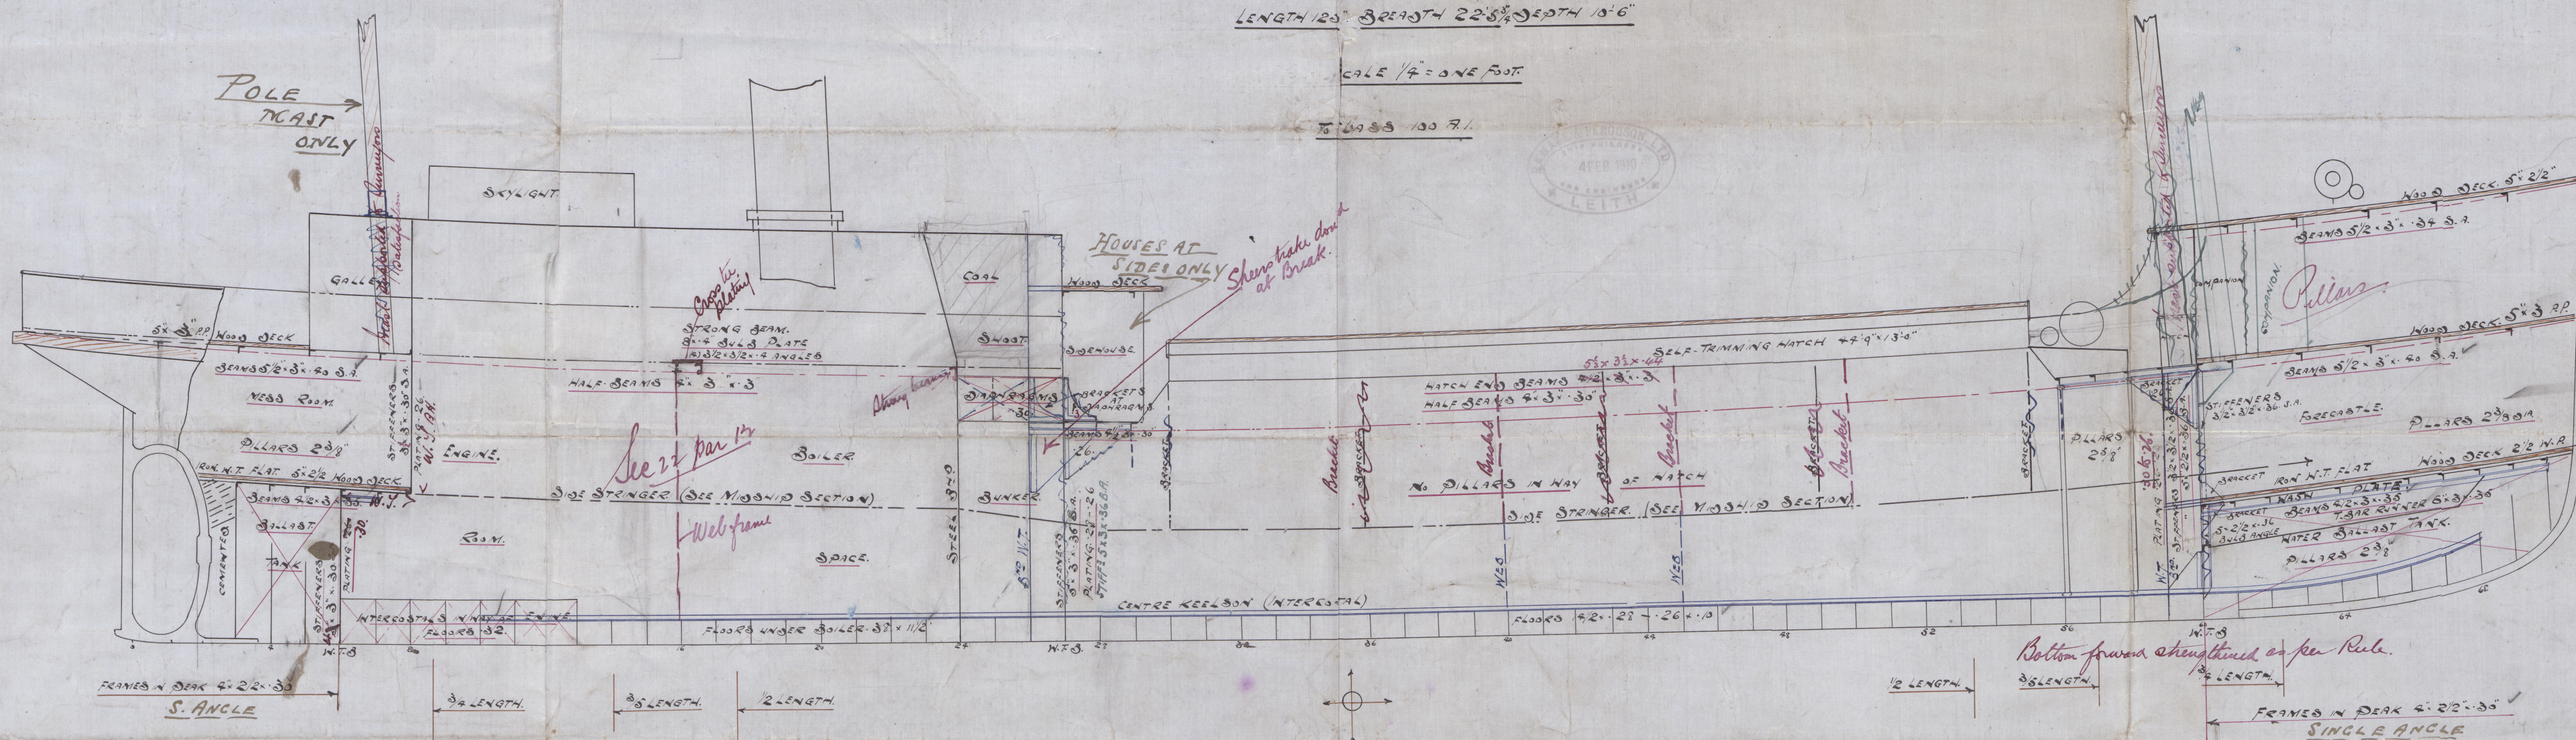


NOTE.
FRAMES CUT & BRACKETED IN
WAY OF H.T. FLATS.

Bottom forward strengthened as per Rule.

FRAMED IN DEAK 4" 2 1/2" x 30"
SINGLE ANGLE

NOTE SULKHEAD STIFFENERS ARE HEAVIER THAN REQUIRED BY
RULES SO THAT NO BRACKETS WILL BE FITTED AT
TOP OR BOTTOM OF STIFFENERS.

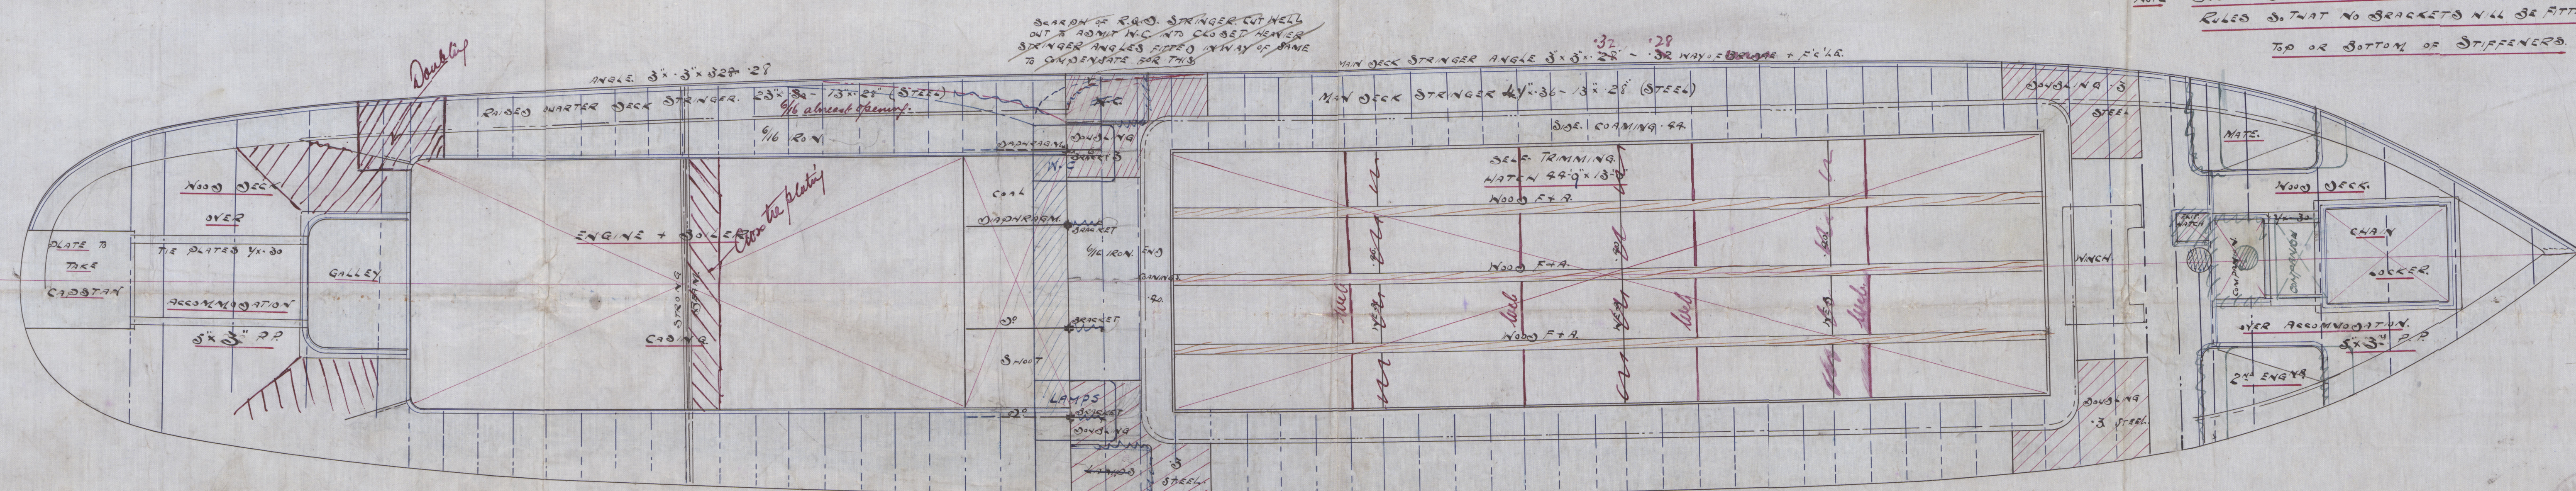

C.F.
9/2/10.

A. S. 112

Profile Plan

Plan Damage & Argueson
Leith

St. Catharines

Leith 13060



SS. 112





© 2019

Lloyd's Register
Foundation