

2069

8 OCT 1952

Rpt. C. 11 (Contd.)


Index No.

Lloyd's Register of Shipping.

Ship's Name "CARNDUFF" Official No. 129633.

Memorandum of alterations reported since ship was surveyed for assignment of Load Lines in ✓.

CARGO HATCH ON UPPER DECK.

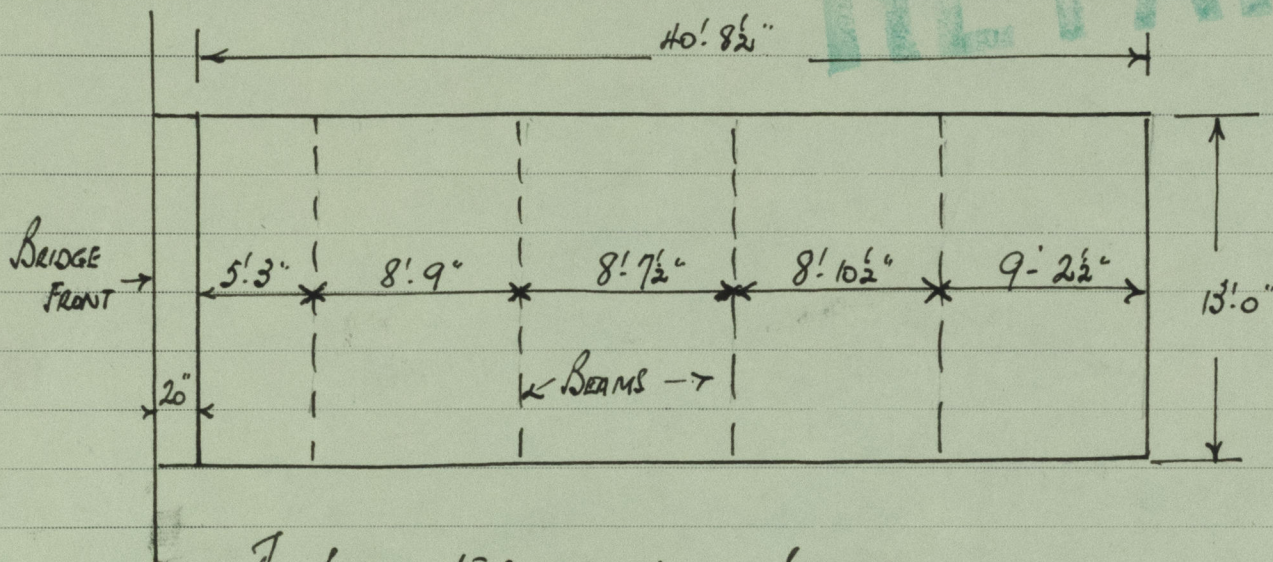

The fore & afters remain unchanged.

Robert
5.10.52.

repat & please.



© 2019

Lloyd's Register
Foundation