
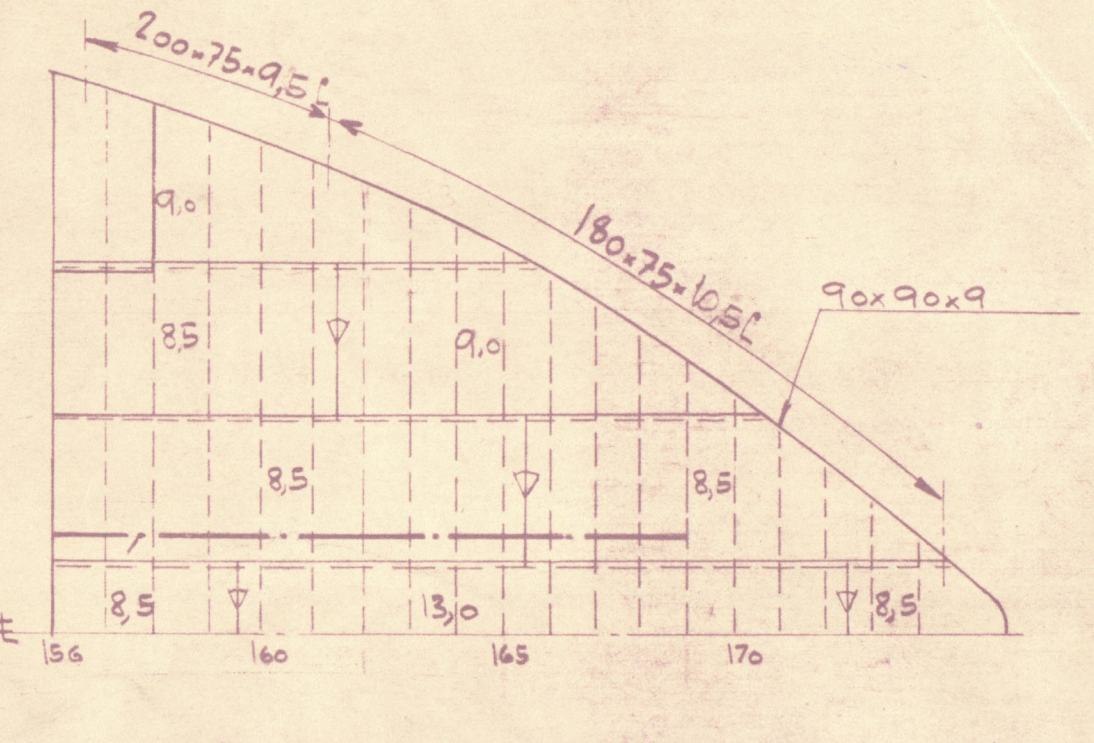
 
 


LAPS SINGLE RIVETED.  
V-WELDING.

 

# DIMENSIONS

|                     |                     |
|---------------------|---------------------|
| LENGTH PP           | 418'-0" = 127.405 M |
| BREADTH MOULDED     | 56'-0" = 17.22 M    |
| DEPTH TO UPPER DECK | 38'-0" = 11.58 M    |
| " " MAINDECK        | 29'-3" = 8.915 M    |

ALL BULBANGLES NEW GERMAN  
STANDARD SECTION

# RETAIN

CLASS LLOYDS REGISTER #100A1  
WITH FREEBOARD FOR A DRAUGHT CORRESPONDING  
TO A COMPLETE SUPERSTRUCTURE VESSEL  
HAVING A TONNAGE OPENING

OWNERS' REQUIREMENT.

WARCH/SECT 595  
GOTHENBURG FIRST ENTRY REPORT No. 13474.  
m/s "Akka"

RECORDS DEPT  
LONDON

4

|                                   |  |         |         |
|-----------------------------------|--|---------|---------|
| AKTIEBOLAGET GÖTAVERKEN           |  | DEST NO | UTX DAT |
| M/S 568 <del>568</del> "Akka"     |  |         |         |
| LONGITUDINAL SECTION<br>AND PLANS |  |         |         |
| 9000 TONS ORE CARRIER             |  |         |         |
| By filled 1                       |  |         |         |
| RTAD. AV. B.S.                    |  |         |         |
| KOP. AV.                          |  |         |         |
| GRANSK. AV. <i>Arwid</i>          |  |         |         |
| © 2020                            |  |         |         |
| 568                               |  |         |         |
| Lloyd's Register                  |  |         |         |
| #119577                           |  |         |         |

CORRECTED AS BUILT 1-3-42.  
CORRECTED AS APPROVED BY LLOYD'S REGISTER 30-10-60.