


15<sup>TH</sup>. FEB. 1926.

x 12' 10 1/2" " " QUARTER Dk

$$\begin{array}{r} 23 \times 6 = \\ 47 \div 4 = 11.75 \\ 70 \end{array}$$

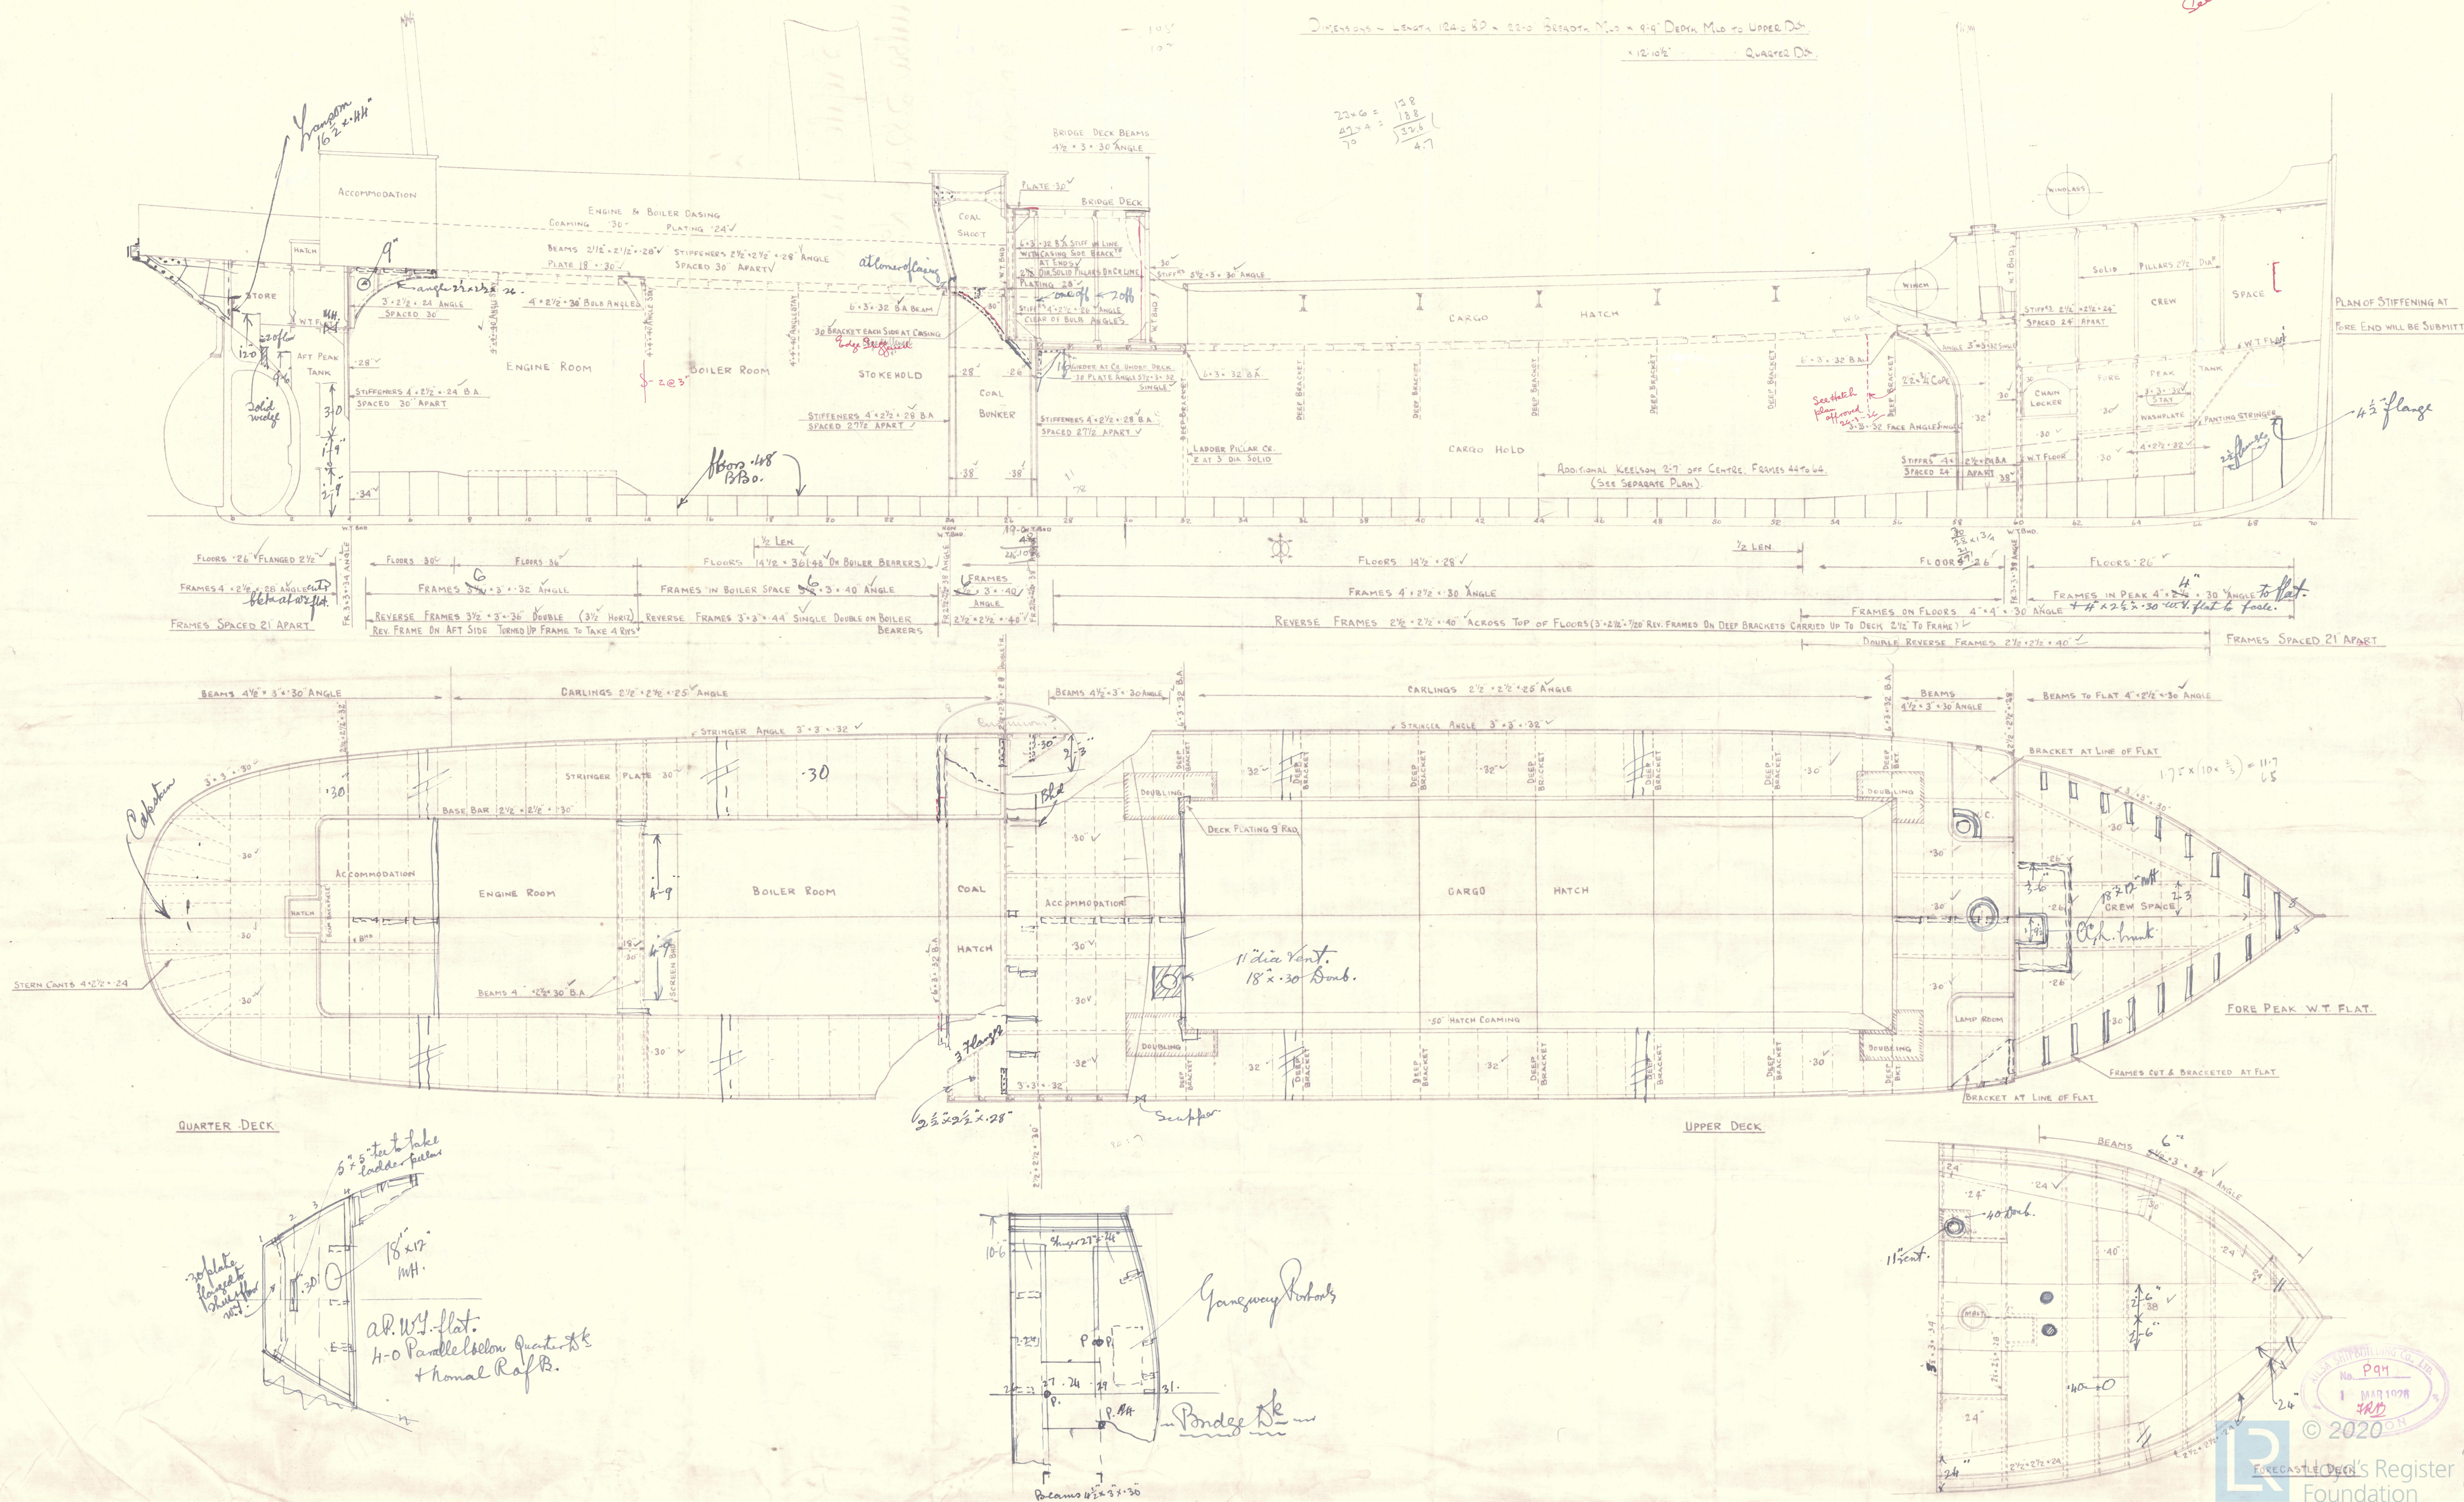


2

Profile & Deck.

Ailsa S.S. Co. No 299.

2-2-26.

T.C. 19/5/26.

5/2" MOYALLON

RETAIN



© 2020

Lloyd's Register  
Foundation