


Aggiornato a tutto il

13.

8 GEN. 1953

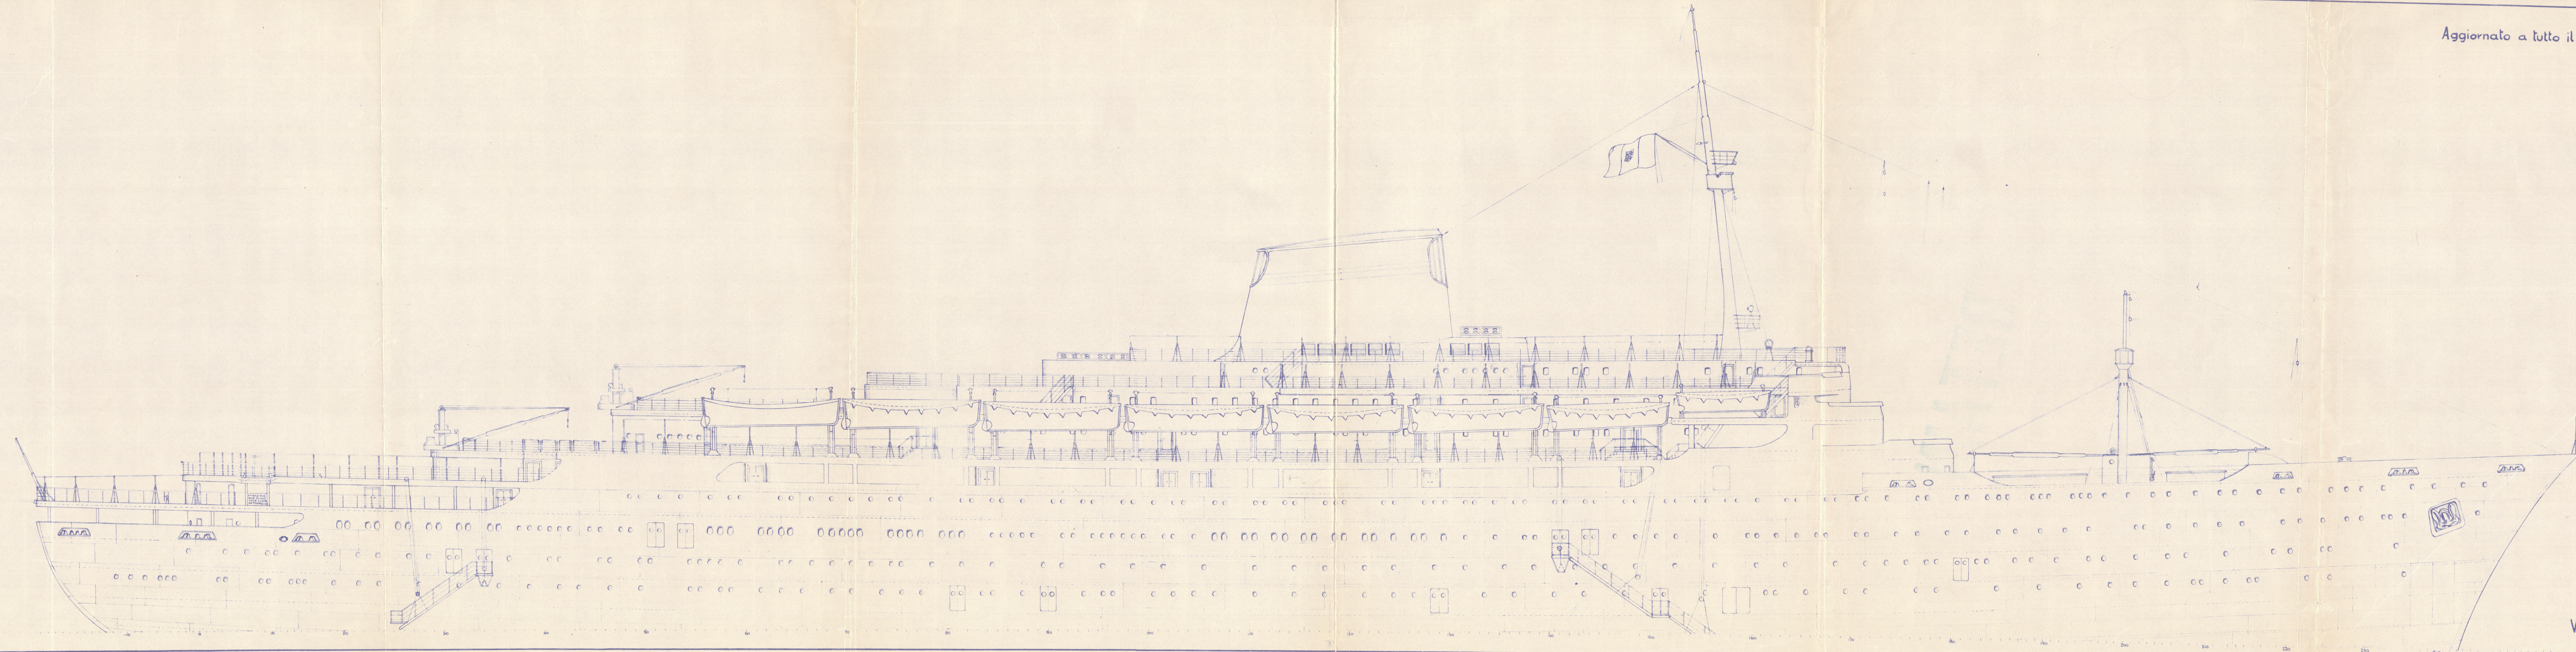



S/S ANUREA DORIA  
ANALCO'S YARD "918"  
GENOA Rd. 19132

RECORDS DEPT.  
LONDON

2

Andrea Doria  
Gen Coast

RETAIN



© 2020

Lloyd's Register  
Foundation

002013-002023-0133