



1. 11. 02
8. 12. 02
9. 2. 03
14. 2. 05

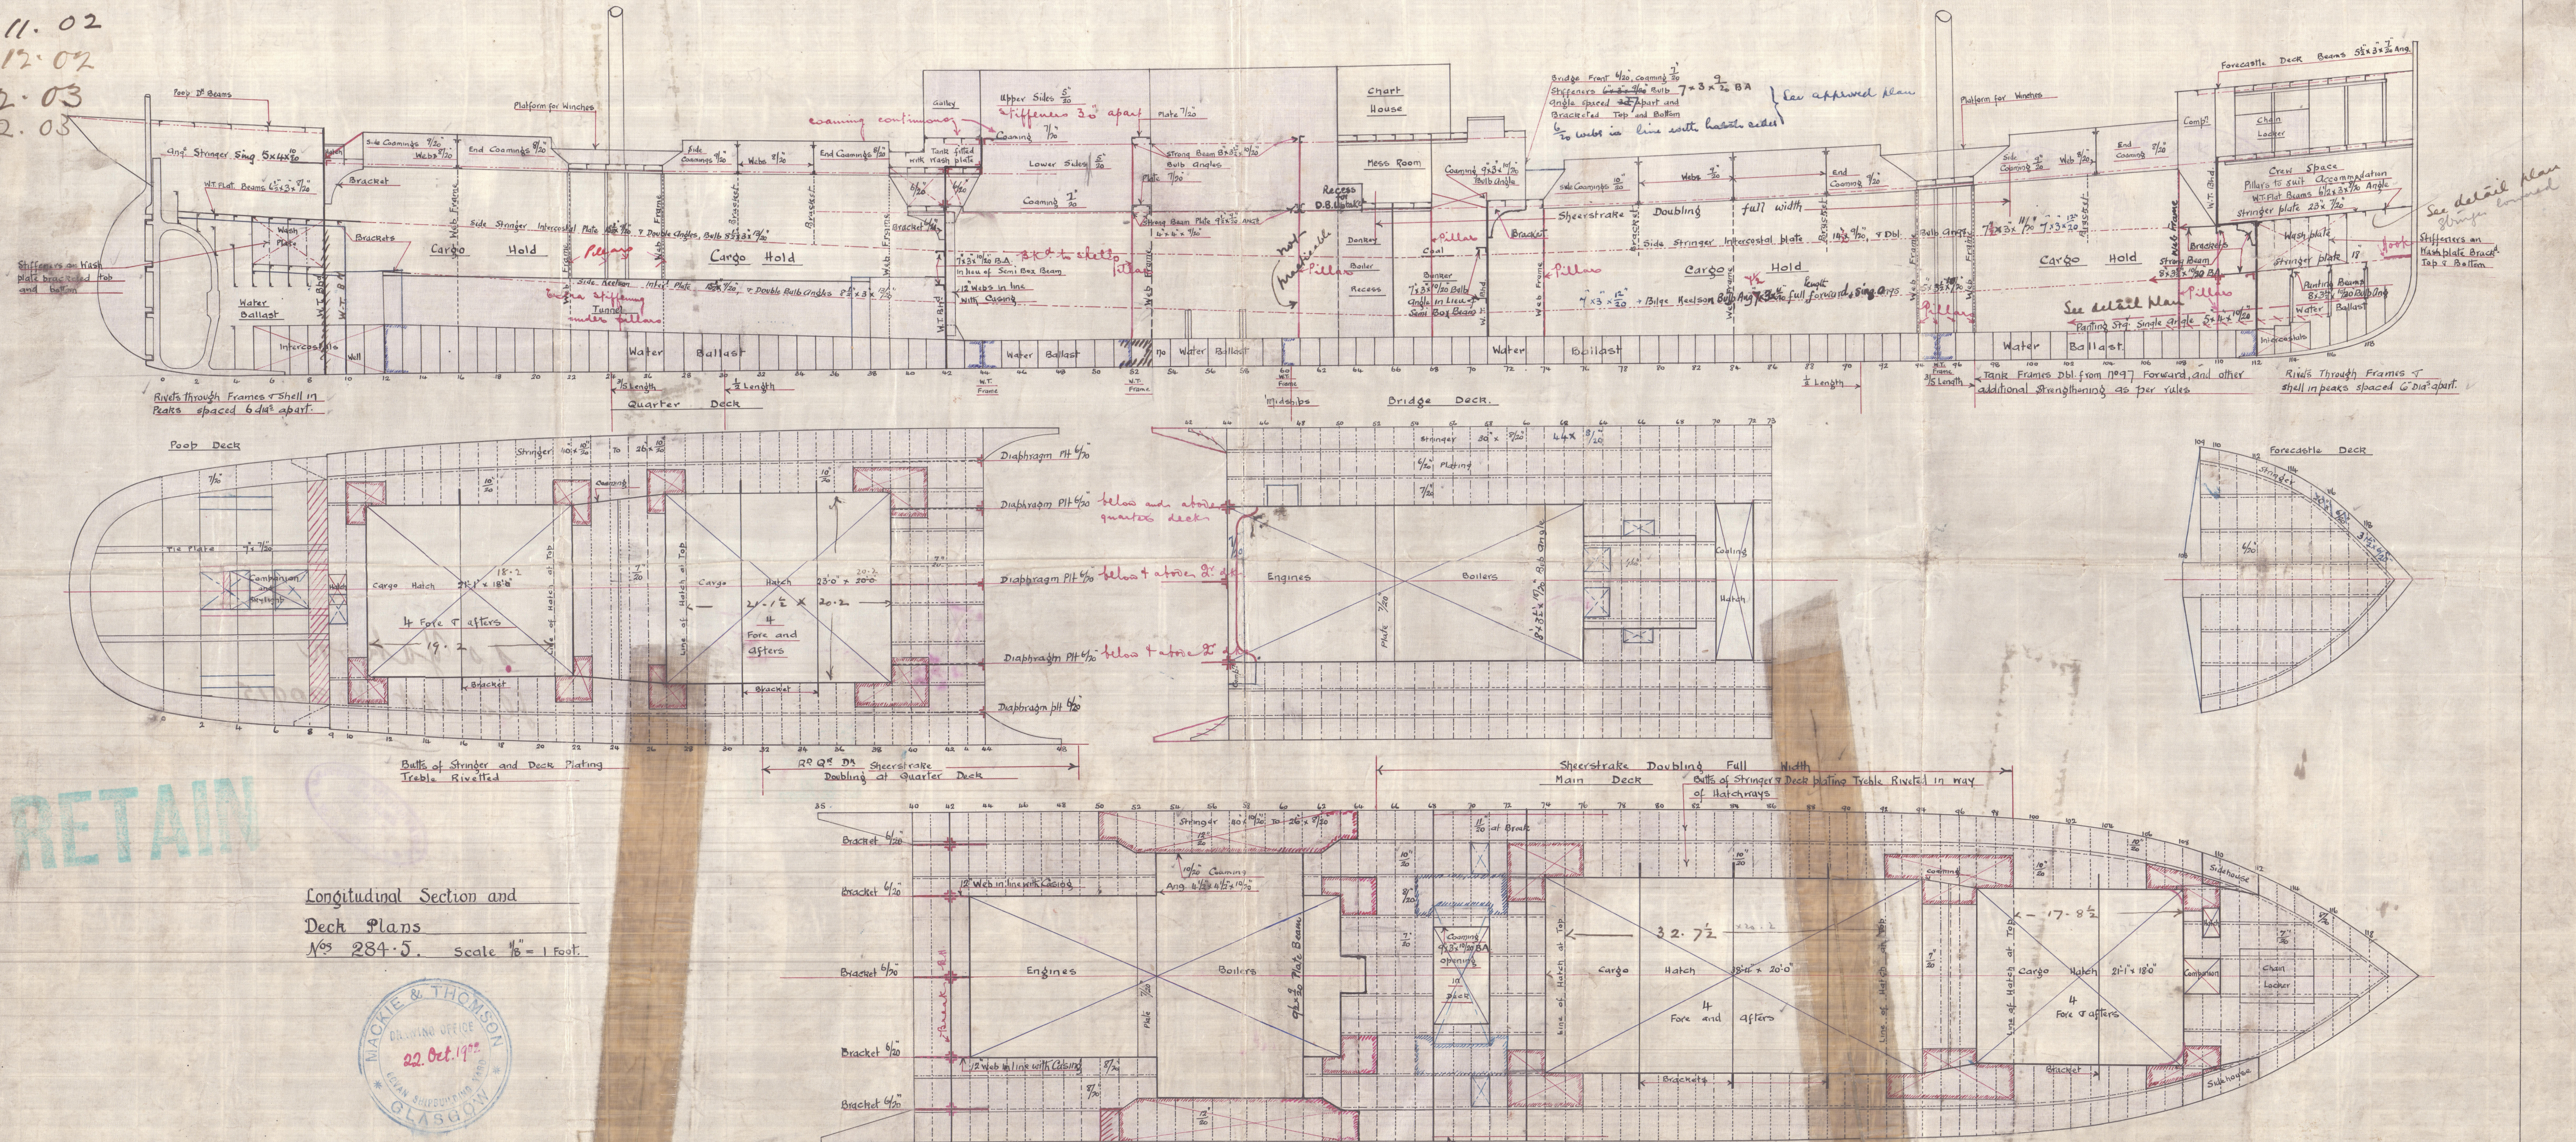

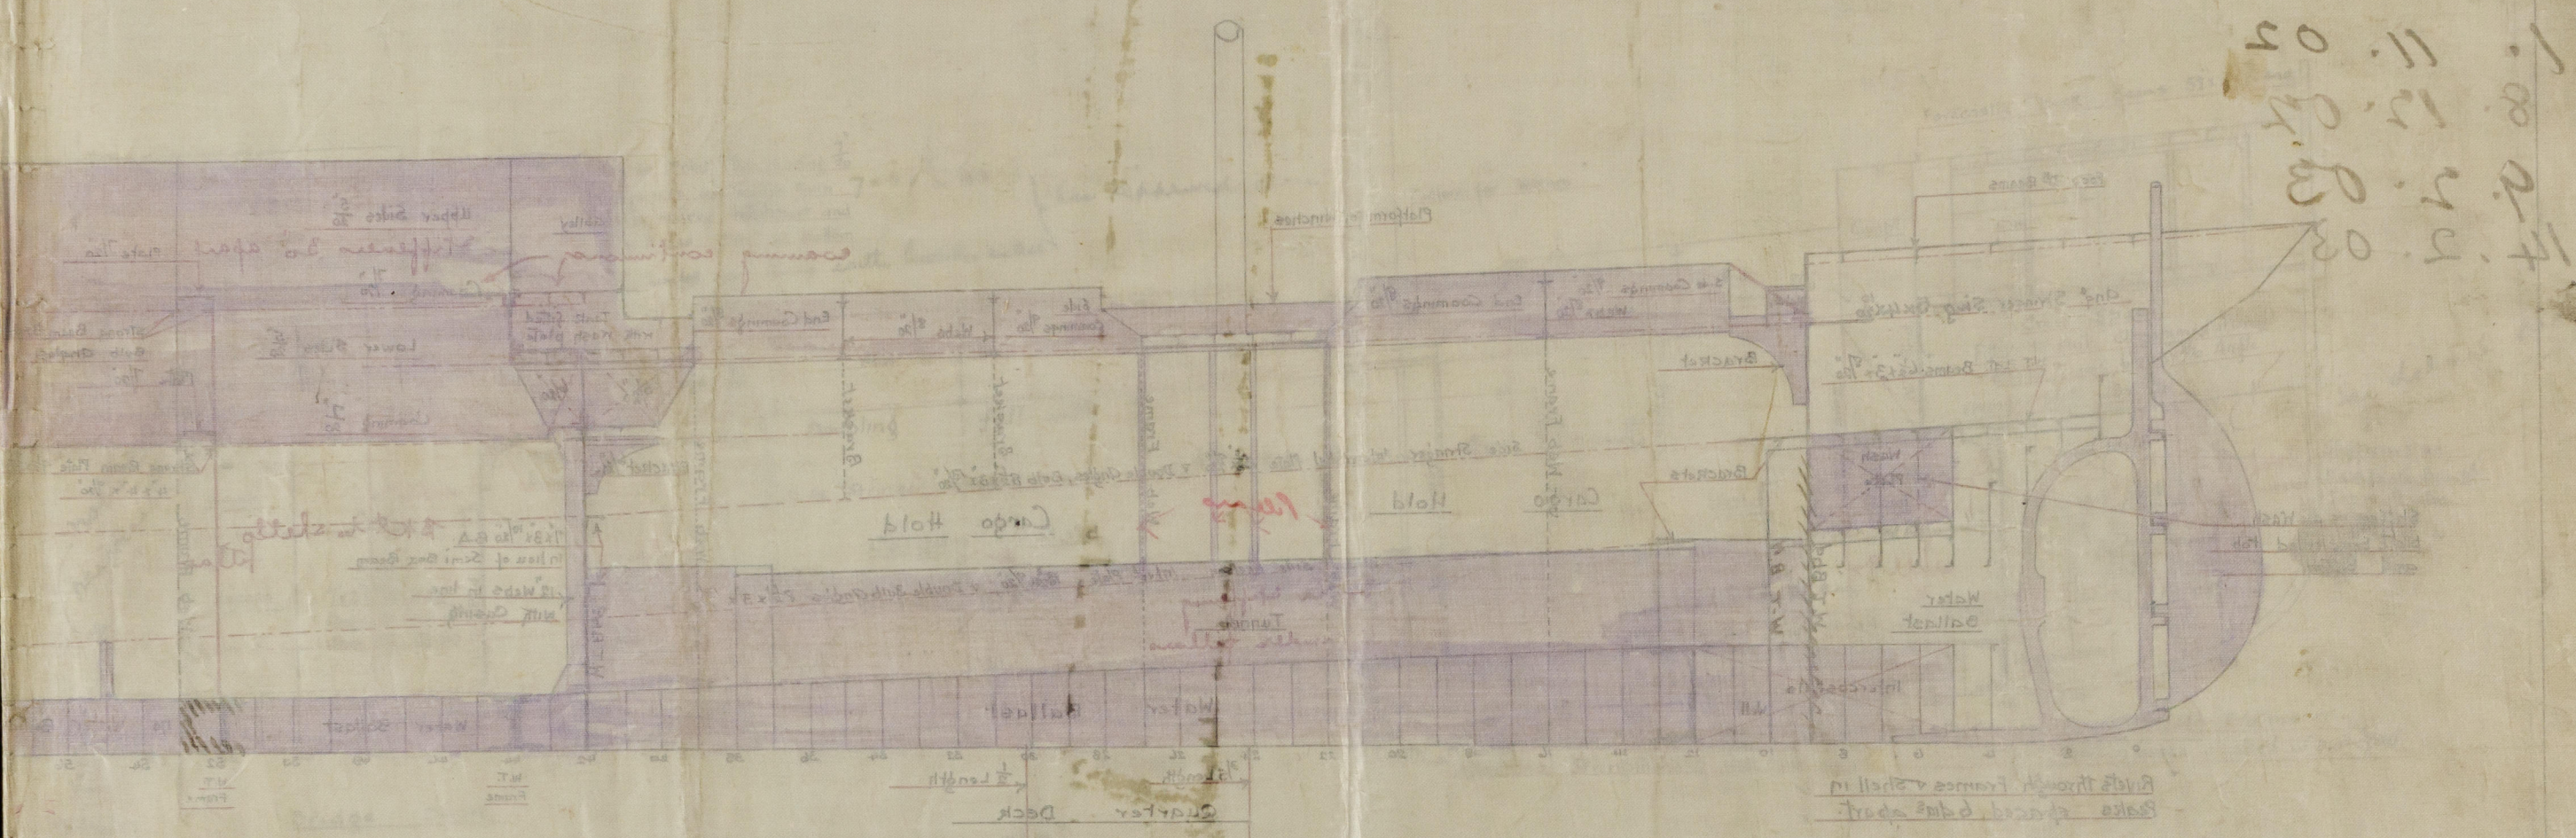


*1st Yukon
 No 20915*

*1. 11. 03
 8. 12. 03
 4. 2. 03
 14. 2. 03*

*44
 5
 70
 167*

*37
 28
 65.5*

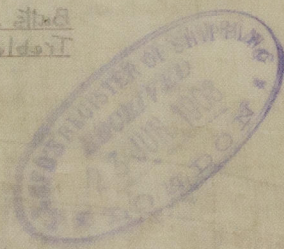

RETAIN

*Longitudinal Section and
 Deck Plans
 No 284-2*

