
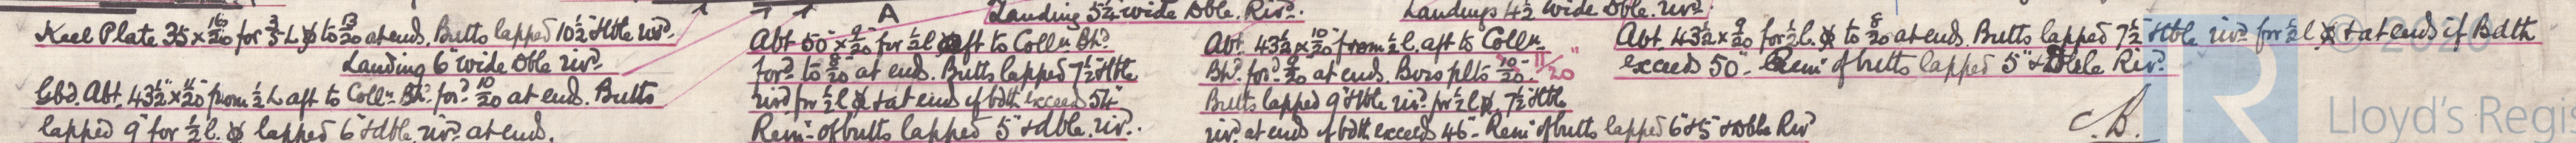
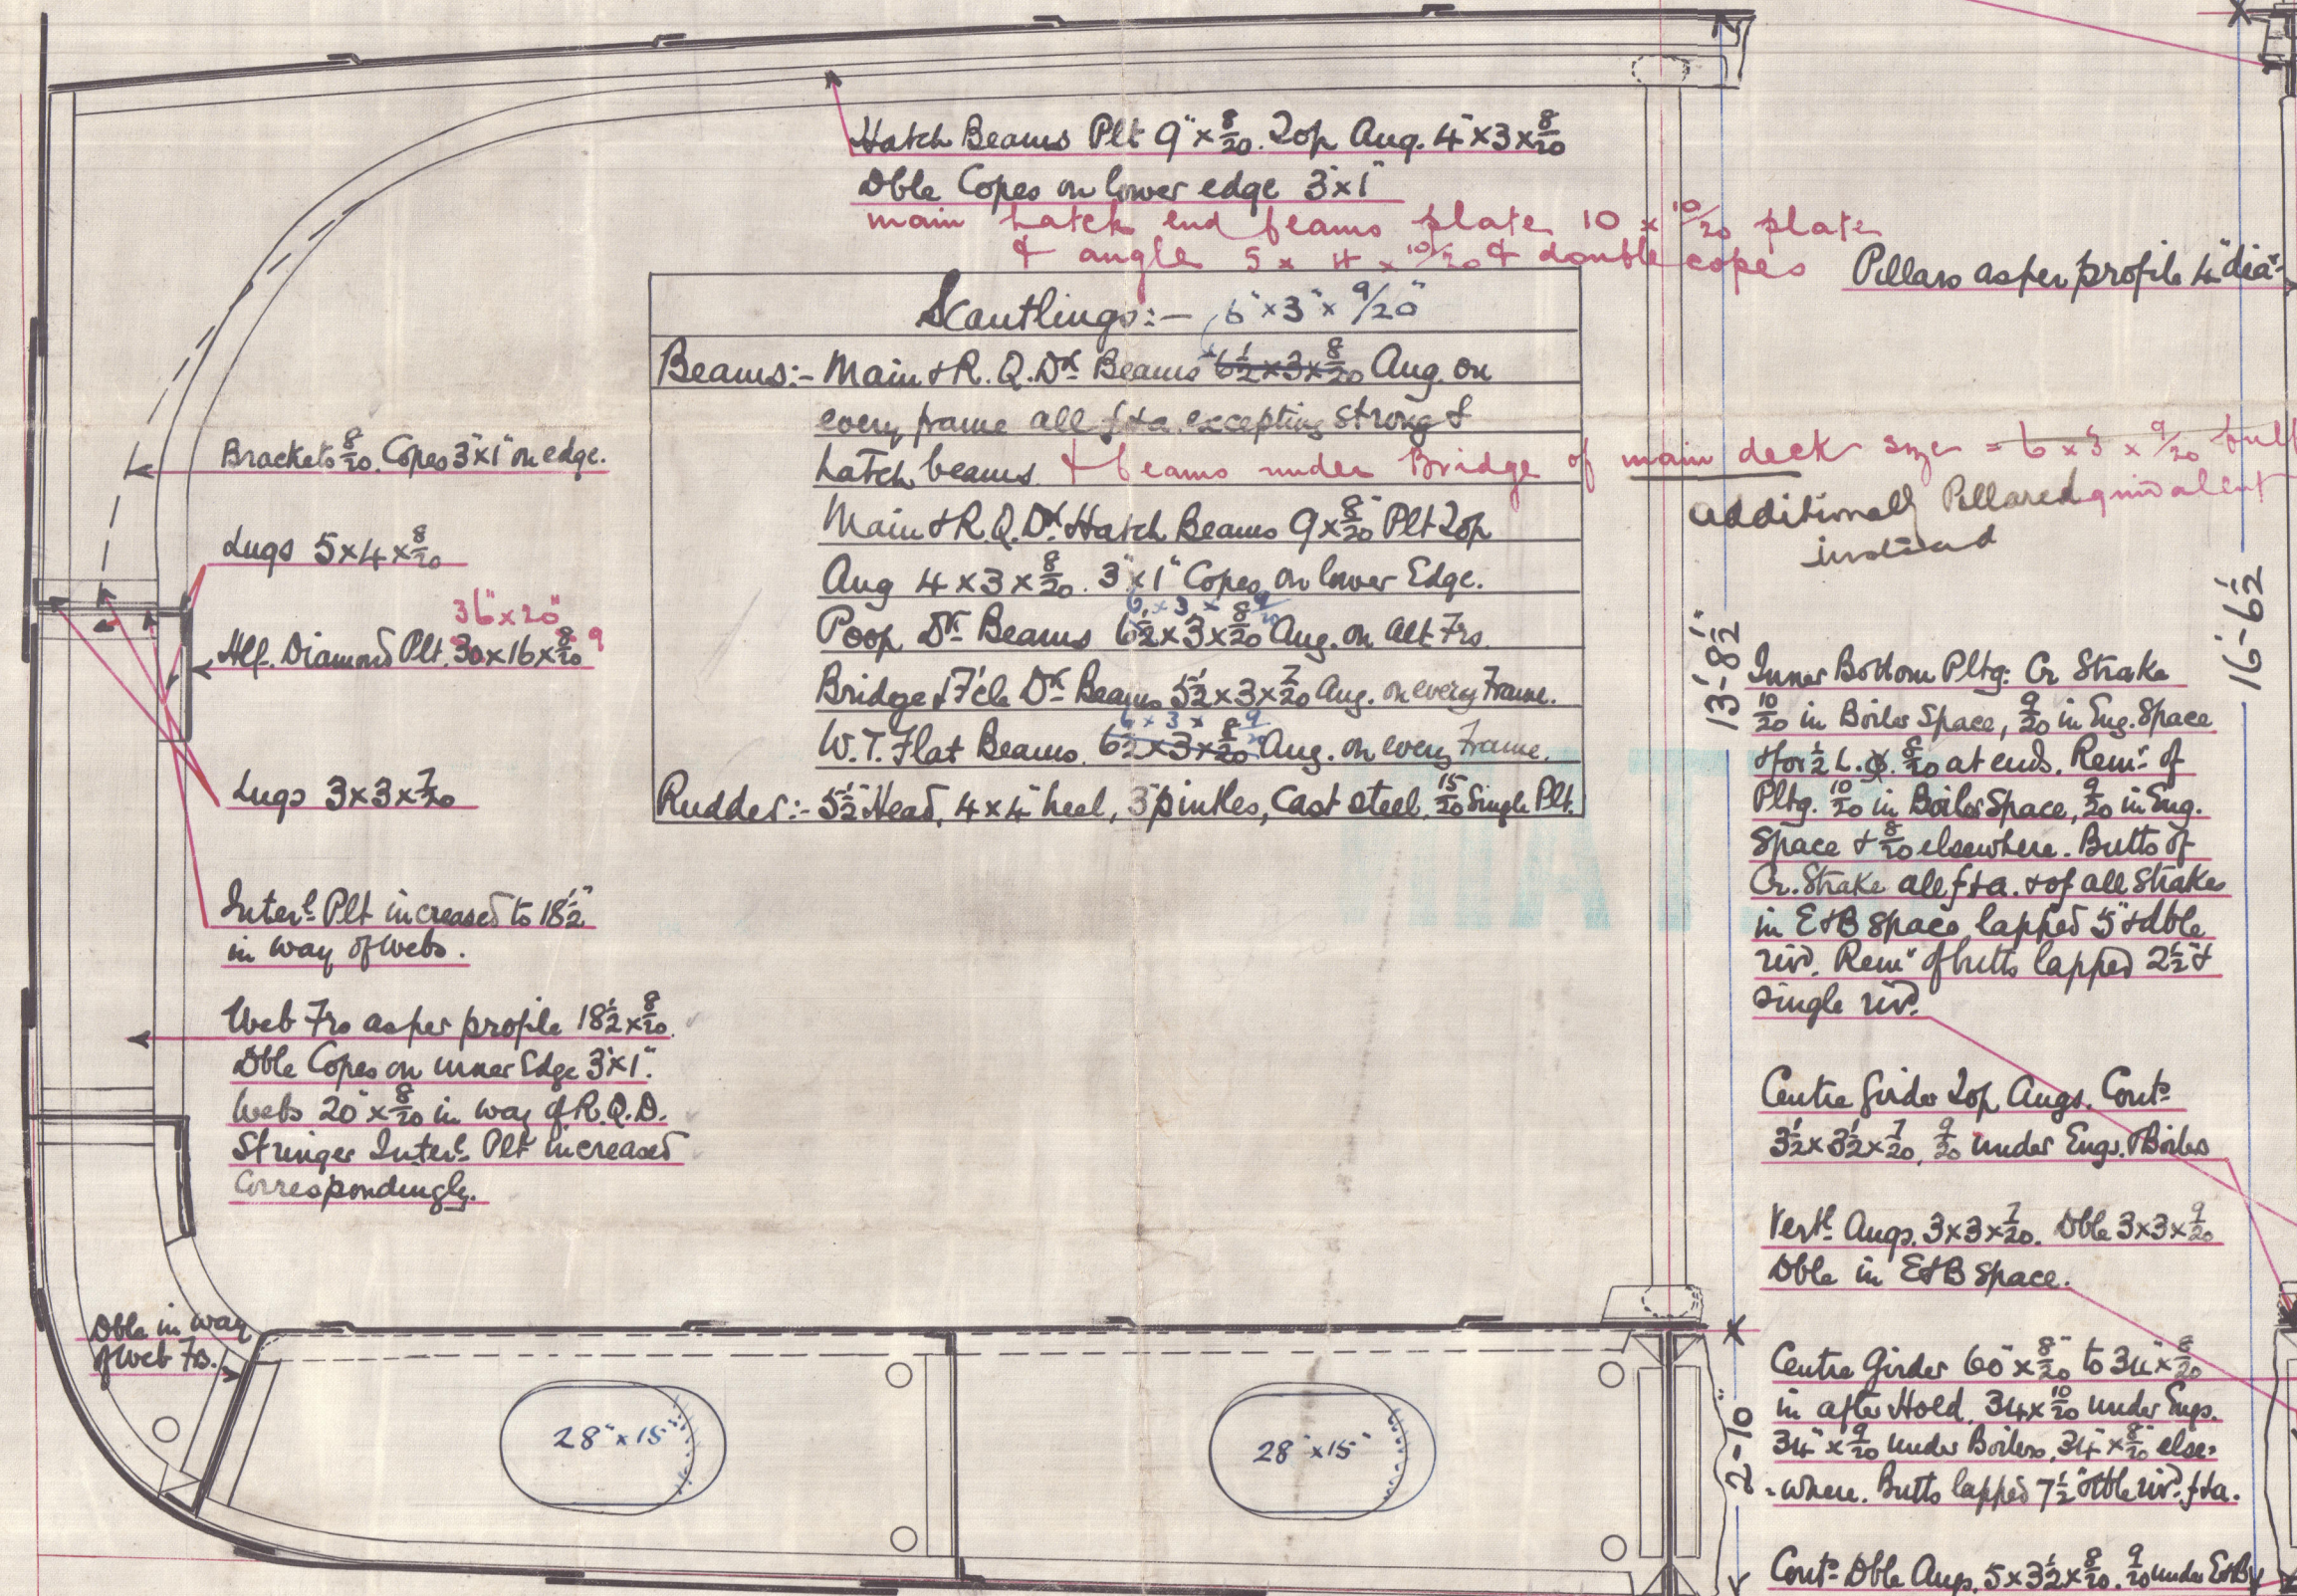


232'-0" A.P. x 34'-0" W.D. x 15'-10" H.D.
20 Class + 100 A.I. Steel Well Deck.
Constructed as a R.P. Frame System with Built Angle
Frames & Web Frames in Way of Hatches.
To have Prop. Raised Quin. Deck. Bridge & Forecastle
Scale $\frac{1}{2}$ = 1 foot.

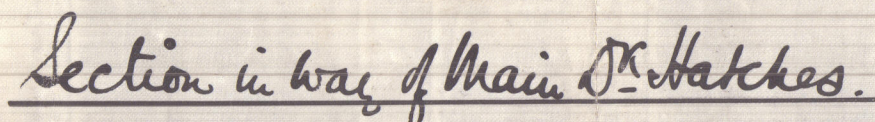

Lloyd's Register
Foundation

002013-002023-0193

10th Feb
Yukon
file #1 No 20415

N/N


002013-002023-0193

Section
Mackie Thompsons 1475-