

S.S. N° 395

DIMENSIONS: LENGTH B.P. 124'0" BREADTH MLD 21'0" DEPTH MLD UPPER D<sup>K</sup> 9'9"  
RAISED QUARTER D<sup>K</sup> 12'10"

CLASS BRITISH CORPORATION B.S.

SCALE 1/4 INCH = 1 FOOT

14 MAY 1928


aw

Approved  
15.5.28

126-0  
5-6  
102-5

PLAN OF STIFFENING AT

FORE END WILL BE SUBMITTED

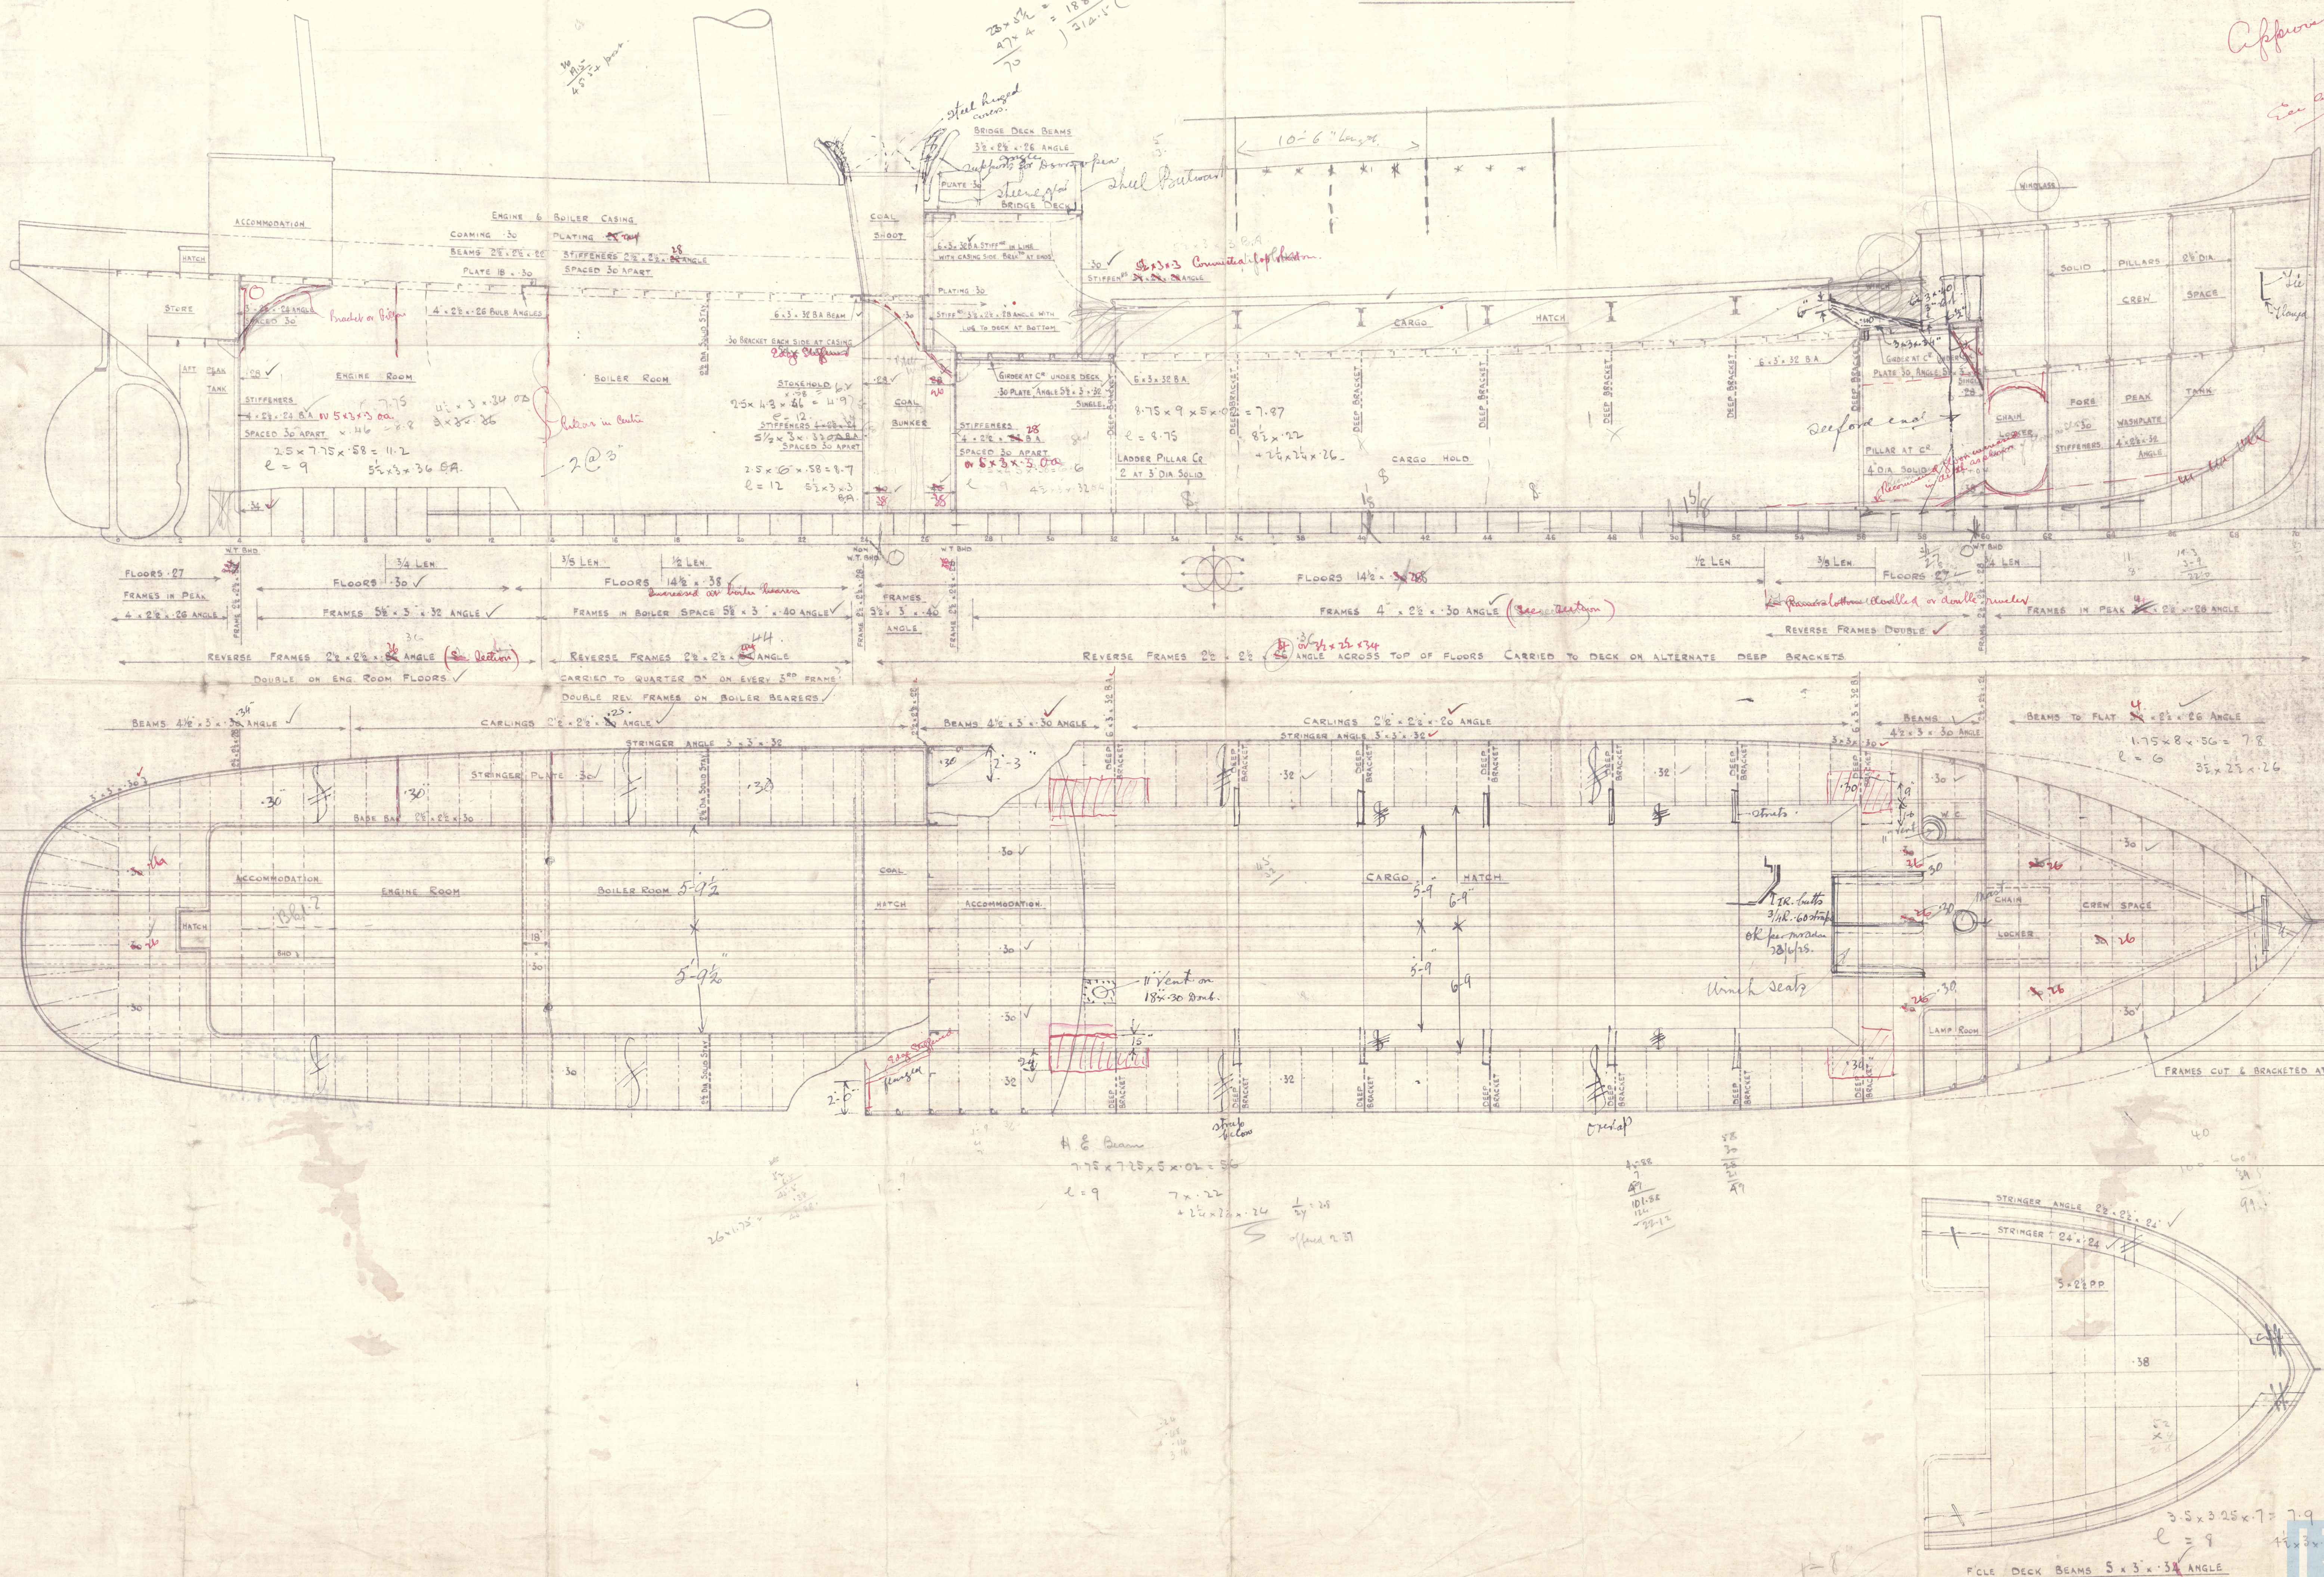



2  
Aulsa S. B. Co.

395-

Profile & dhs

RETAIN

Bag

M/M. 2023

T.C. 20/5/23-  
N/N "BALLYALTON"

3/5. <sup>EX</sup> "Stramore"

Stramore  
Belfast

Aulsa S. Co.

395-

Profile & dhs.

15.5.28

178

2.



© 2020

Lloyd's Register  
Foundation